





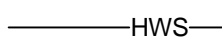



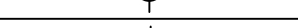
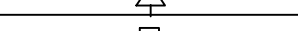
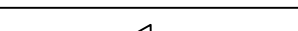


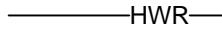

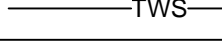


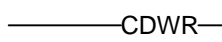


 



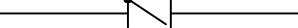







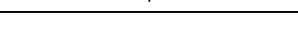





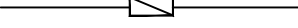



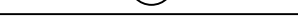
 


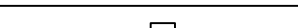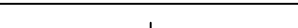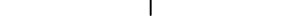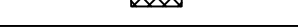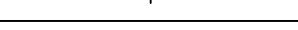
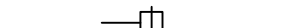
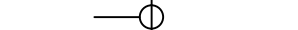

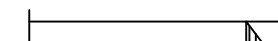

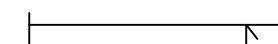

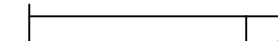

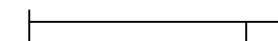

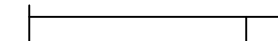

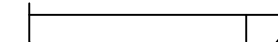

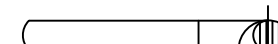

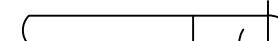

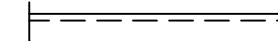
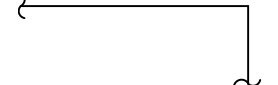
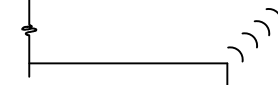
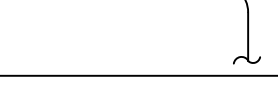
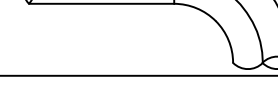
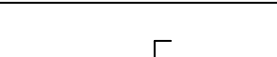

 
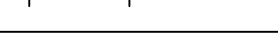
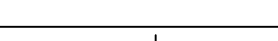
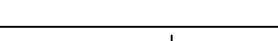
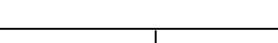
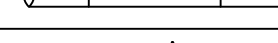
 
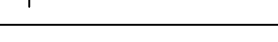
 
 
 
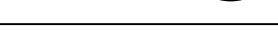
 
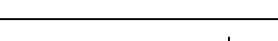
 
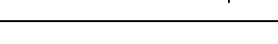
 
 
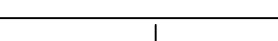
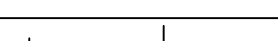
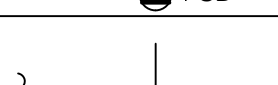

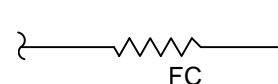
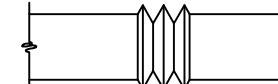
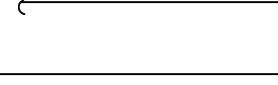
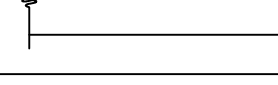
 
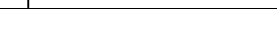
 


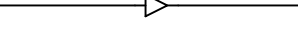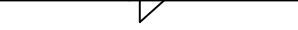

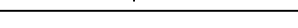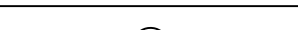
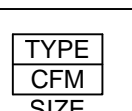
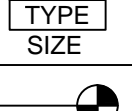


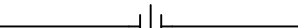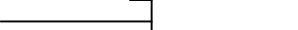
SYMBOL LEGEND			
SYMBOL		DESCRIPTION	
HVAC PIPING			
	HWS	HOT WATER SUPPLY	
	HWR	HOT WATER RETURN	
	TWS	TEMPERED WATER SUPPLY	
	CWS	CHILLED WATER SUPPLY	
	CWR	CHILLED WATER RETURN	
	RL	REFRIGERANT LIQUID	
	RS	REFRIGERANT SUCTION	
	CDWS	CONDENSER WATER SUPPLY	
	CDWR	CONDENSER WATER RETURN	
	D	DRAIN LINE	
	(E)	EXISTING PIPE	
	EXISTING PIPE TO BE REMOVED		
ABBREVIATIONS			
NOTE: ALL ABBREVIATIONS MAY NOT BE USED			
AD AIR COND APD BD BHP BTU BTU/H CFH CFM CLG COMP COND CV CW DIA DISCH DP DB (E) EER EFF EG ELEC ELEV ENT EVAP EWT EXT (F) FC FD FLA FPI FPM FPS FSD FT GAL GPH GPM HG HR HT HTG HP HW HZ ID IN KW LAT LBS LG LH LRA LVG LWT MBH	ACCESS DOOR AIR CONDITION(-ING,-ED) AIR PRESSURE DROP BALANCING DAMPER BRAKE HORSE POWER BRITISH THERMAL UNIT BTU/HOUR CUBIC FEET PER HOUR CUBIC FEET PER MINUTE COOLING COMPONENT CONDENS(-ER,-ING,-ATION) CONTROL VALVE COLD WATER DIAMETER DISCHARGE DEPTH OR DEEP DRY BULB TEMPERATURE (E) EXISTING EER ENERGY EFFICIENCY RATIO EFF EFFICIENCY EG ETHYLENE GLYCOL ELEC ELECTRIC ELEV ELEVATION ENT ENTERING EVAP EVAPORAT(-E,-ING,-ED,-OR) EWT ENTERING WATER TEMP EXT EXTERNAL (F) FUTURE FC FAHRENHEIT FD FLEXIBLE CONNECTION FD FIRE DAMPER FLA FULL LOAD AMPS FPI FINS PER INCH FPM FEET PER MINUTE FPS FEET PER SECOND FSD FIRE SMOKE DAMPER FT FEET GAL GALLON(S) GPH GALLONS PER HOUR GPM GALLONS PER MINUTE HG HEAD HR MERCURY HR HOUR HT HEIGHT HTG HEATING HP HORSE POWER HW HOT WATER HZ HERTZ(FREQUENCY) ID INSIDE DIAMETER IN INCH KW KILOWATT LAT LEAVING AIR TEMPERATURE LBS POUNDS LG LENGTH LH LATENT HEAT LRA LOCKED ROTOR AMPS LVG LEAVING LWT LEAVING WATER TEMP MBH THOUSAND BTU PER HOUR	MCA MFR MIN N/A NC NC NC NO NPSH NTS OA OD OZ PD PG PH PPM PRESS PSF PSI PSIA PSIG R RA RECIRC REFR REQD RPM RW SA SC SCW SF SH SL SP SPEC(S) SQ STD TEMP TSTAT V VAC VAV VEL VENT VFD WG WPD WB	MINIMUM CIRCUIT AMPS MANUFACTURER MINIMUM NOT APPLICABLE NORMALLY CLOSED NOISE CRITERIA NOT IN CONTRACT NORMALLY OPEN NET POSITIVE SUCTION HEAD NOT TO SCALE OUTSIDE AIR OUTSIDE DIAMETER OUNCE PRESSURE DROP OR DIFF. PROPYLENE GLYCOL PHASE PARTS PER MILLION PRESSURE POUNDS PER SQUARE FOOT POUNDS PER SQUARE INCH PSI ABSOLUTE PSI GAUGE R THERMAL RESISTANCE RA RETURN AIR RECIRCULATE REFRIGERATION REQUIRED REVOLUTIONS PER MINUTE RAINWATER SA SUPPLY AIR SHADING COEFFICIENT SOFT COLD WATER SAFETY FACTOR SENSIBLE HEAT SEA LEVEL STATIC PRESSURE SPECIFICATION(S) SQUARE STANDARD TEMPERATURE THERMOSTAT V VOLT VAC VACUUM VAV VARIABLE AIR VOLUME VEL VELOCITY VENT VENT, VENTILATION VFD VARIABLE FREQUENCY DRIVE WG WATER COLUMN WPD WATER GAUGE WPD WATER PRESSURE DROP WB WET BULB
DEFINITIONS			
NOTE: ALL DEFINITIONS MAY NOT BE USED.			
INDICATED: THE TERM "INDICATED" REFERS TO GRAPHIC REPRESENTATIONS, NOTES, OR SCHEDULES ON THE DRAWINGS. OTHER PARAGRAPHS OR SCHEDULES IN THE SPECIFICATIONS, AND SIMILAR REQUIREMENTS IN THE CONTRACT DOCUMENTS, WHERE TERMS SUCH AS "SHOWN", "NOTED", "SCHEDULED", AND "SPECIFIED" ARE USED, IT IS TO HELP THE READER LOCATE THE REFERENCE, NO LIMITATION ON LOCATION IS INTENDED.			
DIRECTED: TERMS SUCH AS "DIRECTED", "REQUESTED", "AUTHORIZED", "SELECTED", "APPROVED", "REQUIRED", AND "PERMITTED" MEAN "DIRECTED BY THE ENGINEER", "REQUESTED BY THE ENGINEER", AND SIMILAR PHRASES.			
APPROVE: THE TERM "APPROVED", WHERE USED IN CONJUNCTION WITH THE ENGINEER'S ACTION ON THE CONTRACTOR'S SUBMITTALS, APPLICATIONS, AND REQUESTS, IS LIMITED TO THE ENGINEER'S DUTIES AND RESPONSIBILITIES AS STATED IN GENERAL AND SUPPLEMENTARY CONDITIONS.			
FURNISH: THE TERM "FURNISH" IS USED TO MEAN "SUPPLY AND DELIVER TO THE PROJECT SITE, READY FOR UNLOADING, UNPACKING, ASSEMBLY, INSTALLATION, AND SIMILAR OPERATIONS."			
INSTALL: THE TERM "INSTALL" IS USED TO DESCRIBE OPERATIONS AT PROJECT SITE INCLUDING THE ACTUAL "UNLOADING, UNPACKING, ASSEMBLY, ERECTION, PLACING, ANCHORING, APPLYING, WORKING TO DIMENSIONS, FINISHING, CURING, PROTECTING, CLEANING, AND SIMILAR OPERATIONS TO MAKE THE ITEM FULLY OPERATIONAL."			
PROVIDE: THE TERM "PROVIDE" MEANS "TO FURNISH AND INSTALL, COMPLETE AND READY FOR THE INTENDED USE."			
INSTALLER: AN "INSTALLER" IS THE CONTRACTOR OR AN ENTITY ENGAGED BY THE CONTRACTOR, EITHER AS AN EMPLOYEE, SUBCONTRACTOR, OR SUB-SUBCONTRACTOR, FOR PERFORMANCE OF A PARTICULAR CONSTRUCTION ACTIVITY, INCLUDING INSTALLATION, ERECTION, APPLICATION, AND SIMILAR OPERATIONS. INSTALLERS ARE REQUIRED TO BE EXPERIENCED IN THE OPERATIONS THEY ARE ENGAGED TO PERFORM.			

SYMBOL LEGEND	
SYMBOL	DESCRIPTION
VALVES, METERS, AND GAUGES	
	SHUT OFF VALVE
	GATE VALVE
	CHECK VALVE
	AUTO 2-WAY VALVE
	AUTO 3-WAY VALVE
	GLOBE VALVE
	BALL VALVE
	RELIEF VALVE
	CHAIN OPERATED GATE VALVE
	PRESSURE REDUCING VALVE
	BUTTERFLY VALVE
	SOLENOID VALVE
	ANGLE VALVE
	VENTURI
	BALANCING OR PLUG COCK
	FLOW SETTER
	EXPANSION VALVE (REFRIG.)
	TEMPERATURE SENSOR
	MANUAL AIR VENT
	STRAINER
	GAUGE COCK
	FLEXIBLE CONNECTION
	PRESSURE GAUGE
	THERMOMETER
	VICTAULIC COUPLING
	REDUCER CONCENTRIC
	REDUCER ECCENTRIC
	REFRIGERANT SITE GLASS
	REFRIGERANT STRAINER
	REFRIGERANT FILTER DRIER
	90° ELBOW UP
	90° ELBOW DOWN
	90° TEE UP
	90° TEE DOWN
	UNION
	CAPPED PIPE
	ANCHOR
	FLOAT AND THERMOSTATIC TRAP
HVAC SYMBOLS	
	THERMOSTAT
	TEMPERATURE SENSOR
	HUMIDISTAT
PLUMBING SYMBOLS	
	C.B.
	M.H.
	W.H.
	H.B.
	CLEANOUT TO GRADE
	FLOOR CLEANOUT
	WALL CLEANOUT

SYMBOL LEGEND		
SYMBOL	DESCRIPTION	
DUCTWORK		
SINGLE LINE	DOUBLE LINE	DESCRIPTION
		RECTANGULAR SUPPLY DUCT UP
		RECTANGULAR SUPPLY DUCT DOWN
		RECTANGULAR RETURN DUCT UP
		RECTANGULAR RETURN DUCT DOWN
		RECTANGULAR EXHAUST DUCT UP
		RECTANGULAR EXHAUST DUCT DOWN
		ROUND DUCT UP
		ROUND DUCT DOWN
		ACOUSTICALLY LINED RECTANGULAR DUCT
		90° RECTANGULAR ELBOW WITH TURNING VANES
		90° RADIUS ELBOW R=1.5
		DUCT SIZE OR SHAPE TRANSITION
		OPPOSED BLADE BALANCING DAMPER (O.B.D.) IN RECT DUCT
		BUTTERFLY BALANCING DAMPER IN ROUND DUCTS
		COMBINATION TEE
		SPLITTER DAMPER
		SQUARE OR RECTANGULAR CEILING DIFFUSER
		ROUND CEILING DIFFUSER
		SIDEWALL REGISTER SUPPLY OR RETURN
		ROUND FLEXIBLE DUCT
		RETURN GRILLE
		EXHAUST GRILLE
		FIRE/SMOKE DAMPER
		FIRE DAMPER
		FLEXIBLE CONNECTION
		EXISTING DUCT
		DUCT TO BE REMOVED

GENERAL MECHANICAL NOTES	
<div>1.  ALL CEILING DIFFUSERS SHOWN AS SUCH ARE CD-1, CFM AS NOTED, UNLESS OTHERWISE NOTED.</div> <div>2.  ALL CEILING RETURN GRILLES SHOWN AS SUCH ARE RG-1 UNLESS OTHERWISE NOTED. PROVIDE SOUND BOOT</div> <div>3.  ALL CEILING EXHAUST GRILLES SHOWN AS SUCH ARE EG-1, CFM AS NOTED, UNLESS OTHERWISE NOTED.</div> <div>4. DO NOT ROUTE DUCTS AND PIPES ABOVE ELECTRICAL PANELS. ALL ELECTRICAL PANELS MUST HAVE CLEAR ACCESS SPACE IN FRONT OF PANEL 4'-0" DEEP AND 6'-6" HIGH. DO NOT ROUTE DUCTS AND PIPES IN ELECTRICAL ROOMS, EXCEPT DUCTS AND PIPES SERVING THE ROOM OR WITHIN APPROPRIATE ENCLOSURE.</div> <div>5. COORDINATE EXACT LOCATIONS OF CEILING DIFFUSERS AND GRILLES WITH ARCHITECTURAL REFLECTED CEILING PLANS.</div> <div>6. ALL DUCT DIMENSIONS ARE INSIDE FREE AREA DIMENSIONS. ADJUST SHEET METAL DIMENSION FOR LINED DUCT.</div> <div>7. ALL FIRE DAMPERS SHOWN ARE 1-1/2 HOUR UNLESS OTHERWISE NOTED.</div> <div>8. IF CONTRACTOR ENCOUNTERS MATERIAL WHICH MAY CONTAIN ASBESTOS IMMEDIATELY STOP WORK IN THIS AREA AND NOTIFY THE OWNER.</div> <div>9. PROVIDE CEILING ACCESS PANELS AS REQUIRED WHERE MECHANICAL EQUIPMENT, VALVES, HEAT PUMPS, FIRE DAMPERS, ETC. ARE LOCATED ABOVE INACCESSIBLE CEILINGS. ACCESS PANELS TO BE LISTED AND FIRE RATED EQUAL TO OR GREATER THAN THE RATING OF THE ASSEMBLY THEY ARE INSTALLED IN.</div> <div>10. ALL DUCT AND FLUE PENETRATIONS THRU 1 HOUR ROOF ASSEMBLY TO BE ENCLOSED WITH 2 SHEET ROCK LAYERS FROM SHEET ROCK AT BOTTOM OF ROOF TRUSSES TO ROOF DECK.</div> <div>11. STEEL ROOF DECK SHALL NOT BE USED TO SUPPORT LOADS FROM PIPING, DUCTWORK OR EQUIPMENT, UNLESS NOTED OTHERWISE. HANGER LOADS LESS THAN 50 LBS. MAY BE HUNG FROM THE STEEL ROOF DECK IN CASES WHEN HANGING FROM THE STEEL ROOF DECK CANNOT BE AVOIDED; THE ATTACHMENT METHOD MUST DISTRIBUTE THE LOAD ACROSS THE DECK AS APPROVED BY THE STRUCTURAL ENGINEER.</div> <div>12. THE EQUIPMENT INSTALLER IS TO APPLY AND SIGN A CERTIFICATION LABEL TO EACH GAS-FIRED APPLIANCE, STATING THE APPLIANCE HAS BEEN ADJUSTED OR MODIFIED PER MANUFACTURER'S REQUIREMENTS FOR OPERATION AT THE PROJECT ALTITUDE AND WITH THE BTU-CONTENT OF THE AVAILABLE FUEL-GAS.</div>	
SYMBOL LEGEND	
SYMBOL	DESCRIPTION
REFERENCE AND LINE SYMBOLS	
	DETAIL INDICATOR: # INDICATES DETAIL NUMBER, SHEET INDICATES DRAWING SHEET WHERE DETAIL IS SHOWN.
	ELEVATION OR SECTION INDICATOR, EXTERIOR: # INDICATES ELEVATION OR SECTION NUMBER, SHEET INDICATES DRAWING SHEET WHERE ELEVATION OR SECTION IS SHOWN.
	ELEVATION OR SECTION INDICATOR, INTERIOR: # INDICATES ELEVATION OR SECTION NUMBER, SHEET INDICATES DRAWING SHEET WHERE ELEVATION OR SECTION IS SHOWN.
	DIFFUSER/GRILLE INDICATOR.
	DIFFUSER/GRILLE INDICATOR.
	NEW CONNECTION POINT TO EXISTING
MECHANICAL SCOPE OF WORK	
NEW CONSTRUCTION NOTES:	
ELECTRIC UNIT HEATERS WILL BE PLACED WATER ENTRY ROOMS AND MAIN BUILDING ENTRY LOCATIONS.	
ROOFTOP UNITS ARE TO BE INSTALLED WITHIN EXISTING EQUIPMENT WELLS ON ROOF OF EACH BUILDING. SUPPLY AND RETURN DUCTWORK IS TO ROUTE THROUGH EXISTING TRUSS SYSTEM. TERMINAL SUPPLY AND RETURN GRILLES ARE TO INCORPORATE INTEGRAL BALANCING DAMPERS.	
CLOTHES DRYER AND BATHROOM EXHAUST DUCTWORK IS TO TERMINATE AT UNDERSIDE OF EXISTING BUILDING OVERHANGS.	
THE NEW SYSTEM COMPONENTS WILL ALLOW FOR FUTURE OFFICE & TEMPORARY RESIDENT SPACES.	

MECH/PLUMB SHEET INDEX	
SHEET NO	SHEET TITLE
M01	MECHANICAL GENERAL NOTES & LEGEND
M02	MECHANICAL EQUIPMENT SPECIFICATIONS
M11	MECHANICAL SCHEDULES
M12	MECHANICAL DETAILS
M13	MECHANICAL DETAILS
P01	PLUMBING GENERAL NOTES & LEGEND
P02	PLUMBING EQUIPMENT SPECIFICATIONS
P11	PLUMBING SCHEDULES
P12	PLUMBING DETAILS
P13	PLUMBING DETAILS
MP1C	MECH/PLUMB ROOF PLAN - BUILDING 'C'
M1C	MECHANICAL PLAN - BUILDING 'C'
P1C	PLUMBING PLAN - BUILDING 'C'

Donald L. Welch
Architect
7533 Sandy Land Lane
Midvale, Utah 84047
801.548-6391
dwelch5977@msn.com


SPECTRUM
ENGINEERS
324 S. State St., Suite 400
Salt Lake City, UT 84111
800-678-7077
801-328-5151
fax: 801-328-5155
www.spectrum-engineers.com

THE DESIGNS SHOWN AND DESCRIBED HEREIN INCLUDING ALL TECHNICAL DRAWINGS, GRAPHIC REPRESENTATION & MODELS THEREOF, ARE PROPRIETARY & CAN NOT BE COPIED, DUPLICATED, OR COMMERCIALY EXPLOITED IN WHOLE OR IN PART WITHOUT THE SOLE AND EXPRESS WRITTEN PERMISSION FROM DONALD L. WELCH ARCHITECT

THESE DRAWINGS ARE AVAILABLE FOR LIMITED REVIEW AND EVALUATION BY CLIENTS, CONSULTANTS, CONTRACTORS, GOVERNMENT AGENCIES, VENDORS, AND OFFICE PERSONNEL ONLY IN ACCORDANCE WITH THIS NOTICE.

consultant:


project:
Tenant Finish
for New
Brighton
Recovery
Campus
4905, 4911, 4915,
4925, 4931, & 4953
South 900 East
Salt Lake County,
Utah

date
April 11, 2017

revisions
PERMIT SET--December 28, 2016
ADDENDUM #1--January 04, 2017
ADDENDUM #3--January 11, 2017
ADDENDUM #4--January 17, 2017
ADDENDUM #5--January 20, 2017
ADDENDUM #7--February 24, 2017
ADDENDUM #8 - March 20, 2017
ADDENDUM #9 - April 11, 2017

data
project no:
drawn by:
checked by:
title
MECHANICAL
GENERAL NOTES
& LEGEND
sheet

M01
BUILDING 'C'

Building 'C' 4905 South 900 East Parcel # 220818500800000

GENERAL MECHANICAL NOTES		GENERAL MECHANICAL NOTES		MECH. PIPING GENERAL NOTES		PENETRATION FIRESTOPPING NOTES		MECHANICAL SPECIFICATIONS		MECHANICAL SPECIFICATIONS																																			
<p>1. THESE DRAWINGS AND SPECIFICATIONS ARE FOR THE DIVISION 23 CONTRACTOR TO ENGINEER, DESIGN, BID AND INSTALL A HEATING, AIR CONDITIONING AND VENTILATION SYSTEM PER THE DESIGN INTENT SHOWN.</p> <p>2. ALL EQUIPMENT, PIPING, DUCTWORK, COMPONENT AND ACCESSORY SIZES, CAPACITIES, AND TYPES SHOWN IN THESE DRAWINGS AND SPECIFICATIONS SHALL BE ADHERED TO.</p> <p>3. THE DIVISION 23 CONTRACTOR SHALL DESIGN AND INSTALL A COMPLETE AND FULLY OPERATIONAL SYSTEM.</p> <p>4. DESIGN AND AS-BUILT DRAWINGS SHOWING ALL EQUIPMENT, COMPONENTS, PIPING, AND CONTROLS SHALL BE PREPARED TO THE SAME SCALE AS THESE DRAWINGS. COPIES SHALL BE PROVIDED TO THE OWNER AND ARCHITECT/ENGINEER.</p> <p>5. PROVIDE ALL LABOR, MATERIALS, AND EQUIPMENT NECESSARY TO CONSTRUCT A COMPLETE, OPERATIONAL HVAC SYSTEM FOR THE ENTIRE PROJECT AS SHOWN ON THESE DRAWINGS, INCLUDING ALL NECESSARY FEES AND PERMITS.</p> <p>6. THE ENTIRE INSTALLATION SHALL CONFORM TO THE REQUIREMENTS OF THE MOST RECENTLY ADOPTED BUILDING CODE, MECHANICAL CODE, PLUMBING CODE, ELECTRICAL CODE, AND ALL OTHER APPLICABLE CITY, COUNTY, SCHOOL, DISTRICT, STATE, AND FEDERAL CODES AND REGULATIONS IN EFFECT AT THE DATE OF THE BID. CONFORM TO ANY CODES, RULES, REGULATIONS AND REQUIREMENTS THAT THE PROJECT OWNER HAS.</p> <p>7. PRIOR TO FABRICATION AND INSTALLATION, COORDINATE THE INSTALLATION OF ALL HVAC PIPING, DUCTWORK, AND EQUIPMENT WITH PLUMBING PIPING, PLUMBING EQUIPMENT, REFRIGERATION TRENCHES AND PIPING, FIRE PROTECTION PIPING AND ALL OTHER TRADES INCLUDING BUT NOT LIMITED TO: THE MECHANICAL CONTRACTOR, REFRIGERATION CONTRACTOR, ELECTRICAL CONTRACTOR, FIRE PROTECTION CONTRACTOR, GENERAL CONTRACTOR, AND ANY CONTRACTOR HIRED DIRECTLY BY THE OWNER. WHERE CONFLICTS MAY OCCUR, THEY SHALL BE RESOLVED PRIOR TO INSTALLATION.</p> <p>8. THE DRAWINGS SHOW THE GENERAL DESIGN, ARRANGEMENTS AND THE EXTENT OF THE SYSTEM. IT SHALL BE THE WORK OF THE CONTRACTOR TO MAKE SUCH SLIGHT ALTERATIONS AS MAY BE NECESSARY TO MAKE THE SYSTEM COMPLETE AND OPERATIONAL IN ACCORDANCE WITH THE DESIGN INTENT. MAJOR DEVIATIONS SUCH AS CHANGES IN COMPONENT SIZES, WEIGHTS, QUANTITIES, OR MATERIAL REQUIRE PRIOR APPROVAL BY THE CONSULTING ENGINEER.</p> <p>9. ALL HVAC INFORMATION IS NOT SHOWN ON THE HVAC DRAWINGS. THE CONTRACTOR SHALL BE RESPONSIBLE FOR COORDINATING INFORMATION ON ALL OTHER CONSTRUCTION DOCUMENTS INCLUDING ARCHITECTURAL, STRUCTURAL, MECHANICAL, PLUMBING, AND ELECTRICAL DRAWINGS.</p> <p>10. THE WORKING DRAWINGS ARE DIAGRAMMATIC. BECAUSE OF THE SMALL SCALE OF THE DRAWINGS, THEY DO NOT SHOW EVERY OFFSET, BEND OR ELBOW NECESSARY FOR THE COMPLETE INSTALLATION IN THE SPACE PROVIDED. ALL LOCATIONS FOR HVAC EQUIPMENT AND PIPING SHALL BE CHECKED AND COORDINATED WITH THE ARCHITECTURAL, MECHANICAL, STRUCTURAL AND ELECTRICAL DRAWINGS.</p> <p>11. SPACE ABOVE ALL CEILINGS IS LIMITED. CAREFUL COORDINATION IS REQUIRED WITH ALL TRADES BEFORE ANY PIPE, DUCT, OR EQUIPMENT IS ORDERED AND/OR INSTALLED. ANY CONFLICTS AND/OR CHANGES FOUND DURING INSTALLATION, THAT RESULT FROM LACK OF COORDINATION BY THE CONTRACTORS DURING THE SHOP DRAWING PROCESS ARE THE RESPONSIBILITY OF THE CONTRACTOR.</p> <p>12. 1/8" SCALE SHOP DRAWINGS (SUBMITTED FOR APPROVAL) ARE REQUIRED FOR ALL DUCTWORK AND PIPING SYSTEMS.</p> <p>13. THE DRAWINGS AND SPECIFICATIONS HAVE BEEN PREPARED TO SUPPLEMENT EACH OTHER AND THEY SHALL BE INTERPRETED AS AN INTEGRAL UNIT WITH THE ITEMS SHOWN ON ONE AND NOT THE OTHER BEING FURNISHED AND INSTALLED AS THOUGH SHOWN AND CALLED OUT IN BOTH.</p> <p>14. DETAILS: THE CONTRACTOR IS RESPONSIBLE TO REVIEW AND USE WHERE APPROPRIATE ALL OF THE MECHANICAL DETAILS SHOWN ON THE DRAWINGS. DETAILS MAY OR MAY NOT BE CALLED OUT ON THE DRAWINGS WITH SYMBOLS OR KEYED NOTES. ANY CHANGES RESULTING FROM FAILURE TO INSTALL THE MECHANICAL SYSTEM WITHOUT USING THE INCLUDED DETAILS IS THE RESPONSIBILITY OF THE CONTRACTOR.</p> <p>15. PIPING SCHEMATICS: THE CONTRACTOR IS RESPONSIBLE TO REVIEW THE PIPING SCHEMATICS INCLUDED WITH THE DRAWINGS FOR PIPING CONNECTIONS TO ALL MECHANICAL EQUIPMENT. THE PIPING SCHEMATICS SHOW DETAILED CONNECTIONS INCLUDING NECESSARY VALVES, FITTINGS, PRESSURE AND TEMPERATURE GAUGES, ETC., THAT ARE NOT SHOWN ON THE PIPING PLANS. ANY CHANGES RESULTING FROM FAILURE TO INSTALL THE MECHANICAL SYSTEM WITHOUT USING THE INCLUDED PIPING SCHEMATICS IS THE RESPONSIBILITY OF THE CONTRACTOR.</p> <p>16. THE STRUCTURE SHOWN ON ALL DETAILS MAY OR MAY NOT PERTAIN TO A PORTION OR ANY PORTION OF THE BUILDING. COORDINATE MOUNTING REQUIREMENTS WITH ARCHITECTURAL AND STRUCTURAL DRAWINGS.</p> <p>17. ANY PART OF THIS INSTALLATION THAT FAILS, IS UNFIT, OR BECOMES DAMAGED DURING CONSTRUCTION SHALL BE REPAIRED OR REPLACED BY THE CONTRACTOR AT NO ADDITIONAL COST TO THE OWNER.</p> <p>18. COORDINATE THE RETURN OF ALL MECHANICAL EQUIPMENT REMOVED DURING DEMOLITION WITH THE OWNER'S REPRESENTATIVE.</p> <p>19. ALL EQUIPMENT SHALL PROVIDE THE SCHEDULED PERFORMANCE AT THE SITE ALTITUDE.</p> <p>20. ALL EQUIPMENT SHALL BE INSTALLED IN STRICT ACCORDANCE WITH THE EQUIPMENT MANUFACTURER'S RECOMMENDATIONS. PROVIDE ALL FITTINGS, TRANSITIONS, VALVES, DAMPERS, AND OTHER DEVICES AND ACCESSORIES REQUIRED FOR A COMPLETE, WORKABLE INSTALLATION.</p> <p>21. THE DIVISION 23 CONTRACTOR SHALL FURNISH ALL REQUIRED MOTORS. ALL MOTOR STARTING EQUIPMENT, WHEN NOT A PART OF THE EQUIPMENT, WILL BE FURNISHED BY THE ELECTRICAL CONTRACTOR.</p> <p>22. EXISTING INTERIOR PIPING, EQUIPMENT, AND DUCTWORK HAS BEEN LOCATED IN AN APPROXIMATE WAY ONLY. THE CONTRACTOR SHALL VERIFY LOCATIONS AND POINTS OF CONNECTION AND PIPE ROUTING THROUGH EXISTING CONDITIONS PRIOR TO COMMENCING WORK. THE CONTRACTOR SHALL PERFORM THE WORK IN A MANNER THAT WILL CAUSE A MINIMUM DISRUPTION TO BUILDING TENANT USE AND SHALL COORDINATE THE WORK WITH THE BUILDING OWNER'S REPRESENTATIVE.</p> <p>23. THE CONTRACTOR IS RESPONSIBLE FOR HVAC EQUIPMENT CHECK-IN, SAFEKEEPING, AND DAMAGE.</p> <p>24. DO NOT ROUTE DUCTS AND PIPES ABOVE ELECTRICAL PANELS. ALL ELECTRICAL PANELS MUST HAVE CLEAR ACCESS SPACE IN FRONT OF PANEL 4'-0" DEEP AND 6'-6" HIGH. DO NOT ROUTE DUCTS AND PIPES IN ELECTRICAL ROOMS, EXCEPT DUCTS AND PIPES SERVING THE ROOM OR IF PROPER ENCLOSURE IS PROVIDED.</p> <p>25. COORDINATE EXACT LOCATIONS OF CEILING DIFFUSERS AND GRILLES WITH ARCHITECTURAL REFLECTED CEILING PLAN.</p> <p>26. ALL FIRE DAMPERS SHOWN ARE 1-1/2 HOUR UNLESS OTHERWISE NOTED.</p> <p>27. IF CONTRACTOR ENCOUNTERS MATERIAL WHICH MAY CONTAIN ASBESTOS, IMMEDIATELY STOP WORK IN THIS AREA AND NOTIFY THE OWNER.</p> <p>28. PROVIDE CEILING ACCESS PANELS AS REQUIRED WHERE MECHANICAL EQUIPMENT, VALVES, VAV BOXES, FIRE DAMPERS, ETC. ARE LOCATED ABOVE INACCESSIBLE CEILINGS.</p> <p>29. ENCLOSE ALL DUCT AND FLUE PENETRATIONS THROUGH 1 HOUR ROOF ASSEMBLIES WITH 2 SHEET ROCK LAYERS FROM SHEET ROCK CEILING AT BOTTOM OF ROOF TRUSSES TO ROOF DECK.</p> <p>30. DO NOT USE STEEL ROOF DECK TO SUPPORT LOADS FROM PIPING, DUCTWORK OR EQUIPMENT. HANGER LOADS LESS THAN 50 LBS. MAY BE HUNG FROM THE STEEL ROOF DECK IN CASES WHERE HANGING FROM THE STEEL ROOF DECK CANNOT BE AVOIDED. THE ATTACHMENT METHOD MUST DISTRIBUTE THE LOAD ACROSS THE DECK AS APPROVED BY THE STRUCTURAL ENGINEER.</p>		<p>31. PROPERLY LUBRICATE ALL PIECES OF EQUIPMENT BEFORE TURNING THE SYSTEM OVER TO THE OWNER.</p> <p>32. PREPARE SUBMITTALS IN AN INDEXED, LABELED FOLDER CONTAINING FULL PERFORMANCE, MATERIAL AND INSTALLATION INFORMATION ABOUT ALL EQUIPMENT, PIPING, COMPONENTS AND ACCESSORIES TO BE USED. SUBMITTALS WILL BE CHECKED AT MOST TWICE. TIME SPENT ON SUBSEQUENT SUBMITTALS WILL BE BILLED TO THE CONTRACTOR BY THE ENGINEER AT ITS CURRENT HOURLY RATES.</p> <p>33. TWO OPERATING AND MAINTENANCE MANUALS SHALL BE PROVIDED IN HARD BACK LOOSE LEAF BINDERS. MANUALS SHALL CONTAIN PRODUCT CUT SHEETS AND OPERATING AND MAINTENANCE INSTRUCTIONS ON ALL EQUIPMENT, ACCESSORIES, FIXTURES, VALVES, ETC., PROVIDED FOR THE PROJECT.</p> <p>34. UPON COMPLETION OF THE WORK, REMOVE ALL SURPLUS MATERIALS AND RUBBISH. MAKE ALL REQUIRED PATCHING AND REPAIRS OF OTHER TRADES' WORK DAMAGED BY THE CONTRACTOR, AND LEAVE THE PREMISES IN A CLEAN, ORDERLY CONDITION.</p> <p>35. THE CONTRACTOR SHALL OPERATE THE SYSTEM AND DEMONSTRATE ALL ASPECTS TO THE ENGINEER AND/OR OWNER, TO PROVE ITS OPERATION. ALL FILTERS USED DURING CONSTRUCTION SHALL BE REPLACED PRIOR TO THE TEST RUN PERIOD.</p> <p>36. THE CONTRACTOR SHALL GUARANTEE THE HVAC SYSTEM FOR A PERIOD OF ONE YEAR FROM THE DATE OF SUBSTANTIAL COMPLETION.</p> <p>37. THE CONTRACTOR SHALL, DURING CONSTRUCTION, MAINTAIN A SET OF AS-BUILT REDLINED RECORD DRAWINGS AT THE PROJECT SITE. ALL CHANGES IN LAYOUT, ROUTING, EQUIPMENT, COMPONENTS, AND ACCESSORIES SHALL BE RECORDED. THESE REDLINES SHALL BE GIVEN TO THE ARCHITECT/ENGINEER AFTER THE FINAL INSPECTION</p>		<p>1. CAULK AROUND ALL PIPING THAT PASSES THROUGH FIRE RATED PARTITIONS WITH A NON-HARDENING CAULKING SIMILAR TO 3M "FIRE BARRIER".</p> <p>2. PROVIDE PROPER PROVISIONS FOR EXPANSION OR MOVEMENT OF ALL PIPING.</p> <p>3. PROVIDE LARGE ENOUGH PIPE SLEEVES THROUGH WALLS OR FLOORS TO ALLOW FOR ANTICIPATED DIFFERENTIAL MOVEMENTS.</p> <p>4. AT VERTICAL RISERS SUPPORT THE WEIGHT OF THE RISER AT A POINT OR POINTS ABOVE THE CENTER OF GRAVITY OF THE RISER. PROVIDE LATERAL GUIDES AT THE TOP AND BOTTOM OF THE RISER, AND AT THE INTERMEDIATE POINTS NOT TO EXCEED 30'-0" ON CENTER.</p> <p>5. ALL PIPING SHALL BE SUPPORTED WITH TYPE I STEEL CLEVIS PIPE HANGERS.</p> <p>6. ALL STEEL CLEVIS HANGERS USED TO SUPPORT PLASTIC PIPING SHALL BE PLASTIC COATED.</p> <p>7. ALL STEEL HANGERS USED TO SUPPORT COPPER PIPING SHALL BE COPPER PLATED OR PLASTIC COATED.</p> <p>8. PERFORATED METAL OR PLASTIC STRAPPING (PLUMBERS TAPE) IS NOT AN ACCEPTABLE MATERIAL FOR HANGING OR SECURING PIPE.</p> <p>9. PROVIDE PIPE HANGERS WITHIN 18 INCHES OF ALL 90 DEGREE ELBOWS.</p> <p>10. PROVIDE SWAY BRACING ON PIPING 4" AND LARGER AT CHANGES IN DIRECTION GREATER THAN 45 DEGREES.</p> <p>11. ALL PIPING SHALL BE INSTALLED IN A NEAT ARRANGEMENT PARALLEL TO BUILDING STRUCTURE.</p>		<p>1. FIRE RATED PENETRATIONS DETAILS SHOWN ON THE CONSTRUCTIONS DOCUMENTS SHOW GENERAL METHOD OF MECHANICAL (HVAC) AND PLUMBING PENETRATION FIRESTOPPING.</p> <p>2. CONTRACTOR SHALL REVIEW CONSTRUCTION DOCUMENTS AND PROVIDE SPECIFIC FIRESTOPPING DETAILS FROM A SPECIFIC FIRESTOPPING MANUFACTURER FOR EACH MECHANICAL (HVAC) AND PLUMBING PIPE OR DUCT PENETRATION FOR EACH FIRE RATED ASSEMBLY.</p> <p>3. PROVIDE PENETRATION FIRESTOPPING THAT IS PRODUCED AND INSTALLED TO RESIST SPREAD OF FIRE ACCORDING TO REQUIREMENTS INDICATED, RESIST PASSAGE OF SMOKE AND OTHER GASES, AND MAINTAIN ORIGINAL FIRE-RESISTANCE RATING OF CONSTRUCTION PENETRATED.</p> <p>4. PENETRATION FIRESTOPPING SYSTEMS SHALL BE COMPATIBLE WITH ONE ANOTHER, WITH THE SUBSTRATES FORMING OPENINGS, AND WITH PENETRATING ITEMS IF ANY.</p> <p>5. PENETRATIONS IN FIRE-RESISTANCE-RATED WALLS: PROVIDE PENETRATION FIRESTOPPING WITH RATINGS DETERMINED PER ASTM E 814 OR UL 1479, BASED ON TESTING AT A POSITIVE PRESSURE DIFFERENTIAL OF 0.01-INCH WG</p> <p>6. PENETRATION FIRESTOPPING PRODUCTS SHALL BEAR UL, ETL OR FM GLOBAL CLASSIFICATION MARKING OF QUALIFIED TESTING AND INSPECTING AGENCY.</p> <p>7. DO NOT INSTALL PENETRATION FIRESTOPPING WHEN AMBIENT OR SUBSTRATE TEMPERATURES ARE OUTSIDE LIMITS PERMITTED BY PENETRATION FIRESTOPPING MANUFACTURERS OR WHEN SUBSTRATES ARE WET BECAUSE OF RAIN, FROST, CONDENSATION, OR OTHER CAUSES.</p> <p>8. COORDINATE CONSTRUCTION OF OPENINGS AND PENETRATING ITEMS TO ENSURE THAT PENETRATION FIRESTOPPING IS INSTALLED ACCORDING TO SPECIFIED REQUIREMENTS.</p> <p>9. COORDINATE SIZING OF SLEEVES, OPENINGS, CORE-DRILLED HOLES, OR CUT OPENINGS TO ACCOMMODATE PENETRATION FIRESTOPPING.</p> <p>10. INSTALL PENETRATION FIRESTOPPING TO COMPLY WITH MANUFACTURER'S WRITTEN INSTALLATION INSTRUCTIONS AND PUBLISHED DRAWINGS FOR PRODUCTS AND APPLICATIONS INDICATED.</p> <p>11. INSTALL FORMING MATERIALS AND OTHER ACCESSORIES OF TYPES REQUIRED TO SUPPORT FILL MATERIALS DURING THEIR APPLICATION AND IN THE POSITION NEEDED TO PRODUCE CROSS-SECTIONAL SHAPES AND DEPTHS REQUIRED TO ACHIEVE FIRE RATINGS INDICATED.</p> <p>12. IDENTIFY PENETRATION FIRESTOPPING WITH PREPRINTED METAL OR PLASTIC LABELS. ATTACH LABELS PERMANENTLY TO SURFACES ADJACENT TO AND WITHIN 6 INCHES OF FIRESTOPPING EDGE SO LABELS WILL BE VISIBLE TO ANYONE SEEKING TO REMOVE PENETRATING ITEMS OR FIRESTOPPING.</p>		<p>230563 - MECHANICAL IDENTIFICATION</p> <p>1. PIPE MARKERS: PLASTIC TAPE: PROVIDE MANUFACTURER'S STANDARD COLOR-CODED PRESSURE-SENSITIVE (SELF-ADHESIVE) VINYL TAPE, NOT LESS THAN 3 MILS THICK. 1-1/2" WIDE TAPE MARKERS ON PIPES WITH OUTSIDE DIAMETERS LESS THAN 6" (INCLUDING INSULATION, IF ANY); 2-1/2" WIDE TAPE FOR LARGER PIPES.</p> <p>2. DUCT MARKERS: PROVIDE MANUFACTURER'S STANDARD LAMINATED PLASTIC, COLOR CODED DUCT MARKERS.</p> <p>3. COLOR: COMPLY WITH ANSI A13.1</p> <p>4. LETTERING: MANUFACTURER'S STANDARD PRE-PRINTED NOMENCLATURE WHICH BEST DESCRIBES PIPING OR DUCT SYSTEM IN EACH INSTANCE OR AS SELECTED BY ARCHITECT OR ENGINEER IN CASES OF VARIANCE WITH NAMES AS SHOWN.</p> <p>5. ARROWS: PRINT EACH MARKER WITH ARROWS INDICATING DIRECTION OF FLOW.</p> <p>6. VALVE TAGS: PROVIDE PLASTIC LAMINATE VALVE TAGS; MANUFACTURER'S STANDARD 3/32" THICK ENGRAVED TAGS WITH PIPING SYSTEM ABBREVIATION IN 1/4" HIGH LETTERS AND SEQUENCED VALVE NUMBERS 1/2" HIGH WITH 5/32" HOLE FOR FASTENER. PROVIDE 1-1/2" SQUARE BLACK TAGS WITH WHITE LETTERING.</p> <p>7. VALVE TAG FASTENERS: PROVIDE MANUFACTURER'S STANDARD SOLID BRASS CHAIN (WIRE LINK OR BEADED TYPE), OR SOLID BRASS S-HOOKS OF THE SIZED REQUIRED FOR PROPER ATTACHMENT OF TAGS TO VALVES, AND MANUFACTURED SPECIFICALLY FOR THAT PURPOSE.</p> <p>230593 - TESTING, ADJUSTING, AND BALANCING</p> <p>OBTAIN THE SERVICES OF AN INDEPENDENT TESTING AND BALANCING AGENCY TO BALANCE AND ADJUST THE SYSTEM. THIS SHALL BE DONE BY PERSONS FULLY FAMILIAR WITH SYSTEMS OF THIS TYPE. BALANCING SHALL BE DONE IN ACCORDANCE TO AABC OR NEBB STANDARDS. ALL DATA SHALL BE RECORDED AND A REPORT SUBMITTED TO THE ENGINEER PRIOR TO JOB CLOSE-OUT.</p> <p>230700 - MECHANICAL INSULATION</p> <p>1. PIPE INSULATION TO BE SNAP-ON GLASS FIBER TYPE WITH VAPOR JACKET. SEAL ALL ENDS AND JOINTS TO PROVIDE A COMPLETELY SEALED SYSTEM. ALTERNATIVELY, USE FLEXIBLE UNICELLULAR ASTM 534 TYPE 1 INSULATION. USE 1" THICKNESS FOR PIPE UP TO 2"Ø, AND 1 1/2" FOR PIPE OVER 2"</p> <p>2. WRAP ALL SUPPLY AND RETURN DUCTWORK WITH 1-1/2" THICK FOIL FACED FIBERGLASS INSULATION. WRAP INSULATION TIGHTLY ON THE DUCT WITH ALL CORNER/INTERFURAL JOINTS BUTTED AND LONGITUDINAL JOINTS OVERLAPPED A MIN. OF 2". COVER ALL JOINTS WITH FOIL-REINFORCED KRAFT TAPE, 3" WIDE. DUCTWORK INTERIOR TO BUILDING ENVELOPE WITH A MINIMUM R-5 WHILE EXTERIOR DUCTWORK INSULATION SHALL BE MINIMUM R-12.</p> <p>3. NO RETURN AIR DUCT INSULATION IS REQUIRED IF THE RETURN AIR AND PLENUM TEMPERATURE DIFFERENCE IS LESS THAN 10°F</p> <p>4. OUTDOOR DUCTWORK EXPOSED TO THE WEATHER SHALL HAVE 2" INSULATION AND SHALL BE FITTED WITH 0.016 EMBOSSED ALUMINUM JACKET POP-RIVETED FOR A TIGHT WEATHERPROOF FIT.</p> <p>233113 - METAL DUCTWORK</p> <p>1. ALL DUCTWORK SHALL BE CONSTRUCTED, ERECTED, AND TESTED IN ACCORDANCE WITH THE MOST RESTRICTIVE OF LOCAL REGULATIONS AND PROCEDURES DETAILED IN THE ASHRAE HANDBOOK OF FUNDAMENTALS, OR THE APPLICABLE STANDARDS ADOPTED BY THE SHEET METAL AND AIR CONDITIONING CONTRACTOR'S NATIONAL ASSOCIATION. (SMACNA)</p> <p>2. TRANSITION ALL NEW DUCTWORK TO CONNECT TO EXISTING, AS REQUIRED.</p> <p>3. DUCTWORK SHALL BE GALVANIZED STEEL THROUGHOUT, FABRICATED AND INSTALLED SO THAT NO VIBRATION OR NOISE RESULTS. IT SHALL BE MADE FROM THE BEST GRADE OF GALVANIZED MILLED STEEL SHEETS OF U.S. STANDARD GAUGE AND BE FREE FROM RUSTERS, SLIVERS, AND RITS. ALL SEAMS SHALL BE AIRTIGHT. THE CONSTRUCTION OF ALL DUCTWORK, INCLUDING GAUGES OF METAL, BRACING LAYOUT, ETC., SHALL BE IN ACCORDANCE WITH SMACNA. SLEEVES FOR FIRE DAMPERS AND DUCT SECTIONS FORMING AN EXTENSION OF THE FIRE WALL SHALL BE 10 GAUGE STEEL.</p> <p>4. SEAL DUCTWORK ACCORDING TO THE FOLLOWING SMACNA DUCT SEALING CLASS:</p> <table><tr><th rowspan="2">DUCT LOCATION</th><th colspan="4">DUCT TYPE</th></tr><tr><th colspan="2">SUPPLY</th><th rowspan="2">EXHAUST</th><th rowspan="2">RETURN</th></tr><tr><th></th><th><2in. Wg.</th><th>2-26in. Wg.</th><th></th><th></th></tr><tr><td>OUTDOORS</td><td>A</td><td>A</td><td>A</td><td>A</td></tr><tr><td>UNCONDITIONED SPACES</td><td>B</td><td>A</td><td>B</td><td>B</td></tr><tr><td>CONDITIONED SPACES (CONCEALED DUCTWORK)</td><td>C</td><td>B</td><td>B</td><td>B</td></tr><tr><td>CONDITIONED SPACES (EXPOSED DUCTWORK)</td><td>A</td><td>A</td><td>B</td><td>B</td></tr></table> <p>5. HANGERS FOR DUCTS UP TO 18" IN WIDTH OR DIAMETER SHALL BE PLACED ON NOT MORE THAN 8 FOOT CENTERS. DUCTS 19" AND OVER IN WIDTH OR DIAMETER SHALL BE SUPPORTED ON NOT MORE THAN 4 FOOT CENTERS. DUCT HANGERS SHALL BE CONSTRUCTED OF GALVANIZED BAND IRON 1-1/8" FOR DUCTS UP TO 36" IN WIDTH OR DIAMETER. HANGERS SHALL EXTEND DOWN SIDES AND A MINIMUM OF 1" UNDER RECTANGULAR DUCTS, AND WRAP COMPLETELY AROUND ROUND DUCTS. ALL DUCTS SHALL BE RIGIDLY SUPPORTED.</p> <p>6. ALL DUCTWORK SHALL BE CLEANED PRIOR TO THE INSTALLATION OF CEILING AND DIFFUSERS. OPERATE FANS TO BLOW OUT DUCTWORK.</p> <p>7. RECTANGULAR LOW-PRESSURE SUPPLY AND RETURN AIR DUCTWORK SHALL BE LINED WITH 1" FACED FIBERGLASS INSULATION SECURELY BUTTONED OR LAPPED AND SEALED. INSULATION SHALL BE 1-1/2 POUND DENSITY.</p> <p>8. OUTDOOR DUCTWORK EXPOSED TO THE WEATHER SHALL BE LINED WITH MINIMUM R-8 FACED FIBERGLASS INSULATION SECURELY BUTTONED OR LAPPED AND SEALED. INSULATION SHALL BE FITTED WITH A 0.016 EMBOSSED ALUMINUM JACKET POP-RIVETED FOR A WEATHERPROOF FIT.</p> <p>9. DUCT DIMENSIONS SHOWN ON DRAWINGS ARE INSIDE CLEAR AREA AND SHALL BE INCREASED TO ACCOMMODATE INSULATION. DUCT LINER TO BE BY KNAUF GMBH, JOHN-MANSVILLE OR SCHULLER INTERNATIONAL.</p> <p>10. CLASS I KITCHEN EXHAUST HOOD DUCT SYSTEMS:</p> <p>A. TYPE I COMMERCIAL HOOD AND GREASE DUCT SHALL MEET CLEARANCE REQUIREMENTS FROM COMBUSTIBLE AND NONCOMBUSTIBLE CONSTRUCTION IN ACCORDANCE TO 2012 IMC SECTION 507.8 AND ASTM E23-36.</p> <p>B. CONSTRUCT EXHAUST DUCT OF WELDED 16 GAUGE CARBON STEEL SHEETS FOR CONCEALED DUCTS, AND WELDED OR FLANGED 18 GAUGE STAINLESS STEEL FOR EXPOSED DUCTS.</p> <p>C. SLOPE HORIZONTAL DUCT AT 1/4" PER FOOT TOWARD HOOD.</p> <p>D. PROVIDE ACCESS DOORS AT EACH CHANGE OF DIRECTION.</p> <p>E. PROVIDE RESIDUE TRAP AT THE BASE OF EACH VERTICAL RISER, WITH PROVISIONS FOR CLEAN-OUT.</p> <p>F. ALL SEAMS, JOINTS AND PENETRATIONS SHALL HAVE A LIQUID-TIGHT, CONTINUOUS, EXTERNAL WELD.</p> <p>G. PROVIDE AND INSTALL ONE OF THE FOLLOWING SYSTEMS: DUCT ENCLOSURE WITH 2-HR FIRE RESISTIVE CONSTRUCTION OR, A DUCT WRAP SYSTEM - 3M PREMASTER GREASE DUCT FIRE PROTECTION SYSTEM OR APPROVED EQUAL, OR A PREFABRICATED GREASE DUCT SYSTEM - METAL FAB MODEL "NO CHASE IPIC", OR APPROVED EQUAL. WHICHEVER METHOD IS CHOSEN MUST HAVE APPROVAL FROM THE ADMINISTRATIVE AUTHORITY AND STATE FIRE MARSHAL.</p>		DUCT LOCATION	DUCT TYPE				SUPPLY		EXHAUST	RETURN		<2in. Wg.	2-26in. Wg.			OUTDOORS	A	A	A	A	UNCONDITIONED SPACES	B	A	B	B	CONDITIONED SPACES (CONCEALED DUCTWORK)	C	B	B	B	CONDITIONED SPACES (EXPOSED DUCTWORK)	A	A	B	B	<p>233300 - DUCTWORK ACCESSORIES</p> <p>1. FLEXIBLE DUCTWORK: THE FINAL 5 FOOT CONNECTION TO GRILLES AND DIFFUSERS IN LAY-IN CEILINGS, OR TO FLOOR MOUNTED GRILLES, MAY BE MADE WITH FLEXIBLE DUCT, FLEXMASTER TYPE SM ONLY. ENDS SHALL BE SEALED.</p> <p>2. SQUARE/RECTANGULAR ELBOWS SHALL BE PROVIDED WITH TURNING VANES.</p> <p>3. PROVIDE FLEXIBLE CONNECTIONS NOT LESS THAN 4" WIDE CONSTRUCTED OF HEAVY, WATERPROOF, WOVEN PLASTIC COATED GLASS FABRIC AT SUPPLY AND RETURN CONNECTIONS TO HEAT PUMPS, AIR HANDLING, ROOFTOP, MAKE-UP AIR OR FAN-COIL UNITS. CORNERS SHALL BE SEWN TIGHT. CONNECTIONS SHALL BE 20 OUNCE VENT-FABRICS OR EQUAL.</p> <p>4. COMBINATION FIRE AND SMOKE DAMPERS, SMOKE DAMPERS, OR FIRE DAMPERS IN DUCTWORK THROUGH ALL FLOORS AND FIRE WALLS SHALL BE FURNISHED AND INSTALLED AS REQUIRED TO CONFORM TO THE LATEST NEPA BULLETIN CONCERNING THIS TYPE OF BUILDING AND SHALL BE LISTED AND LABELED IN ACCORDANCE WITH THE STANDARDS AND REQUIREMENTS OF UL555 AND UL655. DAMPERS, COMPLETE WITH MOUNTING ANGLES, SHALL BE MULTIBLADE, FUSIBLE LINK, SPRING ACTING WITH 11 GAUGE SLEEVE. FUSIBLE LINK SHALL BE RATED AT 165°F. CONTROLLED BY AUTOMATIC SMOKE DETECTION IN DUCT OR AREA OF SMOKE DISPERSION.</p> <p>5. DUCT MOUNTED BALANCING DAMPERS SHALL BE USED TO CONTROL SUPPLY AIR TO EACH DIFFUSER AND GRILLE. AN OPERATING HEAD SHALL BE PLACED ON THE SIDE OF THE DUCT WITH A POSITIVE LOCKING QUADRANT. DAMPERS SHALL BE PROVIDED IN RETURN AND EXHAUST AIR DUCTS WHERE SHOWN ON DRAWINGS. COORDINATE THE LOCATION OF CEILING ACCESS PANELS.</p> <p>6. PROVIDE CEILING ACCESS DOORS AT ALL LOCATIONS OF BALANCING DAMPERS, FIRE DAMPERS, FIRE-SMOKE DAMPERS, VALVES, ETC., WHERE THERE IS NOT A LIFT-OUT TYPE CEILING. ACCESS DOORS SHALL BE HINGED OF METAL CONSTRUCTION WITH SCREWDRIVER LATCHES. ACCESS DOORS TO BE LISTED AND FIRE RATED EQUAL TO OR GREATER THAN THE RATING ASSEMBLY THEY ARE INSTALLED IN.</p> <p>7. AT FIRE DAMPERS, A DUCT MOUNTED SHEET METAL HINGED DOOR SHALL BE PROVIDED AND INSTALLED WITH POSITIVE LOCKING HANDLE. WHERE DUCTS ARE INSULATED, COVERS SHALL BE INSULATED. FIRE DAMPERS SHALL BE LISTED AND LABELED IN ACCORDANCE WITH THE STANDARDS AND REQUIREMENTS OF UL555, CONTROLLED BY FIRE DETECTOR, FUSABLE LINK, OR ELECTRICAL FUSIBLE LINK. PROVIDE 1, 1-1/2, OR 3 HR FIRE RATED MATERIALS AT ALL PENETRATIONS OF FIRE BARRIERS BY DUCTS. SYSTEM APPROVED BY ASTM E 814 OR EQUAL.</p> <p>8. GRAVITY OR BACKDRAFT DAMPERS SHALL BE ALL ALUMINUM CONSTRUCTION, INTERCONNECTED AND BLADED, PRESSURE DROP THROUGH DAMPERS SHALL NOT EXCEED 0.04" W.G.</p> <p>9. FIRE ALARM CONTRACTOR SHALL TEST FOR FIRE-SMOKE DAMPERS AS REQUIRED BY LOCAL BUILDING OFFICIAL AND FIRE AUTHORITY PRIOR TO OCCUPANCY.</p> <p>233416 - FANS</p> <p>1. ROOF MOUNTED EXHAUST FANS SHALL BE COMPLETE WITH BACKDRAFT DAMPERS. A DISCONNECT SWITCH SHALL BE PROVIDED AT THE FAN.</p> <p>2. THE DISCONNECT SWITCH SHALL TURN OFF THE FAN WITH THE ACTIVATION OF SMOKE DETECTION.</p> <p>3. THE FAN SHALL BE COMPLETE WITH INSECT SCREEN AND PREFABRICATED ROOF CURB MATCHING THE FAN SIZE.</p> <p>4. CEILING MOUNTED EXHAUST FANS SHALL BE COMPLETE WITH LOUVERED GRILLE, BACKDRAFT DAMPER, AND WALL CAP OR ROOF CAP. SEE PLANS.</p> <p>5. FANS FOR GREASE HOOD APPLICATIONS SHALL BE UPLIST TYPE, LISTED AND LABELED FOR GREASE HOOD USE AND INSTALLED PER APPLICABLE CODES.</p> <p>6. UTILITY FAN SETS SHALL BE BELT DRIVE, CENTRIFUGAL, FANS CONSISTING OF WEATHER PROOF HOUSING, WHEEL, FAN SHAFT, BEARINGS, MOTOR, DISCONNECT SWITCH, DRIVE ASSEMBLY, DRAIN CONNECTION AND ACCESSORIES.</p> <p>7. MANUFACTURERS: COOK, ILG, PENN, GREENHECK, & BROWN</p> <p>233713 - GRILLES, DIFFUSER AND LOUVERS</p> <p>1. ALL GRILLES, DIFFUSERS, AND REGISTERS SHALL BE COMPLETE WITH FRAMES AND RUBBER GASKETS. FINISH FOR ALL REGISTERS, DIFFUSERS, AND GRILLES SHALL BE WHITE.</p> <p>2. COORDINATE THE LOCATIONS OF ALL CEILING DIFFUSERS, REGISTERS, AND GRILLES WITH THE ARCHITECTURAL REFLECTED CEILING PLAN, ELECTRICAL LIGHTING LAYOUT, AND ARCHITECTURAL ELEVATIONS.</p> <p>3. LOUVERS SHALL HAVE MINIMUM FREE AREA AND MAXIMUM PRESSURE DROP AS LISTED IN THE SCHEDULES. LOUVER SHALL HAVE FRAME AND SILLS COMPATIBLE WITH ADJACENT SUBSTRATE AND FIT ACCURATELY FOR WEATHERPROOF INSTALLATION. LOUVERS SHALL BE COMPLETE WITH 1/2" MESH ANODIZED ALUMINUM BIRD SCREEN.</p>	
DUCT LOCATION	DUCT TYPE																																												
	SUPPLY		EXHAUST	RETURN																																									
	<2in. Wg.	2-26in. Wg.																																											
OUTDOORS	A	A	A	A																																									
UNCONDITIONED SPACES	B	A	B	B																																									
CONDITIONED SPACES (CONCEALED DUCTWORK)	C	B	B	B																																									
CONDITIONED SPACES (EXPOSED DUCTWORK)	A	A	B	B																																									
<p>MECHANICAL SUBMITTAL NOTES</p> <p>1. MECHANICAL SUBMITTAL SHALL BE SUBMITTED AS A COMPLETE ELECTRONIC PACKAGE ASSEMBLED BY SPECIFICATION DIVISIONS.</p> <p>2. ASSEMBLE COMPLETE ELECTRONIC SUBMITTAL PACKAGE INTO A SINGLE INDEXED FILE INCORPORATING SUBMITTAL REQUIREMENTS OF A SINGLE SPECIFICATION SECTION AND TRANSMITTAL FORM WITH LINKS ENABLING NAVIGATION TO EACH ITEM.</p> <p>a. LITERATURE SHALL INCLUDE REFERENCE TO EQUIPMENT CALL-OUT AND SPECIFICATION SECTION.</p> <p>b. FILE NAME SHALL USE PROJECT IDENTIFIER AND SPECIFICATION SECTION NUMBER FOLLOWED BY A DECIMAL POINT AND THEN A SEQUENTIAL NUMBER (E.G., LNH5-061000.01). RESUBMITTALS SHALL INCLUDE AN ALPHABETIC SUFFIX AFTER ANOTHER DECIMAL POINT (E.G., LNH5-061000.01.A).</p> <p>c. PROVIDE MANUFACTURER'S CATALOG DATA SHEETS FOR EACH MANUFACTURED ITEM LISTED ON THE DRAWINGS AND SPECIFICATIONS.</p> <p>d. INCLUDE MANUFACTURER'S CATALOG DATA OF EACH MANUFACTURED ITEM AND ENOUGH INFORMATION TO SHOW COMPLIANCE WITH CONTRACT DOCUMENT REQUIREMENTS.</p> <p>e. LITERATURE SHALL SHOW CAPACITIES AND SIZE OF EQUIPMENT USED AND BE MARKED INDICATING EACH SPECIFIC ITEM WITH APPLICABLE DATA UNDERLINED.</p> <p>f. INCLUDE NAME, ADDRESS, AND PHONE NUMBER OF EACH SUPPLIER.</p> <p>g. DEVIATIONS AND ADDITIONAL INFORMATION: ON AN ATTACHED SEPARATE SHEET, PREPARED ON CONTRACTOR'S LETTERHEAD, RECORD RELEVANT INFORMATION, REQUESTS FOR DATA, REVISIONS OTHER THAN THOSE REQUESTED BY ENGINEER CONTRACT DOCUMENTS, INCLUDING MINOR VARIATIONS AND LIMITATIONS. INCLUDE SAME IDENTIFICATION INFORMATION AS RELATED SUBMITTAL.</p> <p>3. PRODUCT DATA:</p> <p>a. COLLECT INFORMATION INTO A SINGLE SUBMITTAL FOR EACH ELEMENT OF CONSTRUCTION AND TYPE OF PRODUCT OR EQUIPMENT.</p> <p>b. IF INFORMATION MUST BE SPECIALLY PREPARED FOR SUBMITTAL BECAUSE STANDARD PUBLISHED DATA ARE NOT SUITABLE FOR USE, SUBMIT AS SHOP DRAWINGS, NOT AS PRODUCT DATA.</p> <p>c. MARK EACH COPY OF EACH SUBMITTAL TO SHOW WHICH PRODUCTS AND OPTIONS ARE APPLICABLE.</p> <p>d. INCLUDE THE FOLLOWING INFORMATION, AS APPLICABLE:</p> <p>e. MANUFACTURER'S CATALOG CUTS.</p> <p>f. MANUFACTURER'S PRODUCT SPECIFICATIONS.</p> <p>g. STANDARD COLOR CHARTS.</p> <p>h. STATEMENT OF COMPLIANCE WITH SPECIFIED REFERENCED STANDARDS.</p> <p>i. TESTING BY RECOGNIZED TESTING AGENCY.</p> <p>j. APPLICATION OF TESTING AGENCY LABELS AND SEALS.</p> <p>k. NOTATION OF COORDINATION REQUIREMENTS.</p> <p>l. AVAILABILITY AND DELIVERY TIME INFORMATION.</p> <p>m. FOR EQUIPMENT, INCLUDE THE FOLLOWING IN ADDITION TO THE ABOVE, AS APPLICABLE:</p> <p>n. WIRING DIAGRAMS SHOWING FACTORY-INSTALLED WIRING.</p> <p>o. PRINTED PERFORMANCE CURVES.</p> <p>p. OPERATIONAL RANGE DIAGRAMS.</p> <p>q. CLEARANCES REQUIRED TO OTHER CONSTRUCTION, IF NOT INDICATED ON ACCOMPANYING SHOP DRAWINGS.</p> <p>5. PROCESSING TIME: ALLOW TIME FOR SUBMITTAL REVIEW, INCLUDING TIME FOR RESUBMITTALS, AS FOLLOWS: TIME FOR REVIEW, INCLUDING TIME FOR RESUBMITTALS, AS FOLLOWS: TIME FOR REVIEW SHALL COMMENCE ON ENGINEER'S RECEIPT OF SUBMITTAL. NO EXTENSION OF THE CONTRACT TIME WILL BE AUTHORIZED BECAUSE OF FAILURE TO TRANSMIT SUBMITTALS ENOUGH IN ADVANCE OF THE WORK TO PERMIT PROCESSING, INCLUDING RESUBMITTALS.</p> <p>a. INITIAL REVIEW: ALLOW 15 DAYS FOR INITIAL REVIEW OF MECHANICAL SUBMITTAL.</p> <p>b. RESUBMITTALS REVIEW: ALLOW 15 DAYS FOR REVIEW OF EACH RESUBMITTAL.</p> <p>6. DEVIATIONS AND ADDITIONAL INFORMATION: ON AN ATTACHED SEPARATE SHEET, PREPARED ON CONTRACTOR'S LETTERHEAD, RECORD RELEVANT INFORMATION, REQUESTS FOR DATA, REVISIONS OTHER THAN THOSE REQUESTED BY DESIGN ENGINEER ON PREVIOUS SUBMITTALS, AND DEVIATIONS FROM REQUIREMENTS IN THE CONTRACT DOCUMENTS, INCLUDING MINOR VARIATIONS AND LIMITATIONS. INCLUDE SAME IDENTIFICATION INFORMATION AS RELATED SUBMITTAL.</p>																																													
<p>DUCT CONSTRUCTION NOTES</p> <p>1. ALL DUCTWORK SHALL BE GALVANIZED SHEET METAL, EXCEPT WHERE INDICATED OTHERWISE.</p> <p>2. SHEET METAL DUCT STATIC PRESSURE CLASSIFICATION: SUPPLY AIR DUCT: 2" W.C. RETURN AIR DUCT: 2" W.C. (NEGATIVE) EXHAUST AIR DUCT: 2" W.C. (NEGATIVE) OUTSIDE AIR DUCT: 2" W.C.</p> <p>3. SEAL ALL TRANSVERSE JOINTS AND LONGITUDINAL SEAMS TO SMACNA SEAL CLASS B.</p> <p>4. DO NOT USE GRAY DUCT TAPE, FOIL BACKED TAPE, OIL BASED CAULKING AND GLAZING COMPOUNDS TO SEAL METAL DUCTS.</p> <p>5. CROSS-BREAK DUCT SURFACES 19" THROUGH 60": USE ANGLE REINFORCING FOR DUCTS SURFACES OF 60".</p> <p>6. ALL METAL LONGITUDINAL SEAMS SHALL BE PITTSBURGH OR OTHER LISTED SMACNA LISTED SEAM. DO NOT USE BUTTON PUNCH SNAP-BACK SEAMS.</p> <p>7. SUSPEND METAL DUCTWORK NOT EXCEEDING 30' LONGEST SIDE AT EVERY JOINT. DO NOT EXCEED 10" HANGER SPACING. USE 1" X 1/8" GAGE GALVANIZED STRAPS (MINIMUM) ATTACHED TO BOTTOM AND SIDES OF DUCT.</p> <p>8. SUSPEND METAL DUCTWORK EXCEEDING 30' LONGEST SIDE AT MAXIMUM 8'-0" SPACING USING ANGLES AND RODS.</p> <p>9. SUPPORT DUCTWORK FROM STRUCTURAL MEMBERS. ATTACHMENT TO ROOF DECK IS NOT ACCEPTABLE.</p> <p>10. DUCT TRANSITIONS SHALL BE CONSTRUCTED WITH SLOPE OF 1/4".</p> <p>11. PROVIDE ELBOWS AND CHANGES IN DIRECTION WITH SINGLE VANE TURNING VANES.</p> <p>12. ALL JOINTS SHALL BE MADE AIRTIGHT BY APPROVED METHODS, INCLUDING TAPES, MASTICS, GASKETS OR OTHER APPROVED CLOSURE SYSTEMS.</p> <p>13. TAPE ALONE CANNOT BE SUBSTITUTED FOR MECHANICAL FASTENERS.</p> <p>14. TAPES AND MASTICS USED TO SEAL DUCTWORK MUST BE LISTED AND LABELED IN ACCORDANCE WITH UL 181A AND SHALL BE MARKED "181A-P" FOR PRESSURE-SENSITIVE TAPE, "181A-M" FOR MASTIC OR "181A-H" FOR HEAT SENSITIVE TAPE.</p> <p>15. TAPES AND MASTICS USED TO SEAL FLEXIBLE AIR DUCTS SHALL COMPLY WITH UL 181B AND SHALL BE MARKED "181B-FX" FOR PRESSURE SENSITIVE TAPE, OR "181B-M" FOR MASTIC.</p> <p>16. MECHANICAL FASTENERS USED WITH FLEXIBLE NON-METALLIC AIR DUCTS SHALL COMPLY WITH UL 181 AND SHALL BE MARKED "181B-".</p> <p>17. FLEXIBLE CONNECTORS SHALL NOT BE USED.</p> <p>18. HIGH EFFICIENCY TAKE-OFF FITTINGS WITH MANUAL DAMPER SHALL HAVE 2" STAND OFF BRACKET.</p> <p>19. ALL BRANCH TAKE-OFFS TO INDIVIDUAL AIR INLET OR AIR OUTLET SHALL BE PROVIDED WITH MANUAL DAMPER.</p> <p>20. ALL DUCTWORK SHALL BE A MINIMUM 26 GAUGE GALVANIZED SHEET METAL.</p>																																													
<p>SMOKE DETECTOR NOTES</p> <p>1. SMOKE DETECTORS SHALL BE PHOTOELECTRIC TYPE AND SHALL BE "SYSTEM SENSOR" DH100ACDPL.</p> <p>2. SMOKE DETECTORS SHALL BE INSTALLED IN THE RETURN AIR DUCT OF ALL AIR HANDLING UNITS WITH CAPACITY GREATER THAN 2,000 CFM.</p> <p>3. PROVIDE SMOKE DETECTORS WHERE MULTIPLE AIR-HANDLING SYSTEMS SHARE COMMON SUPPLY OR RETURN AIR DUCTS OR PLENUMS WITH A COMBINED DESIGN CAPACITY GREATER THAN 2,000 CFM.</p> <p>4. THE SMOKE DETECTORS SHALL BE INSTALLED TO MONITOR THE ENTIRE AIRFLOW CONVEYED BY THE SYSTEM INCLUDING RETURN AIR AND EXHAUST OR RELIEF AIR.</p> <p>5. PROVIDE ACCESS TO ALL SMOKE DETECTORS FOR INSPECTION AND MAINTENANCE.</p> <p>6. SMOKE DETECTOR SHALL BE INTERLOCKED WITH SUPPLY FAN. ELECTRICAL STARTER TO SHUT DOWN SUPPLY AIR FANS) ON SENSING SMOKE.</p> <p>7. SMOKE DETECTOR SHALL BE INTERLOCKED WITH FIRE ALARM SYSTEM.</p> <p>8. THE ACTUATION OF A DUCT SMOKE DETECTOR SHALL ACTIVATE A VISIBLE AND AUDIBLE SUPERVISORY SIGNAL AT A CONSTANTLY ATTENDED LOCATION.</p> <p>9. IN ADDITIONAL TO INTERLOCKING THE SMOKE DETECTOR TO THE FIRE ALARM SYSTEM, THE SMOKE DETECTOR SHALL BE CONNECTED TO A MULTI-SIGNALLING ANNUNCIATOR PANEL (SYSTEM SENSOR SSK 451) FOR TESTING PURPOSES.</p> <p>10. MULTI-SIGNALLING ANNUNCIATOR PANEL (SYSTEM SENSOR SSK 451) SHALL BE INSTALLED AS SHOWN ON DRAWING AND AS REQUIRED BY BUILDING OFFICIAL FOR TESTING.</p>																																													
<p>MECHANICAL SPECIFICATIONS</p> <p>230100 - BASIC MECHANICAL REQUIREMENTS</p> <p>1. COORDINATE THE LOCATION OF ALL NEW ROOF OPENINGS AND THE LOCATION OF ALL NEW AND RELOCATED ROOF MOUNTED EQUIPMENT WITH THE EXISTING STRUCTURE AND ARCHITECTURAL PLANS PRIOR TO ANY INSTALLATION.</p> <p>2. V-BELT DRIVES SHALL BE OF FABRIC AND RUBBER CONSTRUCTION. BELT GUARDS SHALL BE PROVIDED FOR ALL EXPOSED BELTS AND DRIVES.</p> <p>3. PROVIDE 6" CONCRETE HOUSEKEEPING PADS UNDER ALL FLOOR MOUNTED EQUIPMENT.</p> <p>4. PROPERLY LUBRICATE ALL PIECES OF EQUIPMENT BEFORE TURNING THE SYSTEM OVER TO THE OWNER.</p> <p>5. INSTALL DUCT MOUNTED SUPPLY AND RETURN AIR SMOKE DETECTORS IN ALL ROOFTOP, FAN-COIL, AIR-HANDLING, AND OTHER SUPPLY AIR SYSTEMS, WITH A CAPACITY GREATER THAN 2000 CFM. SMOKE DETECTORS ARE PURCHASED AND WIRED BY THE ELECTRICAL CONTRACTOR.</p> <p>230500 - BASIC PIPING MATERIALS & METHODS</p> <p>1. CORE CUT ALL PIPE PENETRATION OF EXISTING MASONRY OR CONCRETE WALLS AND FLOORS. SLEEVE ALL PENETRATIONS THROUGH NEW WALLS AND FLOORS. SEAL ALL PENETRATIONS TIGHT WITH SILICONE SEALANT. USE FIRE RATED SEALANT (3M "FIRE BARRIER" OR EQUAL) FOR 1 HOUR OR 2 HOUR PENETRATIONS.</p> <p>2. CAULK AROUND ALL PIPING THAT PASSES THROUGH FIRE-RATED PARTITIONS WITH A NON-HARDENING CAULKING SIMILAR TO 3M "FIRE BARRIER".</p> <p>3. SEAL ALL PIPING THROUGH WALLS AIR TIGHT.</p> <p>230523 - VALVES</p> <p>1. PROVIDE VALVES OF THE TYPE AND QUANTITY SHOWN ON THE DRAWINGS. VALVES OF THE SAME TYPE TO BE BY ONE MANUFACTURER.</p> <p>230548 - VIBRATION ISOLATION AND SEISMIC BRACING</p> <p>1. ALL MECHANICAL EQUIPMENT, DUCTWORK, AND PIPING MUST BE VIBRATION ISOLATED AND SEISMICALLY BRACED FOR THE SITE SPECIFIC SEISMIC DESIGN CATEGORY AND SEISMIC USE GROUP, IN ACCORDANCE WITH THE LATEST ADOPTED EDITIONS OF THE IBC, UBC, ASHRAE, AND SMACNA. PROVIDE SEISMIC PRODUCTS BY AMBER-BOOTH OR MASON INDUSTRIES.</p> <p>2. IN GENERAL, PROVIDE SPRING MOUNTS TO ATTENUATE LOW FREQUENCY SOUND AND VIBRATION AND NEOPRENE PADS TO ATTENUATE HIGH FREQUENCY SOUND AND VIBRATION. SEISMIC BRACING/MOUNTING CAN BE COMBINED WITH VIBRATION ISOLATION AS APPLICABLE.</p> <p>3. CONTRACTOR MANUFACTURED SEISMIC BRACING/RESTRAINT METHODS ARE NOT ACCEPTABLE. PROVIDE A SIGNED AND STAMPED LETTER FROM A PROFESSIONAL ENGINEER CERTIFYING THAT THE SUPPLIED PRODUCTS ARE CORRECT FOR THE APPLICATION AND THAT THE INSTALLATION IS IN COMPLIANCE WITH ALL APPLICABLE CODES.</p>																																													

Donald L. Welch

Architect

7533 Sandy Land Lane
Midvale, Utah 84047
801.548-6391
dwelch5977@msn.com



324 S. State St., Suite 400
Salt Lake City, UT 84111
800-678-7077
801-328-5151
fax: 801-328-5155
www.spectrum-engineers.com

THE DESIGNS SHOWN AND DESCRIBED HEREIN INCLUDING ALL TECHNICAL DRAWINGS, GRAPHIC REPRESENTATION & MODELS THEREOF, ARE PROPRIETARY & CAN NOT BE COPIED, DUPLICATED, OR COMMERCIALY EXPLOITED IN WHOLE OR IN PART WITHOUT THE SOLE AND EXPRESS WRITTEN PERMISSION FROM DONALD L. WELCH ARCHITECT

THESE DRAWINGS ARE AVAILABLE FOR LIMITED REVIEW AND EVALUATION BY CLIENTS, CONSULTANTS, CONTRACTORS, GOVERNMENT AGENCIES, VENDORS, AND OFFICE PERSONNEL ONLY IN ACCORDANCE WITH THIS NOTICE.



project:

Tenant Finish
for New
Brighton
Recovery
Campus
4905, 4911, 4915,
4925, 4931, & 4953
South 900 East
Salt Lake County,
Utah

date

April 11, 2017

revisions

△ PERMIT SET-December 28, 2016

△ ADDENDUM #1-January 04, 2017

△ ADDENDUM #4-January 11, 2017

△ ADDENDUM #3-January 17, 2017

△ ADDENDUM #5-January 20, 2017

△ ADDENDUM #7-February 24, 2017

△ ADDENDUM #8 - March 20, 2017

△ ADDENDUM #9 - April 11, 2017

data

project no:
drawn by:
checked by:
title
MECHANICAL
EQUIPMENT
SPECIFICATIONS
sheet

M02

BUILDING 'C'

ELECTRIC UNIT HEATER SCHEDULE											
SYMBOL	MANUFACTURER AND MODEL NO.	LOCATION	ARRANGEMENT	CFM	ELECTRICAL				OPERATING WEIGHT (LBS.)	NOTES	ACCESSORIES AND REMARKS
					KW	MOTOR	VOLT	PHASE			
						H.P.					
EUH-1	TRANE UHEC03	WATER ENTRIES	VERTICAL	400	3.3	1/125	208	1	132	3	WALL HUNG
EUH-2	TRANE UHCA02	EXIT DOORS	HORIZONTAL	-	2.0	-	208	1	-	1,2	RECESSED, CEILING MOUNTED
EUH-3	TRANE UHAA15	CUSTODIAN	VERTICAL	-	1.5	-	208	1	22	1,2	RECESSED, WALL MOUNTED

NOTES:
(1) UNIT MOUNTED TAMPERPROOF THERMOSTAT
(2) UNIT MOUNTED DISCONNECT SWITCH
(3) PROVIDE WALL MOUNTED LINE VOLTAGE THERMOSTAT AND TAMPERPROOF WALL BRACKET

DIFFUSER AND GRILLE SCHEDULE						
SYMBOL	MANUFACTURER AND MODEL NO.	LOCATION	CFM	OVERALL SIZE	NOTES	ACCESSORIES AND REMARKS
SG-1	TITUS 300R	CEILING	SEE PLANS	14 X 6 10 X 6	3,5	CEILING SUPPLY GRILLE W/ FIRE DAMPER
CD-1	TITUS PAS-FR	CEILING	SEE PLANS	24 X 24 12 X 12	2,5	CEILING DIFFUSER W/ FIRE DAMPER
RG-1	TITUS PAR-FR	CEILING	SEE PLANS	24 X 24 16 X 16	2,5	RETURN GRILLE W/ FIRE DAMPER
EG-1	TITUS 63F	EXTERIOR EXHAUST TERMINATION	SEE PLANS	8X6	4	EXHAUST DISCHARGE GRILLE, ALUMINUM
DG-1	TITUS CT-700L	DOOR TRANSFER	SEE PLANS	18 X 12	1	DOOR GRILLE
FIRE RATING NOTE: ALL CEILING DUCTWORK & DIFFUSER PENETRATIONS TO HAVE UL CLASSIFIED FIRE DAMPERS TO MAINTAIN FIRE RATING. (TYPICAL)						

NOTES:
(1) PROVIDE AUXILIARY FRAME FOR TO ALLOW FOR FINISHED LOOK ON BOTH SIDES OF DOOR.
(2) PROVIDE FRAME AND BALANCING DAMPER ACCESSIBLE THROUGH GRILLE FOR HARDLID CEILING APPLICATIONS AS REQUIRED.
(3) PROVE DOUBLE DEFLECTION GRILLE WITH INTEGRAL BALANCING DAMPER.
(4) PROVIDE NECESSARY FRAME TO ALLOW FOR INSTALLATION ON BOTTOM SIDE OF EXISTING EXTERIOR OVERHANG.
(5) PROVIDE UL CLASSIFIED FIRE RATED CEILING DIFFUSER ASSEMBLY.

EXHAUST FAN SCHEDULE												
SYMBOL	MANUFACTURER AND MODEL NO.	LOCATION	TYPE	FAN		ELECTRICAL				OPERATING WEIGHT (LBS.)	CONTROL METHOD	ACCESSORIES AND REMARKS
				CFM	ESP	MOTOR		VOLT	PHASE			
						H.P.	WATTS					
EF-1	PANASONIC FV-05-11VKS1	PRIVATE UNIT BATHROOMS	CEILING	110	0.5	-	57	115	1	27	1	CEILING MOUNTED W/ WHITE GRILLE
EF-2	PANASONIC FV-11-15VKS1	PUBLIC RESTROOM	CEILING	150	0.5	-	13	115	1	27	1	CEILING MOUNTED W/ WHITE GRILLE

CONTROL METHOD:
(1) CONTROLLED BY WALL SWITCH
(2) FAN RUNS CONTINUOUSLY DURING BUILDING OCCUPANCY
(3) CONTROLLED BY LINE VOLTAGE SPACE THERMOSTAT

ACCESSORIES:
(1) STANDARD DISCONNECT NEMA 1
(2) BACKDRAFT DAMPER
(3) FLEX DUCT CONNECTION
(4) FAN SPEED CONTROLLER 5A 120V PREWIRED
(5) RUBBER ISOLATOR SET (4)
(6) PROVIDE UL LISTED CEILING RADIATION DAMPER TO MATCH FAN TYPE (PANASONIC-RD05C3)

ROOFTOP UNIT SCHEDULE (2-STAGE HEATING/COOLING)														
SYMBOL	MANUFACTURER	MODEL #	CFM	ESP	VOLT/PH	EER	COOLING CAP HI STAGE (BTUH)	HEATING INPUT (BTUH)	ELECTRICAL		DIMENSIONS H X W X L	WEIGHT (LBS)	COMMENTS	
									VOLT/PH	MCA (AMPS)				MAX FUSE
RTU-1	TRANE	4YCZ6036	1200	1.0	208/3	16.0	36,000	96,000	208/3	19.1	30 A	48" X 45" X 52"	550	HORIZONTAL SUPPLY/RETURN
RTU-2	TRANE	YHC047E3	1600	1.0	208/3	16.0	50,500	120,000	208/3	28.9	40 A	41" X 53" X 88"	800	HORIZONTAL SUPPLY/RETURN

(1) PROVIDE DIGITAL REMOTE PROGRAMMABLE THERMOSTAT IN LOCKABLE COVER.
(2) 0-25% MANUAL FRESH AIR DAMPER (BUILDING B RTUS)
(3) 0-100% HORIZONTAL ECONOMIZER (BUILDINGS A & C THRU F RTUS)
(4) 13" HIGH ROOF CURB/PLATFORM
(5) CRANKCASE HEATER FOR LOW AMBIENT COOLING
(6) PROVIDE INSULATED DUCT SHROUD ON ALL EXTERIOR DUCTWORK
(7) GAS PRESSURE REGULATOR & ISOLATION VALVE
(8) 120 V CONVENIENCE OUTLET INTEGRAL TO UNIT
(9) CONDENSER COIL HAIL GUARD
(10) NON-FUSED DISCONNECT INTEGRAL TO UNIT
(11) GAS & ELECTRIC FEEDS TO ENTER THROUGH BASE OF UNIT

DUCTLESS SPLIT SYSTEM HEAT PUMP														
SYMBOL	MANUFACTURER	INDOOR UNIT				COOLING CAPACITY (BTUH)	HEATING CAPACITY (BTUH)	OUTDOOR UNIT					COMMENTS	
		MODEL #	CFM	VOLT/PH	RLA (AMPS)			SYMBOL	VOLT/PH	MCA (AMPS)	MODEL #	HSPF		SEER
DSS-1	LENNOX	MS8-HI-24P	590	208/1	0.24	25,000	26,000	CU-1	208/1	16.0	MS8-HO-24P	10.20	18.00	HIGH SIDEWALL STYLE (BLDGS. A, B, D, E & F)
DSS-2	LENNOX	MS8-HI-30P	705	208/1	0.40	30,000	33,000	CU-2	208/1	20.0	MS8-HO-30P	8.20	16.00	HIGH SIDEWALL STYLE (BLDG. C)

(1) PROVIDE REMOTE PROGRAMMABLE THERMOSTAT. BUILDINGS A, B, D, E & F MAX TEMP 85F (ADJ.) BUILDING C COOLING SETPOINT 70F (ADJ.) MAINTAIN 50F HEATING SETPOINT (ADJ.)
(2) BUILT IN CONDENSATE PUMP / DISCHARGE CONDENSATE TO APPROVED LOCATION
(3) MULTI-SPEED FAN
(4) DEFROST CONTROL
(5) COMPRESSOR OVERCURRENT PROTECTION
(6) PROVIDE MANUFACTURER'S WALL CHANNEL (SPEEDICHANNEL SYSTEM) TO CONCEAL ALL REFRIGERANT PIPING EXPOSED TO VIEW AND EXTERIOR CONDITIONS.
(7) PROVIDE MANUFACTURER'S CONDENSER PAD 18 X 36 X 2

Donald L. Welch
Architect
7533 Sandy Land Lane
Midvale, Utah 84047
801.548-6391
dwelch5977@msn.com




324 S. State St., Suite 400
Salt Lake City, UT 84111
800-678-7077
801-328-5151
fax: 801-328-5155
www.spectrum-engineers.com

THE DESIGNS SHOWN AND DESCRIBED HEREIN INCLUDING ALL TECHNICAL DRAWINGS, GRAPHIC REPRESENTATION & MODELS THEREOF, ARE PROPRIETARY & CAN NOT BE COPIED, DUPLICATED, OR COMMERCIALY EXPLOITED IN WHOLE OR IN PART WITHOUT THE SOLE AND EXPRESS WRITTEN PERMISSION FROM DONALD L. WELCH ARCHITECT

THESE DRAWINGS ARE AVAILABLE FOR LIMITED REVIEW AND EVALUATION BY CLIENTS CONSULTANTS, CONTRACTORS, GOVERNMENT AGENCIES, VENDORS, AND OFFICE PERSONNEL ONLY IN ACCORDANCE WITH THIS NOTICE.

consultant:

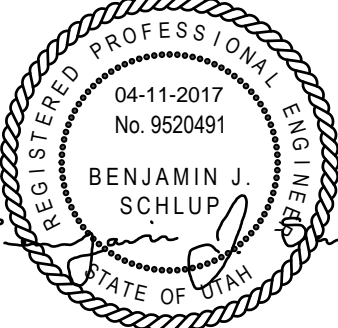

project:

Tenant Finish
for New
Brighton
Recovery
Campus
4905, 4911, 4915,
4925, 4931, & 4953
South 900 East
Salt Lake County,
Utah

date

April 11, 2017

revisions

PERMIT SET--December 28, 2016
ADDENDUM #1--January 04, 2017
ADDENDUM #3--January 11, 2017
ADDENDUM #4--January 17, 2017
ADDENDUM #5--January 20, 2017
ADDENDUM#7--February 24, 2017
ADDENDUM#8 -- March 20, 2017
ADDENDUM#9 -- April 11, 2017

data

project no:

drawn by:

checked by:


title

MECHANICAL
SCHEDULES

sheet


M11

BUILDING 'C'

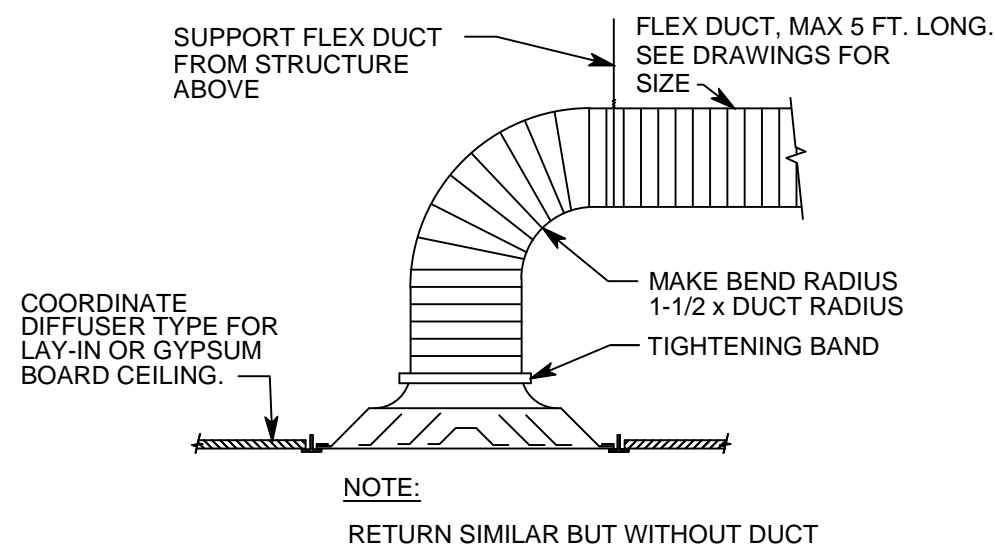

8 DIFFUSER CONNECTION

SCALE: NTS

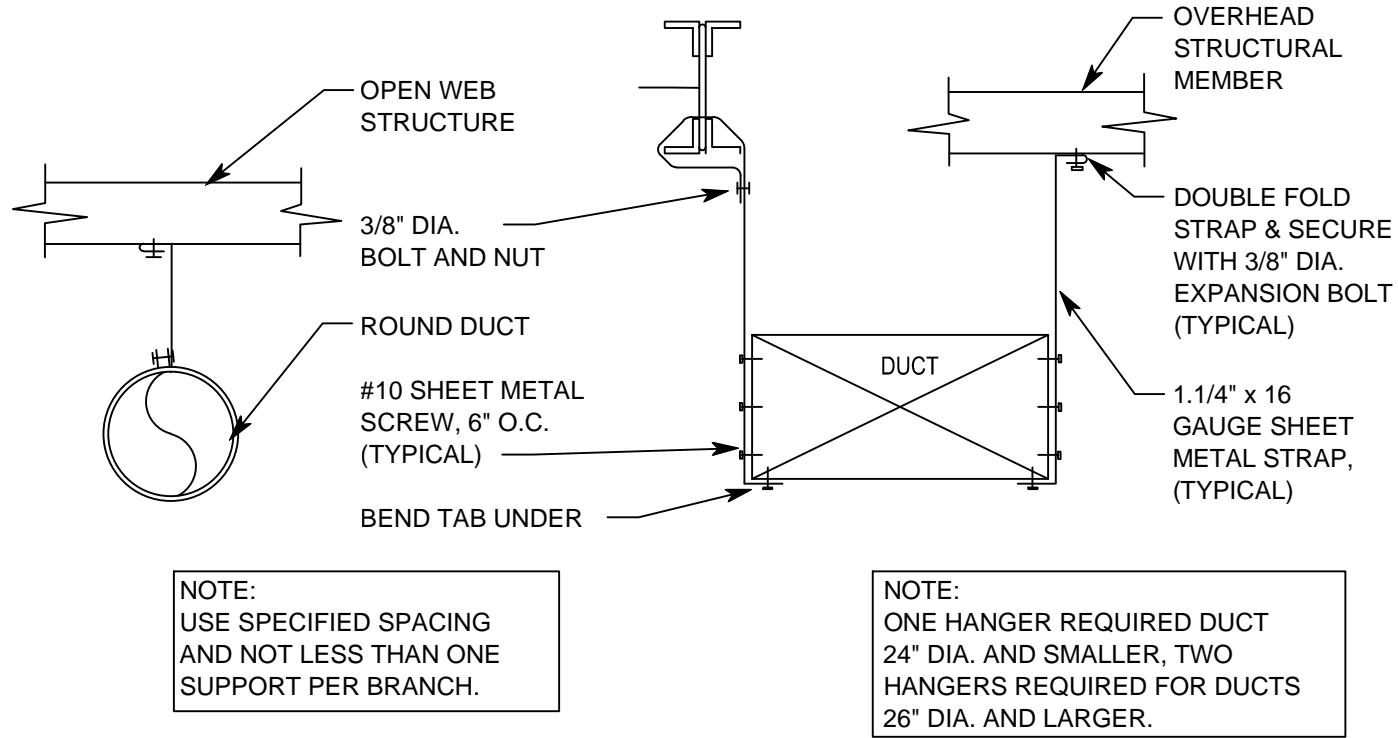

9 DUCT HANGER

SCALE: NTS


Donald L. Welch
Architect
7533 Sandy Land Lane
Midvale, Utah 84047
801.548-6391
dwlch597@msh.com



324 S. State St., Suite 400
Salt Lake City, UT 84111
800-678-7077
801-328-5151
fax: 801-328-5155
www.spectrum-engineers.com

THE DESIGNS SHOWN AND DESCRIBED HEREIN INCLUDING ALL TECHNICAL DRAWINGS, GRAPHIC REPRESENTATION & MODELS THEREOF, ARE PROPRIETARY & CAN NOT BE COPIED, DUPLICATED, OR COMMERCIALY EXPLOITED IN WHOLE OR IN PART WITHOUT THE SOLE AND EXPRESS WRITTEN PERMISSION FROM DONALD L. WELCH ARCHITECT
THESE DRAWINGS ARE AVAILABLE FOR LIMITED REVIEW AND EVALUATION BY CLIENTS CONSULTANTS, CONTRACTORS, GOVERNMENT AGENCIES, VENDORS, AND OFFICE PERSONNEL ONLY IN ACCORDANCE WITH THIS NOTICE.

consultant:

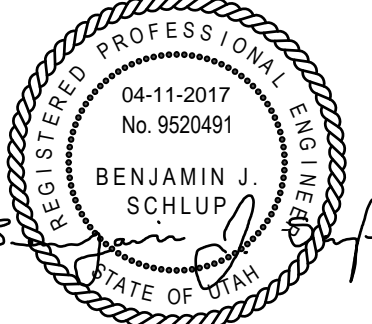

project:

Tenant Finish
for New
Brighton
Recovery
Campus
4905, 4911, 4915,
4925, 4931, & 4953
South 900 East
Salt Lake County,
Utah

date

April 11, 2017

revisions

- PERMIT SET-December 28, 2016
- ADDENDUM #1-January 04, 2017
- ADDENDUM #3-January 11, 2017
- ADDENDUM #4-January 17, 2017
- ADDENDUM #5-January 20, 2017
- ADDENDUM#7-February 24, 2017
- ADDENDUM#8 - March 20, 2017
- ADDENDUM#9 - April 11, 2017

data

project no:

drawn by:

checked by:


title

MECHANICAL
DETAILS

sheet

M12

BUILDING 'C'

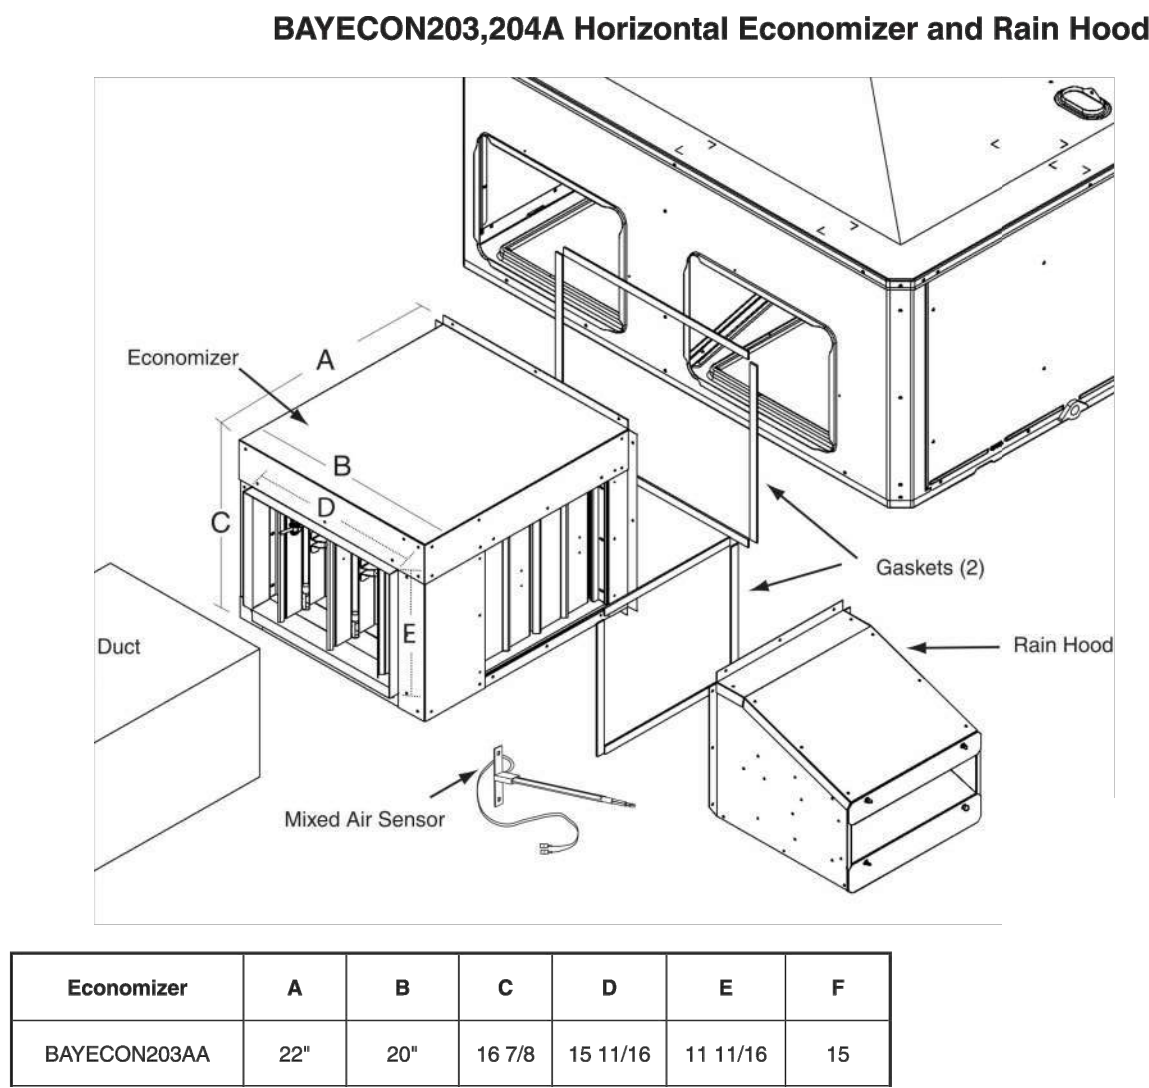

3 HORIZONTAL ECONOMIZER DETAIL (3 TON)
SCALE: NTS

Stainless Steel Drain Pan

For excellent corrosion and oxidation resistance, the optional stainless steel drain pan provides a cleanable surface that complement other IAQ solutions such as high efficiency filtration (MERV 8 or 13), demand control ventilation (CO₂), and hot gas reheat.

Powered or Unpowered Convenience Outlet



This option is a GFCI, 120V/15amp, 2 plug, convenience outlet, either powered or unpowered. This option can only be ordered when Through the Base Electrical with either the Disconnect Switch or Circuit Breaker option is ordered.
Note: Not available on 460V/575V units.

Through-the-Base Electrical Utility Access




An electrical service entrance shall be provided allowing electrical access for both control and main power connections inside the curb and through the base of the unit. Option will allow for field installation of liquid-tight conduit and an external field installed disconnect switch.



Factory provided through the base openings simplify wiring and piping. Because these utility openings frequently minimize the number of roof penetration integrity of roofing materials is enhanced.


6 RTU ACCESSORY & INSTALLATION DETAIL
SCALE: NTS

Optional Equipment
BAYOSAH001,002A, 25% Outside Air Damper
(Replaces Filter/Coil Access Panel)

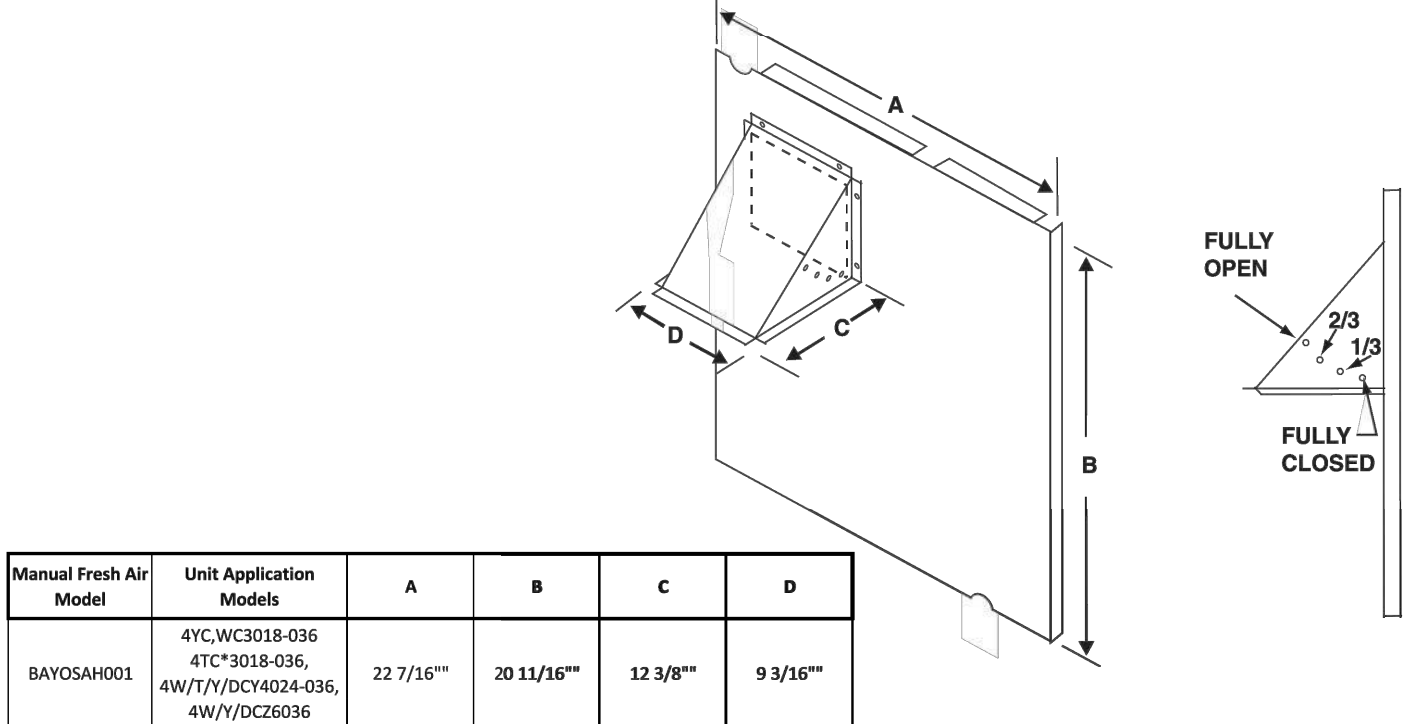

2 25% OUTSIDE AIR DAMPER (3 TON)
SCALE: NTS

Touchscreen Programmable Thermostat (2H/2C)


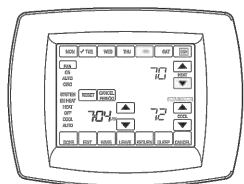


Two Heat/Two Cool programmable thermostat with touch screen digital display. Menu-driven programming. Effortless set-up. Program each day separately with no need to copy multiple days. All programming can be done on one screen. Easy to read and use. Large, clear backlit digital display.


5 RTU THERMOSTAT DETAIL
SCALE: NTS

RECOMMENDED SERVICE CLEARANCE MM/IN.		
		WITH ECONOMIZER
BACK SIDE	304.8 (12)	762.0 (30)
LEFT SIDE	762.0 (30)	914.4 (36)
RIGHT SIDE	914.4 (36)	-
FRONT SIDE	1066.8 (42)	-

CLEARANCE TO COMBUSTIBLE MATERIAL MM/IN.	
BOTTOM	0
BACK SIDE	25.4 (1)
LEFT SIDE	152.4 (6)
RIGHT SIDE	304.8 (12)
FRONT SIDE	304.8 (12)
TOP	914.4 (36)

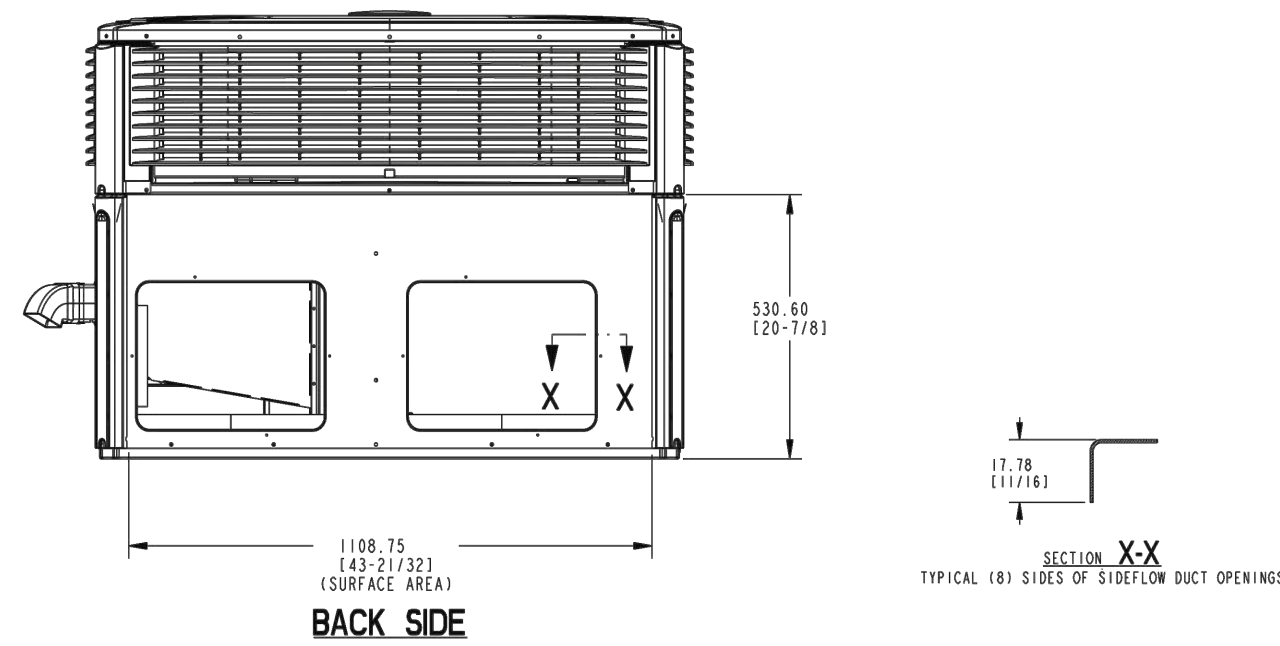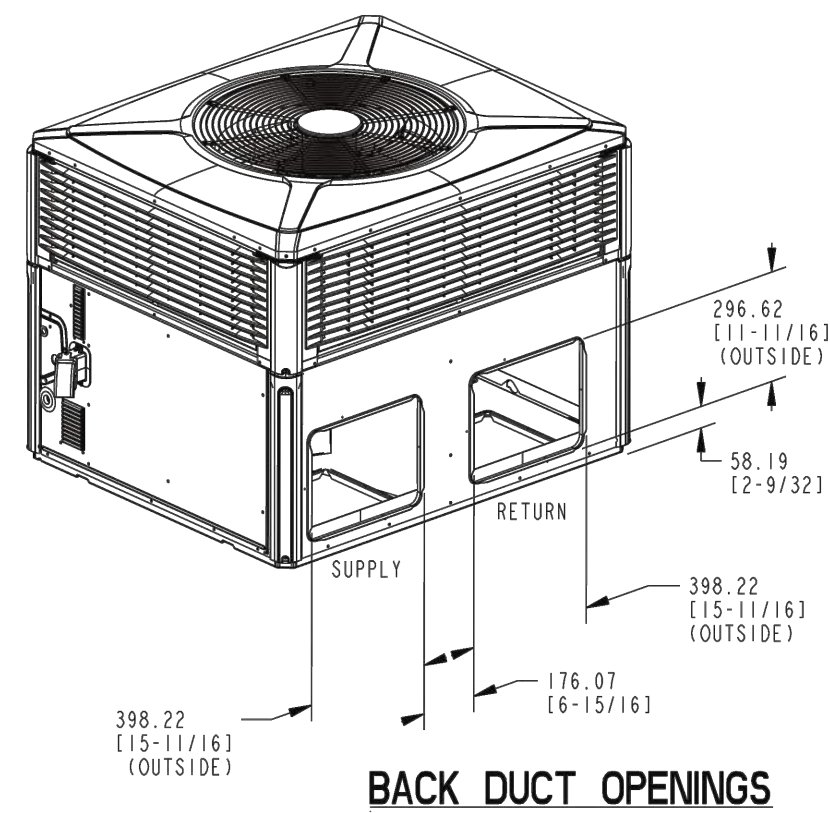

1 ROOFTOP UNIT DETAIL (3 TON)
SCALE: NTS

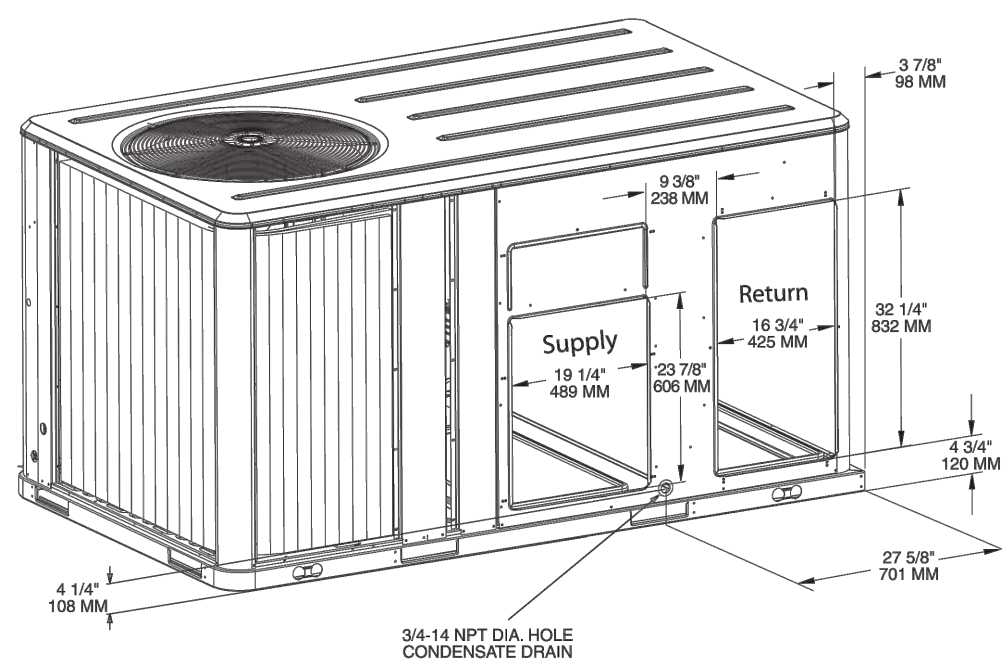

4 ROOFTOP UNIT DETAIL (4 TON)
SCALE: NTS

Donald L. Welch
Architect
7533 Sandy Land Lane
Midvale, Utah 84047
801.548-6391
dwlch5977@msn.com




324 S. State St., Suite 400
Salt Lake City, UT 84111
800-678-7077
801-328-5151
fax: 801-328-5155
www.spectrum-engineers.com

THE DESIGNS SHOWN AND DESCRIBED HEREIN INCLUDING ALL TECHNICAL DRAWINGS, GRAPHIC REPRESENTATION & MODELS THEREOF, ARE PROPRIETARY & CAN NOT BE COPIED, DUPLICATED, OR COMMERCIALY EXPLOITED IN WHOLE OR IN PART WITHOUT THE SOLE AND EXPRESS WRITTEN PERMISSION FROM DONALD L. WELCH ARCHITECT

THESE DRAWINGS ARE AVAILABLE FOR LIMITED REVIEW AND EVALUATION BY CLIENTS CONSULTANTS, CONTRACTORS, GOVERNMENT AGENCIES, VENDORS, AND OFFICE PERSONNEL ONLY IN ACCORDANCE WITH THIS NOTICE.

consultant:

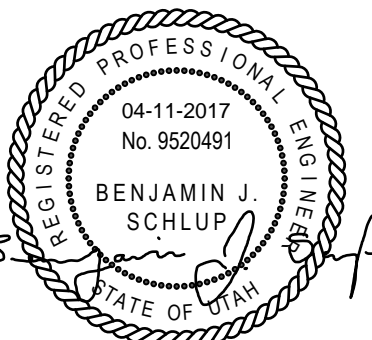

project:

Tenant Finish
for New
Brighton
Recovery
Campus
4905, 4911, 4915,
4925, 4931, & 4953
South 900 East
Salt Lake County,
Utah

date

April 11, 2017

revisions

- PERMIT SET-December 28, 2016
- ADDENDUM #1-January 04, 2017
- ADDENDUM #3-January 11, 2017
- ADDENDUM #4-January 17, 2017
- ADDENDUM #5-January 20, 2017
- ADDENDUM #7-February 24, 2017
- ADDENDUM #8 - March 20, 2017
- ADDENDUM #9 - April 11, 2017

data

project no:

drawn by:

checked by:







 
 
 



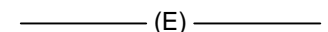
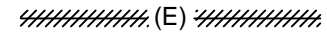
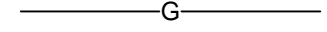

title







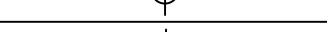
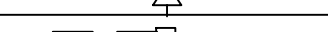
 


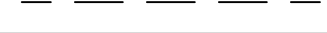

 
 




 
 


 

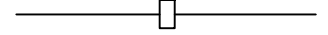
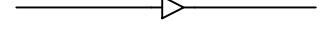



 
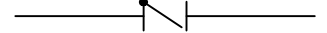














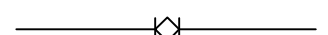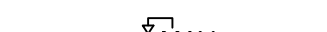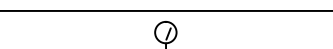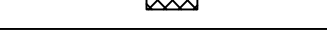

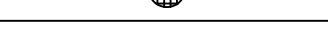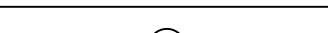MECHANICAL
DETAILS

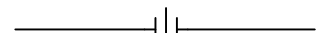sheet

  M13

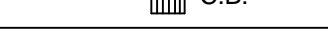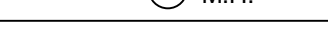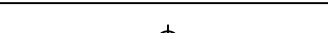BUILDING 'C'

SYMBOL LEGEND	
SYMBOL	DESCRIPTION
PLUMBING PIPING	
	SOIL, WASTE - ABOVE GRADE
	SOIL, WASTE - BELOW GRADE
	GREASE WASTE - ABOVE GRADE
	GREASE WASTE - BELOW GRADE
	VENT
	COLD WATER
	HOT WATER
	HOT WATER CIRCULATE
	STORM - ABOVE GRADE
	STORM - BELOW GRADE
	OVERFLOW STORM ABOVE GRADE
	OVERFLOW STORM BELOW GRADE
	VENT THRU ROOF
	EXISTING PIPE
	EXISTING PIPE TO BE REMOVED
	GAS

SYMBOL LEGEND	
SYMBOL	DESCRIPTION
VALVES, METERS, AND GAUGES	
	SHUT OFF VALVE
	GATE VALVE
	CHECK VALVE
	AUTO 2-WAY VALVE
	AUTO 3-WAY VALVE
	GLOBE VALVE
	BALL VALVE
	RELIEF VALVE
	CHAIN OPERATED GATE VALVE
	PRESSURE REDUCING VALVE
	BUTTERFLY VALVE
	SOLENOID VALVE
	ANGLE VALVE
	VENTURI
	BALANCING OR PLUG COCK
	FLOW SETTER
	EXPANSION VALVE (REFRIG.)
	GAS COCK
	MANUAL AIR VENT
	STRAINER
	GAUGE COCK
	FLEXIBLE CONNECTION
	PRESSURE GAUGE
	THERMOMETER
	VICTAULIC COUPLING
	REDUCER CONCENTRIC
	REDUCER ECCENTRIC
	REFRIGERANT SITE GLASS
	REFRIGERANT STRAINER
	REFRIGERANT FILTER DRIER
	90° ELBOW UP
	90° ELBOW DOWN
	90° TEE UP
	90° TEE DOWN
	UNION
	CAPPED PIPE
	ANCHOR
	FLOAT AND THERMOSTATIC TRAP
PLUMBING SYMBOLS	
	CATCH BASIN
	MANHOLE
	WALL HYDRANT
	HOSE BIBB
	CLEANOUT TO GRADE
	FLOOR CLEANOUT
	WALL CLEANOUT
	1/2 GRATE
	3/4 GRATE
	FULL GRATE

ABBREVIATIONS			
NOTE: ALL ABBREVIATIONS MAY NOT BE USED			
AD	ACCESS DOOR	MCA	MINIMUM CIRCUIT AMPS
AC	AIR CONDITION(-ING,-ED)	MFR	MANUFACTURER
APD	AIR PRESSURE DROP	MIN	MINIMUM
BD	BALANCING DAMPER	NA	NOT APPLICABLE
BHP	BRAKE HORSE POWER	NC	NORMALLY CLOSED
BTU	BRITISH THERMAL UNIT	NC	NOISE CRITERIA
BTU/H	BTU/HOUR	NIC	NOT IN CONTRACT
CFH	CUBIC FEET PER HOUR	NO	NORMALLY OPEN
CFM	CUBIC FEET PER MINUTE	NPSH	NET POSITIVE SUCTION HEAD
CLG	COOLING	NTS	NOT TO SCALE
COMP	COMPONENT	OA	OUTSIDE AIR
COND	CONDENS(-ER,-ING,-ATION)	OD	OUTSIDE DIAMETER
CV	CONTROL VALVE	OZ	OUNCE
CW	COLD WATER	PD	PRESSURE DROP
DIA	DIAMETER	PG	PROPYLENE GLYCOL
DISCH	DISCHARGE	PH	PHASE
DP	DEPTH OR DEEP	PPM	PARTS PER MILLION
DB	DRY BULB TEMPERATURE	PRESS	PRESSURE
(E)	EXISTING	PSF	POUNDS PER SQUARE FOOT
EER	ENERGY EFFICIENCY RATIO	PSI	POUNDS PER SQUARE INCH
EFF	EFFICIENCY	PSIA	PSI ABSOLUTE
EG	ETHYLENE GLYCOL	PSIG	PSI GAUGE
ELEC	ELECTRIC	R	THERMAL RESISTANCE
ELEV	ELEVATION	RA	RETURN AIR
ENT	ENTERING	RECIRC	RECIRCULATE
EVAP	EVAPORAT(-E,-ING,-ED,-OR)	REFR	REFRIGERATION
EWT	ENTERING WATER TEMP	REQD	REQUIRED
EXT	EXTERNAL	RPM	REVOLUTIONS PER MINUTE
(F)	FUTURE	RW	RAINWATER
F	FAHRENHEIT	SA	SUPPLY AIR
FC	FLEXIBLE CONNECTION	SC	SHADING COEFFICIENT
FD	FIRE DAMPER	SCW	SOFT COLD WATER
FLA	FULL LOAD AMPS	SF	SAFETY FACTOR
FPI	FINS PER INCH	SH	SENSIBLE HEAT
FFM	FEET PER MINUTE	SL	SEA LEVEL
FPS	FEET PER SECOND	SP	STATIC PRESSURE
FSD	FIRE SMOKE DAMPER	SPEC	SPECIFICATION
FT	FEET	SQ	SQUARE
GAL	GALLON(S)	STD	STANDARD
GPH	GALLONS PER HOUR	STM	STEAM
GPM	GALLONS PER MINUTE	TEMP	TEMPERATURE
HD	HEAD	TD	TEMP. DROP OR DIFF.
HG	MERCURY	TOT	TOTAL
HR	HOUR	TSTAT	THERMOSTAT
HT	HEIGHT	V	VENT
HTG	HEATING	VAC	VACUUM
HP	HORSE POWER	VAV	VARIABLE AIR VOLUME
HW	HOT WATER	VEL	VELOCITY
HZ	HERTZ(FREQUENCY)	VENT	VENT, VENTILATION
ID	INSIDE DIAMETER	VERT	VERTICAL
IN	INCH	VOL	VOLUME
KW	KILOWATT	WC	WATER COLUMN
LAT	LEAVING AIR TEMPERATURE	WG	WATER GAUGE
LBS	POUNDS	WPD	WATER PRESSURE DROP
LG	LENGTH	WTR	WATER
LH	LATENT HEAT	WT	WEIGHT
LRA	LOCKED ROTOR AMPS	WB	WET BULB TEMP
LVG	LEAVING		
LWT	LEAVING WATER TEMP		
MAX	MAXIMUM		
MBH	THOUSAND BTU PER HOUR		

SYMBOL LEGEND	
SYMBOL	DESCRIPTION
REFERENCE AND LINE SYMBOLS	
	DETAIL INDICATOR: # INDICATES DETAIL NUMBER, SHEET INDICATES DRAWING SHEET WHERE DETAIL IS SHOWN.
	ROOM OR SPACE NUMBER.
	KEYNOTE INDICATOR.
	REVISION INDICATOR.
	EQUIPMENT INDICATOR.
	PLUMBING FIXTURE INDICATOR.
	DIFFUSER/GRILLE INDICATOR.
	DIFFUSER/GRILLE INDICATOR.
	BREAK, STRAIGHT
	BREAK, ROUND.
	MATCH LINE SEE XXX-XXX
	HIDDEN FEATURES LINE: HIDDEN, THIN LINE.
	CONTRACT LIMIT LINE: DASHDOT, WIDE LINE.
	NEW CONNECTION POINT TO EXISTING

PLUMBING SCOPE OF WORK	
DEMOLITION NOTES:	
PLUMBING CONTRACTOR TO UTILIZE SELECTIVE DEMOLITION APPROACH. MANY AREAS INCLUDE PLUMBING EQUIPMENT AND ACCESSORIES LOCATED ABOVE HARDLID CEILINGS OR WITHIN INACCESSIBLE SPACES. FIELD TRACING OF DEMOLITION IS REQUIRED.	
ALL EXISTING PLUMBING FIXTURES AND ACCESSORIES ARE TO BE REMOVED TO ALLOW FOR NEW TENANT SPACES. ALL PLUMBING EQUIPMENT, FIXTURES, PIPING, AND ACCESSORIES THAT ARE CURRENTLY ABANDONED IN PLACE ARE TO BE REMOVED.	
ALL STORM WATER / ROOF DRAINAGE PIPING WITHIN THE BUILDING IS TO REMAIN UNCHANGED.	
EXISTING GAS METERS TO REMAIN. EXISTING GAS PIPING SEGMENTS MAY BE REUSED IF SIZING AND ROUTING ARE SIMILAR TO NEW PIPING LAYOUT. PUBLIC UTILITY COMPANY TO VERIFY NATURAL GAS CAPACITIES AND ASSOCIATED PRESSURES.	
CAP/REPLACE ALL WASTE AND VENT LINES BACK TO NEAREST MAIN TO ALLOW FOR FUTURE CONNECTIONS.	
NEW CONSTRUCTION NOTES:	
NEW WATER ENTRIES WILL BE INSTALLED AS INDICATED ON PLANS.	
ALL DOMESTIC COLD WATER AND FIRE WATER PIPING SEGMENTS EXPOSED TO ENVIRONMENT ARE TO BE INSULATED AND HEAT TRACED FOR FREEZE PROTECTION.	
ALL EXISTING STORM DRAIN TERMINATIONS ARE TO CONNECT TO CIVIL DRAINAGE SYSTEM.	
ALL GREASE WASTE PIPING DESIGNATED TO SERVE FUTURE WARMING KITCHEN WILL TIE INTO NEW GREASE INTERCEPTOR AS SHOWN ON CIVIL DRAWINGS. A VENT LINE FOR THE GREASE INTERCEPTOR WILL BE PROVIDED AND WILL TERMINATE THROUGH ROOF OF BUILDING 'D'.	
THE NEW SYSTEM COMPONENTS WILL ALLOW FOR FUTURE OFFICE AND TEMPORARY RESIDENT SPACES AS INDICATED ON PLANS.	
DOMESTIC WATER, WASTE, AND GREASE WASTE LINES (AS APPLICABLE) WILL BE PROVIDED TO EACH BUILDING AS INDICATED.	
HEATING OF DOMESTIC WATER WILL BE PROVIDED BY INDIVIDUAL BUILDING WATER HEATERS.	
DOMESTIC COLD WATER SUBMETERS TO BE INSTALLED IN EACH BUILDING'S WATER ENTRY ROOM. VERIFY NEED WITH OWNER PRIOR TO INSTALLATION.	

FIRE PROTECTION SCOPE OF WORK	
NEW CONSTRUCTION NOTES:	
NEW FIRE ENTRIES TO BE INSTALLED AS INDICATED ON PLANS.	
FIRE PROTECTION LINES TO BE ROUTED ON WARM SIDE OF BUILDING INSULATION.	
INSTALL FIRE PROTECTION SYSTEM PER NOTES INDICATED ON P02 OF THIS DRAWING SET.	
ALL BREEZEWAY SOFFITS TO INCORPORATE DRY PIPE FIRE PROTECTION SYSTEM FED FROM FIRE ENTRY ROOM PIPING AS REQUIRED.	
IN THE EVENT THAT ROUTING MAY PROVE DIFFICULT DUE TO EXISTING CONDITIONS A DRY-PIPE SYSTEM SHOULD BE EVALUATED. LOCATE AIR COMPRESSOR IN ASSOCIATED FIRE ENTRY ROOM AS REQUIRED.	
SEE SHEET P02 (SPEC SECTION 221316) AND SHEET P13 FOR FURTHER SYSTEM REQUIREMENTS & DETAILS.	
DIVISION 26 CONTRACTOR TO PROVIDE POWER TO ASSOCIATED SYSTEM FLOW SWITCH.	


Donald L. Welch
Architect
7533 Sandy Land Lane
Midvale, Utah 84047
801.548-6391
dwelch5977@nsh.com



324 S. State St., Suite 400
Salt Lake City, UT 84111
800-678-7077
801-328-5151
fax: 801-328-5155
www.spectrum-engineers.com

THE DESIGNS SHOWN AND DESCRIBED HEREIN INCLUDING ALL TECHNICAL DRAWINGS, GRAPHIC REPRESENTATION & MODELS THEREOF, ARE PROPRIETARY & CAN NOT BE COPIED, DUPLICATED, OR COMMERCIALY EXPLOITED IN WHOLE OR IN PART WITHOUT THE SOLE AND EXPRESS WRITTEN PERMISSION FROM DONALD L. WELCH ARCHITECT. THESE DRAWINGS ARE AVAILABLE FOR LIMITED REVIEW AND EVALUATION BY CLIENTS CONSULTANTS, CONTRACTORS, GOVERNMENT AGENCIES, VENDORS, AND OFFICE PERSONNEL ONLY IN ACCORDANCE WITH THIS NOTICE.

consultant:

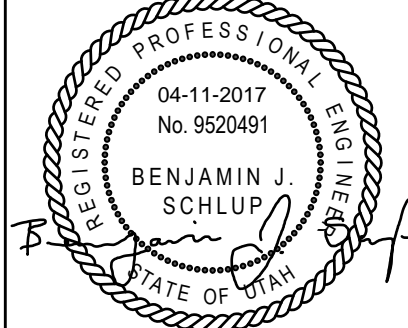

project:

Tenant Finish
for New
Brighton
Recovery
Campus
4905, 4911, 4915,
4925, 4931, & 4953
South 900 East
Salt Lake County,
Utah

date

April 11, 2017

revisions

- △ PERMIT SET-December 28, 2016
- △ ADDENDUM #1-January 04, 2017
- △ ADDENDUM #3-January 11, 2017
- △ ADDENDUM #4-January 17, 2017
- △ ADDENDUM #5-January 20, 2017
- △ ADDENDUM#7-February 24, 2017
- △ ADDENDUM#8 - March 20, 2017
- △ ADDENDUM#9 - April 11, 2017

data

project no:

drawn by:

checked by:

title

PLUMBING
GENERAL NOTES
& LEGEND
sheet

P01

BUILDING 'C'

PLUMBING SPECIFICATIONS

2220100 - BASIC PIPING MATERIALS & METHODS

- CORE CUT ALL PIPE PENETRATION OF EXISTING MASONRY OR CONCRETE WALLS AND FLOORS. SLEEVE ALL PENETRATIONS THROUGH NEW WALLS AND FLOORS. SEAL ALL PENETRATIONS WATER TIGHT WITH SILICONE SEALANT. USE FIRE RATED SEALANT (3M "FIRE BARRIER" OR EQUAL) FOR 1 HOUR OR 2 HOUR PENETRATIONS.
- CAULK AROUND ALL PIPING THAT PASSES THROUGH FIRE-RATED PARTITIONS WITH A NON-HARDENING CAULKING SIMILAR TO 3M "FIRE BARRIER".
- SEAL ALL PIPING THROUGH WALLS AIR TIGHT.

2220533 - HEAT TRACING CABLE

- PROVIDE RAYCHEM ELECTRIC SELF REGULATING HEATING CABLE WITH ALL NECESSARY ACCESSORIES TO MAINTAIN THE TEMPERATURE IN THE TRACED PIPE SYSTEM AT 45°F.
- FOR DOMESTIC HOT WATER USE, THE CABLE SHALL BE DESIGNED, MANUFACTURED AND U.L. LISTED FOR DOMESTIC HOT WATER TEMPERATURE MAINTENANCE.
- CABLE SHALL CONSIST OF TWO (2) 16-AWG NICKEL-COATED COPPER BUS WIRES EMBEDDED IN A RADIATION-CROSSLINKED CONDUCTIVE POLYMER CORE. IT SHALL BE COVERED BY A RADIATION-CROSSLINKED, POLYOLEFIN, DIELECTRIC JACKET SURROUNDED BY A POLYMER-COATED ALUMINUM WRAP, AND ENCLOSED IN A TINNED COPPER BRAID OF 14 AWG EQUIVALENT WIRE SIZE. THE BRAID SHALL BE COVERED WITH A (NOMINAL) 40-MIL POLYOLEFIN OUTER JACKET, COLOR CODED FOR EASY IDENTIFICATION.

2220548 - VIBRATION ISOLATION AND SEISMIC

- ALL PLUMBING EQUIPMENT AND PIPING MUST BE VIBRATION ISOLATED AND SEISMICALLY BRACED FOR THE SITE SPECIFIC SEISMIC DESIGN CATEGORY AND SEISMIC USE GROUP, IN ACCORDANCE WITH THE LATEST ADOPTED EDITIONS OF THE BUILDING CODES AND ASHRAE. PROVIDE SEISMIC PRODUCTS BY AMBER-BOOTH OR MASON INDUSTRIES.
- IN GENERAL, PROVIDE SPRING MOUNTS TO ATTENUATE LOW FREQUENCY SOUND AND VIBRATION. PROVIDE NEOPRENE PADS TO ATTENUATE HIGH FREQUENCY SOUND
- VIBRATION: SEISMIC BRACING/MOUNTING CAN BE COMBINED WITH VIBRATION ISOLATION AS APPLICABLE.
- CONTRACTOR MANUFACTURED SEISMIC BRACING/RESTRAINT METHODS ARE NOT ACCEPTABLE.
- PROVIDE A SIGNED AND STAMPED LETTER FROM A PROFESSIONAL ENGINEIER CERTIFYING THAT THE SUPPLIED PRODUCTS ARE CORRECT FOR THE APPLICATION AND THAT THE INSTALLATION IS IN COMPLIANCE WITH ALL APPLICABLE CODES.

2220719 - INSULATION

- PIPE INSULATION: SNAP-ON GLASS FIBER TYPE WITH VAPOR JACKET. SEAL ALL ENDS AND JOINTS TO PROVIDE A COMPLETELY SEALED SYSTEM. ALTERNATIVELY, FOR INTERIOR WATER PIPING, USE FLEXIBLE UNICELLULAR ASTM 534 TYPE 1 INSULATION. USE 1" THICKNESS FOR PIPE UP TO 2"Ø AND 1-1/2" FOR PIPE OVER 2"Ø
- PROVIDE ADA COMPLIANT FIXTURES WITH SNAP ON ADA ARTICLE 4.19 22FF COMPLIANT WHITE INSULATION. TRUEBRO NV GUARD, BASIN GUARD OR LAV SHIELD.
- THERMAL AND SOUND INSULATION AND COVERING WHICH ARE INSTALLED AND EXPOSED SPACES AND COVERING PIPE AND TUBING SHALL BE TESTED IN ACCORDANCE WITH ASTM E 84 AND HAVE A FLAME SPREAD OF 0-25 AND A SMOKE INDEX OF 0-450.
- THERMAL AND SOUND INSULATION AND COVERING OVER PIPE AND TUBING WHICH ARE INSTALLED IN CONCEALED PLENUM SPACES SHALL BE TESTED IN ACCORDANCE WITH ASTM E 84 AND HAVE A FLAME SPREAD OF 0-25 AND A SMOKE INDEX OF 0-50.

2221116 - WATER DISTRIBUTION PIPING

- UNDERGROUND WATER PIPING:

2" AND SMALLER:
ASTM 88 TYPE "K" COPPER WITH A MINIMUM NUMBER OF SOLDERED JOINTS. USE 95-5 TIN ANTIMONY COPPER SOLDER.

2-1/2" AND LARGER:
PVC AWWA 900 CLASS 100 WITH SOLVENT CEMENTED JOINTS, OR PB PLASTIC PIPE ASTM D3309 SDR 11 WITH HEAT FUSION JOINTS.
- NO TYPE "M" OR "DWV" COPPER IS TO BE USED IN THIS PROJECT.
- ALL ABOVE GROUND HOT AND COLD WATER PIPING:
ASTM B 88 TYPE "L" COPPER, WITH WROUGHT COPPER FITTINGS AND SOLDERED WITH 95-5 TIN-ANTIMONY SOLDER.
- INSTALL PIPE HANGERS WITH THE FOLLOWING MINIMUM ROD SIZES AND MAXIMUM SPACING. UPON COMPLETION OF HANGER INSTALLATION, ALL ADJUSTMENTS HAVING THE POSSIBILITY OF TURNING SHALL BE LOCKED SECURELY IN PLACE BY DOUBLE NUTTING AT THE HANGER ROD ATTACHMENT TO THE STRUCTURE, AND AT THE PIPE HANGER.

NOM. PIPE SIZE-INCHES	MAX SPAN-FT.	MIN. ROD SIZE-INCHES
1	7	3/8
1-1/2	9	3/8
2	10	3/8
3	12	1/2
4	14	5/8
6	17	3/4
- ALL PIPE HANGERS AND EQUIPMENT SUPPORTS SHALL BE LOCATED A MINIMUM DISTANCE OF 2" FROM ANY REFRIGERANT PIPE.
- ALL PLUMBING FIXTURES CONNECTED TO A POTABLE WATER SYSTEM WITH HOSE CONNECTIONS ON THE OUTLET SIDE AND OWNER FURNISHED EQUIPMENT WITH DIRECT CONNECTIONS, SHALL BE PROVIDED WITH BACKFLOW PREVENTION.

PLUMBING SPECIFICATIONS

2221316 - DRAINAGE AND VENT SYSTEMS

- UNDERGROUND BUILDING DRAIN PIPE AND FITTINGS:
A. NO HUB ABS OR PVC PLASTIC PIPE AND FITTINGS PER ASTM D2661 WITH ASTM D2235 SOLVENT OR
B. ASTM A74 SERVICE WEIGHT, HUB AND SPIGOT CAST IRON SOIL PIPE, OR ASTM A888 (OR CISPI 301) HUBLESS CAST IRON SOIL PIPE WITH ASTM C564 HEAVY DUTY SHIELDED STAINLESS STEEL COUPLINGS.

A. NO ASTM D2729 PIPE SHALL USED UNDERGROUND.
- ABOVE GROUND SANITARY DRAINAGE AND VENT PIPING, IN ALL AREAS EXCEPT AIR PLENUMS AND EXCEPT IN A FIRE RATED BUILDING, SHALL BE ABS TYPE DWV PLASTIC PIPE AND FITTINGS PER ASTM D2661 WITH ASTM D2265 SOLVENT, OR PVC PLASTIC PIPE AND FITTINGS PER ASTM D2665 WITH ASTM D2564 SOLVENT, OR SERVICE WEIGHT, NO HUB CAST IRON COUPLED PIPE AND FITTINGS WITH COMPRESSION TYPE NEOPRENE GASKETS AND STAINLESS STEEL BANDS.
- FORCE SEWER MAINS UP TO 4" SHALL BE TYPE L HARD COPPER TUBE WITH WROUGHT COPPER PRESSURE FITTINGS AND SOLDERED JOINTS, OR DUCTILE IRON PIPE AND FITTINGS WITH MECHANICAL JOINTS.
- ALL SANITARY DRAINAGE AND VENT PIPING INSIDE AIR PLENUMS AND ANYWHERE IN A FIRE RATED BUILDING SHALL BE NO HUB SERVICE WEIGHT CAST IRON COUPLED PIPE AND FITTINGS WITH COMPRESSION TYPE NEOPRENE GASKETS AND STAINLESS STEEL BANDS. ASTM B306 COPPER PIPE MAY BE USED WITH SOLDERED JOINTS FOR PIPE 3" AND SMALLER.
- ABOVE GROUND ROOF DRAIN LINES, EXCEPT IN AIR PLENUMS AND ANYWHERE IN A FIRE RATED BUILDING, SHALL BE ABS TYPE DWV PLASTIC PIPE AND FITTINGS PER ASTM D2661 WITH ASTM D2255 SOLVENT, OR PV C PLASTIC PIPE PER ASTM D2665 WITH ASTM D2564 SOLVENT.
- ALL ROOF DRAIN LINES INSIDE AIR PLENUMS, OR ANYWHERE IN A FIRE RATED BUILDING, SHALL BE SERVICE WEIGHT CAST IRON PIPE TO CISPI STANDARD 301.
- ALL ROOF DRAIN LINES SHALL BE FULLY INSULATED.
- OVERFLOW ROOF DRAINS SHALL DAYLIGHT 18" ABOVE THE SURROUNDING HORIZONTAL AREA.
- INSTALL SANITARY DRAIN LINES 2-1/2" AND LESS WITH A SLOPE OF 2%. INSTALL SANITARY DRAIN LINES 3"-6" WITH A SLOPE OF NOT LESS THAN 1%.
- SLOPE ROOF DRAIN LINES DOWN IN DIRECTION OF FLOW, 1/8" PER FOOT (1%).
- CLEANOUTS

A. FINISHED WALL CLEANOUTS: SMITH FIGURE 4472 COMPLETE WITH CAST BRONZE TAPER THREADED PLUG, STAINLESS STEEL COVER AND SCREW.
B. FLOOR CLEANOUTS (UNFINISHED AREAS): SMITH FIGURE 4223 DUCO CAST IRON CLEANOUT WITH ROUND ADJUSTABLE SCORIATED SECURED CAST IRON TOP, TAPER THREADED BRONZE PLUG AND SPIGOT OUTLET.
C. FINISHED FLOOR CLEANOUTS (CONCRETE FLOORS): SMITH FIGURE 4023 DUCO CAST IRON CLEANOUT WITH ADJUSTABLE SCORIATED SECURED NICKEL BRONZE TOP, TAPER THREADED CAST BRONZE PLUG AND SPIGOT OUTLET.
D. FINISHED FLOOR CLEANOUTS (CARPETED FLOORS): SMITH FIGURE 4023-Y SAME AS CONCRETE FLOORS WITH CARPET MARKER
E. FINISHED FLOOR CLEANOUTS (TILE FLOORS): SMITH FIGURE 4163 DUCO CAST IRON CLEANOUT WITH SQUARE ADJUSTABLE SECURED NICKEL BRONZE TOP WITH 1/8" RECESS, TAPER THREADED BRONZE PLUG AND SPIGOT OUTLET.
F. EXTERIOR CLEANOUTS (CLEANOUT TO GRADE): SMITH FIGURE 4253 DUCO CAST IRON CLEANOUT AND DOUBLE FLANGED HOUSING WITH HEAVY DUTY SECURED SCORIATED CAST IRON COVER WITH LIFTING DEVICE, TAPER THREADED BRONZE PLUG AND SPIGOT OUTLET.
- FLOOR DRAINS:

FD-1 FLOOR DRAIN: SMITH FIGURE 2010-BP CAST IRON BODY AND FLASHING COLLAR WITH PROTECTIVE CAP AND SQUARE NICKEL BRONZE ADJUSTABLE STRAINER HEAD WITH SECURED SQUARE HOLE GRATE, AND TRAP PRIMER CONNECTION.

FD-2 MECHANICAL ROOM DRAIN: SMITH FIGURE 2110-NB MEDIUM DUTY FLOOR DRAIN. CAST IRON BODY AND FLASHING COLLAR WITH NICKEL BRONZE BAR GRATE.
- ROOF DRAINS (AS REQUIRED IF REPLACEMENT IS NECESSARY)

RD-1 ROOF DRAIN: SMITH FIGURE 1010-ERC CAST IRON BODY WITH COMBINED FLASHING CLAMP AND CAST IRON GRAVEL STOP, CAST IRON DOME, EXTENSION, SUMP RECEIVER AND UNDERDECK CLAMP.

ORD-1 OVERFLOW ROOF DRAIN: SMITH FIGURE 1080-ERC CAST IRON BODY WITH FLASHING CLAMP, GRAVEL STOP, CAST IRON DOME, 2" HIGH CAST IRON WATER COLLAR, EXTENSION, SUMP RECEIVER AND UNDERDECK CLAMP.

DSN-1 DOWNSPOUT NOZZLE: SMITH FIGURE 1770 DOWNSPOUT NOZZLE. CAST BRONZE BODY AND FLANGE. PROVIDE BRONZE BOLTS TO SECURE NOZZLE TO WALL. INSTALL 12" ABOVE FOUNDATION UNLESS NOTED OTHERWISE.
- FIRE/WATER ENTRIES

FIRE ENTRY: WATTS 757DCDA OSY OR EQUAL. DOUBLE CHECK DETECTOR ASSEMBLY. TWO INDEPENDENTLY OPERATING TRI-LINK CHECK VALVES, TWO SHUTOFF VALVES, AND FOUR TEST COCKS. STAINLESS STEEL HOUSING AND SLEEVE. MAXIMUM WORKING PRESSURE: 175PSI. PROVIDE FLOW SWITCH WITH LINE VOLTAGE POWER.

DOMESTIC WATER ENTRY: WATTS LF909 OR EQUAL. LEAD FREE REDUCED PRESSURE ZONE ASSEMBLY. HORIZONTAL OR VERTICAL (UP OR DOWN) INSTALLATION. TEMPERATURE RANGE: 33°F - 140°F. MAXIMUM WORKING PRESSURE: 175PSI. TEMPERATURE RANGE: 33°F - 210°F. MAXIMUM WORKING PRESSURE: 175PSI (FOR MAIN SERVICE WATER ENTRY APPLICATIONS)

DOMESTIC WATER DOUBLE CHECK: WATTS LF719 OR EQUAL. LEAD FREE DOUBLE CHECK VALVE ASSEMBLY. SEPARATE ACCESS, TOP ENTRY CHECK VALVE, REVERSIBLE SEAT DISC RUBBER, VALVE TEST COCKS, TEMPERATURE RANGE: 33°F - 180°F. MAXIMUM WORKING PRESSURE: 175PSI (FOR APPLICATIONS DOWNSTREAM OF WATER ENTRY PRESSURE REDUCING VALVE)

PLUMBING SPECIFICATIONS

2221613 - NATURAL GAS SYSTEMS

- NATURAL GAS PIPING ABOVE GROUND OR INSIDE BUILDINGS: SCHEDULE 40 BLACK STEEL WITH WELDED OR MALLEABLE IRON FITTINGS.
- UNDERGROUND GAS PIPE: EITHER POLYETHYLENE ASTM D2513, OR SCHEDULE 40 BLACK STEEL PRIMED AND WRAPPED IN ACCORDANCE WITH LOCAL GAS COMPANY REQUIREMENTS.
- GAS MAINS INSIDE BUILDINGS ARE SIZED FOR 2 PSIG PRESSURE. LOCATE PRESSURE REGULATORS AS SHOWN ON THE DRAWINGS TO REDUCE PRESSURE FROM 2 PSIG TO 7" W.G. PROVIDE FULL SIZE VENT LINES FROM GAS PRESSURE REGULATORS AND EXTEND TO OUTSIDE OR THROUGH ROOF. FLASH PENETRATIONS AND MAKE WATER TIGHT. INSTALL VENTLESS GAS REGULATOR AS ALTERNATE.
- PROVIDE GAS SHUT OFF VALVE AT EACH PIECE OF GAS UTILIZING EQUIPMENT.
- THE EQUIPMENT INSTALLER SHALL APPLY AND SIGN A CERTIFICATION LABEL TO EACH GAS-FIRED APPLIANCE, STATING THE APPLIANCE HAS BEEN ADJUSTED OR MODIFIED PER MANUFACTURER'S REQUIREMENTS FOR OPERATION AT THE PROJECT ALTITUDE AND WITH THE BTU-CONTENT OF THE AVAILABLE FUEL-GAS.

223000 - WATER HEATERS

- INSTALL UNITS PLUMB AND LEVEL AND FIRMLY ANCHORED PER SEISMIC REQUIREMENTS. MAINTAIN MANUFACTURER'S RECOMMENDED CLEARANCES. ORIENT SO CONTROLS AND DEVICES NEEDING SERVICING ARE ACCESSIBLE.
- CONNECT HOT AND COLD WATER PIPING TO UNITS WITH SHUT-OFF VALVES AND UNIONS. CONNECT HOT WATER CIRCULATING PIPING TO UNIT WITH SHUT-OFF VALVE, CHECK VALVE AND UNION.
- USE DIELECTRIC FITTINGS AND UNIONS WHERE PIPING CONNECTIONS ARE DISSIMILAR METALS.
- INSTALL VACUUM RELIEF VALVE IN COLD WATER INLET PIPING. EXTEND RELIEF VALVE DISCHARGE TO CLOSEST FLOOR DRAIN. INSTALL DRAIN AS INDIRECT WASTE TO SPILL INTO OPEN DRAIN OR OVER FLOOR DRAIN.
- PROVIDE AND INSTALL EXPANSION TANK AS SCHEDULED IN DRAWINGS.

EXPANSION TANK: DIAPHRAGM TYPE, PRE- PRESSURIZED STEEL TANK WITH RELIEF VALVE SETTING @ 120 PSI MAXIMUM PRESSURE.
- CONNECT GAS SUPPLY PIPING TO BURNER WITH DRIP LEG, TEE, GAS COCK, AND UNION, MINIMUM SIZE SAME AS INLET CONNECTION. INSTALL GAS PRESSURE REGULATORS WHERE INDICATED.
- CONNECT OIL PIPING TO OIL BURNER WITH SHUT-OFF VALVE AND UNION IN SUPPLY AND CHECK VALVE AND UNION IN RETURN PIPING.
- ELECTRICAL CONNECTIONS: POWER WIRING AND DISCONNECT SWITCHES ARE SPECIFIED IN DIVISION 16. CONNECT UNIT COMPONENTS TO GROUND IN ACCORDANCE WITH THE NATIONAL ELECTRICAL CODE.
- VENT CONNECTIONS: CONNECT GAS FIRED WATER HEATER DRAFT HOOD TO VENT SYSTEM, UNLESS OTHERWISE INDICATED, PROVIDE VENT SAME SIZE AS OUTLET ON HEATER. COMPLY WITH GAS UTILITY REQUIREMENTS.
- CONNECT OIL-FIRED WATER HEATER VENT AND DRAFT REGULATOR TO VENT SYSTEM. PROVIDE VENT AND DRAFT REGULATOR SAME SIZE AS OUTLET ON HEATER.
- PROVIDE SEALED COMBUSTION SYSTEMS WITH CONNECTIONS FOR OUTSIDE COMBUSTION AIR.
- PROVIDE CONCENTRIC VENT TERMINATION KIT FOR ROOF OR WALL APPLICATIONS.
- PROVIDE PVC COMBUSTION AIR AND VENT PIPING FROM WATER HEATER TO TERMINATION KIT.
- PROVIDE CONDENSATE DRAIN FROM WATER HEATER OR VENT AS REQUIRED.

PLUMBING SPECIFICATIONS

2224213 - PLUMBING FIXTURES

- PROVIDE AND INSTALL CARRIERS AS REQUIRED FOR FLOOR OR WALL MOUNTED PLUMBING FIXTURES. INSTALL ALL FIXTURES WITH ACCESSORIES AS REQUIRED TO PROVIDE A COMPLETE, WORKABLE INSTALLATION.
- PLUMBING FIXTURES SHALL INCLUDE COMPRESSION STOPS ABOVE FLOOR IN SUPPLIES TO ALL FIXTURES AND A MINIMUM 17 GAUGE P-TRAP.
- ALL LAVATORIES AND HAND SINKS WILL HAVE A COMBINATION FAUCET OR PREMIXING FAUCET CAPABLE OF SUPPLYING WARM WATER FOR A MINIMUM OF 10 SECONDS.
- ALL JANITORIAL SINK FAUCETS MUST BE PROVIDED WITH AN APPROVED BACKFLOW PREVENTION DEVICE.
- FLOOR DRAINS AND FLOOR SINKS ARE SHOWN IN THE APPROXIMATE LOCATION. COORDINATE FINAL LOCATION WITH EQUIPMENT AND DRAINAGE REQUIREMENTS. PROVIDE BLOCKOUTS AS NECESSARY.

PENETRATION FIRESTOPPING NOTES

- CONTRACTOR SHALL REVIEW CONSTRUCTION DOCUMENTS AND PROVIDE SPECIFIC FIRESTOPPING DETAILS FROM A SPECIFIC FIRESTOPPING MANUFACTURER FOR EACH MECHANICAL (HVAC) AND PLUMBING PIPE OR DUCT PENETRATION FOR EACH FIRE RATED ASSEMBLY.
- PROVIDE PENETRATION FIRESTOPPING THAT IS PRODUCED AND INSTALLED TO RESIST SPREAD OF FIRE ACCORDING TO REQUIREMENTS INDICATED, RESIST PASSAGE OF SMOKE AND OTHER GASES, AND MAINTAIN ORIGINAL FIRE-RESISTANCE RATING OF CONSTRUCTION PENETRATED.
- PENETRATION FIRESTOPPING SYSTEMS SHALL BE COMPATIBLE WITH ONE ANOTHER, WITH THE SUBSTRATES FORMING OPENINGS, AND WITH PENETRATING ITEMS IF ANY.
- PENETRATIONS IN FIRE-RESISTANCE-RATED WALLS: PROVIDE PENETRATION FIRESTOPPING WITH RATINGS DETERMINED PER ASTM E 814 OR UL 1479, BASED ON TESTING AT A POSITIVE PRESSURE DIFFERENTIAL OF 0.01-INCH WG
- PENETRATION FIRESTOPPING PRODUCTS SHALL BEAR UL, ETL OR FM GLOBAL CLASSIFICATION MARKING OF QUALIFIED TESTING AND INSPECTING AGENCY.
- DO NOT INSTALL PENETRATION FIRESTOPPING WHEN AMBIENT OR SUBSTRATE TEMPERATURES ARE OUTSIDE LIMITS PERMITTED BY PENETRATION FIRESTOPPING MANUFACTURERS OR WHEN SUBSTRATES ARE WET BECAUSE OF RAIN, FROST, CONDENSATION, OR OTHER CAUSES.
- COORDINATE CONSTRUCTION OF OPENINGS AND PENETRATING ITEMS TO ENSURE THAT PENETRATION FIRESTOPPING IS INSTALLED ACCORDING TO SPECIFIED REQUIREMENTS.
- COORDINATE SIZING OF SLEEVES, OPENINGS, CORE-DRILLED HOLES, OR CUT OPENINGS TO ACCOMMODATE PENETRATION FIRESTOPPING.
- INSTALL PENETRATION FIRESTOPPING TO COMPLY WITH MANUFACTURER'S WRITTEN INSTALLATION INSTRUCTIONS AND PUBLISHED DRAWINGS FOR PRODUCTS AND APPLICATIONS INDICATED.
- INSTALL FORMING MATERIALS AND OTHER ACCESSORIES OF TYPES REQUIRED TO SUPPORT FILL MATERIALS DURING THEIR APPLICATION AND IN THE POSITION NEEDED TO PRODUCE CROSS-SECTIONAL SHAPES AND DEPTHS REQUIRED TO ACHIEVE FIRE RATINGS INDICATED.
- IDENTIFY PENETRATION FIRESTOPPING WITH PREPRINTED METAL OR PLASTIC LABELS. ATTACH LABELS PERMANENTLY TO SURFACES ADJACENT TO AND WITHIN 6 INCHES OF FIRESTOPPING EDGE SO LABELS WILL BE VISIBLE TO ANYONE SEEKING TO REMOVE PENETRATING ITEMS OR FIRESTOPPING.

FIRE SPRINKLER SYSTEM REQUIREMENTS (NFPA-13)

THESE DRAWINGS AND SPECIFICATIONS ARE FOR THE FIRE PROTECTION CONTRACTOR TO ENGINEER, DESIGN, BID AND INSTALL A COMPLETE AND OPERATIONAL FIRE PROTECTION SYSTEM, PER THE DESIGN INTENT AS SHOWN.

- CONTRACTOR TO PROVIDE A HYDRAULICALLY-DESIGNED, FUSIBLE LINK, FULLY SPRINKLED, WET PIPE FIRE PROTECTION SYSTEM FOR BUILDING SPACES NOT SUBJECT TO FREEZING.
- CONTRACTOR TO PROVIDE A HYDRAULICALLY-DESIGNED, FUSIBLE LINK, FULLY SPRINKLED, DRY PIPE OR GLYCOL FIRE PROTECTION SYSTEM. BUILDING SPACES SUBJECT TO FREEZING, INCLUDING PARKING GARAGES, ENTRANCE CANOPIES AND OVERHANGS.
- ALL DESIGN SHALL BE IN ACCORDANCE WITH THE LATEST ADOPTED EDITIONS OF THE BUILDING CODE, FIRE CODE, MECHANICAL CODE, PLUMBING CODE, AND ANY OTHER LOCAL, STATE OR FEDERAL REGULATIONS AND CODES, AS WELL AS INSTRUCTIONS FROM THE AUTHORITY HAVING JURISDICTION.
- SUBMIT FIRE PROTECTION LAYOUT DRAWINGS AND CALCULATIONS TO THE ENGINEER FOR GENERAL APPROVAL OF SYSTEM LAYOUT, LOCATION OF COMPONENTS ETC. THEN SUBMIT TO THE FIRE MARSHALL HAVING JURISDICTION AND OBTAIN APPROVAL. CONTRACTOR TO PAY ALL PERMIT/APPROVAL/PLAN/CHECK FEES AND COSTS INVOLVED.
- SYSTEM DESIGN SHALL BE BASED ON THE FOLLOWING CRITERIA:
 - LIGHT HAZARD IN ALL AREAS, EXCEPT ORDINARY HAZARD GROUP 1 IN THE KITCHEN AREA.
 - DESIGN THE SYSTEM USING THE AREA/DENSITY METHOD IN NFPA 13.
 - FLOW TEST DATA TO BE DETERMINED BY THE FIRE PROTECTION CONTRACTOR.
- PROVIDE COVERAGE FOR A SINGLE FIRE ZONE.
- PROVIDE INSPECTOR'S TEST CONNECTION IN A LOCATION APPROVED BY THE OWNER AND THE FIRE MARSHALL.
- DUE CONSIDERATION SHALL BE GIVEN TO THE LOCATION OF BUILDING ELEMENTS, (I.E. BEAMS, COLUMNS, LIGHT FIXTURES, ETC.) IN DETERMINING SPRINKLER HEAD SPACING AND ARRANGEMENT. THE STRUCTURE SHOWN ON ALL DETAILS MAY OR MAY NOT PERTAIN TO A PORTION OR ANY PORTION OF THE BUILDING. COORDINATE MOUNTING REQUIREMENTS WITH ARCHITECTURAL DRAWINGS AND STRUCTURAL.
- ALL EQUIPMENT, PIPING, COMPONENT, AND ACCESSORY SIZES, CAPACITIES AND TYPES SHOWN IN THESE DRAWINGS AND SPECIFICATIONS SHALL BE ADHERED TO.
- AUXILIARY DRAINS SHALL BE INCLUDED AS NECESSARY TO DRAIN ALL SPRINKLER SYSTEM DISTRIBUTION LINES AND BRANCHES DOWNSTREAM OF THE RISER CHECK VALVE.
- AUTOMATIC AIR RELEASE VALVES SHALL BE FURNISHED AS NECESSARY TO VENT THE DRY PIPE SPRINKLER SYSTEM. THE VALVES SHALL BE MADE SEPARABLE FROM THE SYSTEM WITH APPROPRIATELY SIZED GATE VALVES.
- THE CONTRACTOR SHALL THOROUGHLY TEST, DISINFECT, AND FLUSH THE PIPING SYSTEM ACCORDING TO APPLICABLE CODES AND STANDARDS.
- ANY DIMENSIONS SHOWN ARE FOR REFERENCE ONLY. CONTRACTOR SHALL VERIFY ALL DIMENSIONS AND CONNECTIONS REQUIRED FOR INSTALLATION.
- REFER TO ARCHITECTURAL DRAWINGS FOR ADDITIONAL BUILDING INFORMATION SUCH AS ATTIC SPACES, CONSTRUCTION MATERIALS, SPECIAL USE SPACES, BUILDING SECTIONS, ETC.
- SPRINKLER HEADS:
 - SPRINKLER HEADS FOR LIGHT HAZARD CLASSIFICATION SHALL BE QUICK RESPONSE TYPE PER NFPA 13. ALL OTHER CLASSIFICATIONS SHALL BE STANDARD RESPONSE TYPE.
 - GENERAL: ALL HEADS SHALL BE FACTORY MUTUAL APPROVED FOR APPLICATION AND INSTALLATION. WET OR DRY TYPE AS REQUIRED. CEILING ESCUTCHEONS MAY BE PLASTIC OR METAL 2 PIECE TYPE
 - EXPOSED HEADS IN CEILING: SEMI-RECESSED TYPE WITH SATIN CHROME-PLATED ESCUTCHEON OR CUP. WHEREVER HEADS ARE ADJACENT TO SURFACE-MOUNTED LIGHTS OR OBSTRUCTIONS, USE EXTENDED PENDENT HEAD WITH SHALLOW FRICTION ADJUSTABLE ESCUTCHEON WITH SATIN CHROME-PLATED FINISH. COORDINATE EXTENDED PENDENT HEAD USE WITH ARCHITECT PRIOR TO PURCHASE OR INSTALLATION.
- UPON COMPLETION OF THE WORK, REMOVE ALL SURPLUS MATERIALS AND RUBBISH. MAKE ALL REQUIRED PATCHING AND REPAIRS OF OTHER TRADES' WORK DAMAGED BY THIS CONTRACTOR, AND LEAVE THE PREMISES IN A CLEAN, ORDERLY CONDITION.
- THE CONTRACTOR SHALL GUARANTEE THE ENTIRE FIRE PROTECTION SYSTEM FOR A PERIOD OF ONE YEAR FROM THE DATE OF SUBSTANTIAL COMPLETION.
- ALL ALLOWABLE SPRINKLER SYSTEM COMPONENTS SHALL BE PRIMED AND PAINTED RED, SYSTEM COMPONENTS WHICH MAY BE INACCESSIBLE AFTER INSTALLATION SHALL BE PAINTED BEFORE INSTALLATION.
- IN AREAS WITH LAY-IN CEILINGS. LOCATE HEADS IN THE CENTER OF THE CEILING TILE. PROVIDE ALL NECESSARY ELBOWS IN BRANCH LINES, TO ACHIEVE THIS.

Donald L. Welch

Architect

7533 Sandy Land Lane
Midvale, Utah 84047
801.548-6391
dwelch5977@msn.com




324 S. State St., Suite 400
Salt Lake City, UT 84111
801-328-5151
801-328-5151
fax: 801-328-5155
www.spectrum-engineers.com

THE DESIGNS SHOWN AND DESCRIBED HEREIN INCLUDING ALL TECHNICAL DRAWINGS, GRAPHIC REPRESENTATION & MODELS THEREOF, ARE PROPRIETARY & CAN NOT BE COPIED, DUPLICATED, OR COMMERCIALY EXPLOITED IN WHOLE OR IN PART WITHOUT THE SOLE AND EXPRESS WRITTEN PERMISSION FROM DONALD L. WELCH ARCHITECT

THESE DRAWINGS ARE AVAILABLE FOR LIMITED REVIEW AND EVALUATION BY CLIENTS CONSULTANTS, CONTRACTORS, GOVERNMENT AGENCIES, VENDORS, AND OFFICE PERSONNEL ONLY IN ACCORDANCE WITH THIS NOTICE.

consultant:

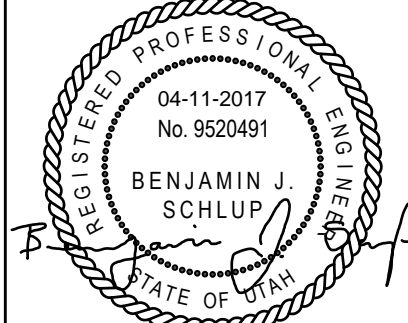

project:

Tenant Finish
for New
Brighton
Recovery
Campus
4905, 4911, 4915,
4925, 4931, & 4953
South 900 East
Salt Lake County,
Utah

date

April 11, 2017

revisions

PERMIT SET--December 28, 2016
Δ ADDENDUM #1--January 04, 2017
Δ ADDENDUM #3--January 11, 2017
Δ ADDENDUM #4--January 17, 2017
Δ ADDENDUM #5--January 20, 2017
Δ ADDENDUM #7--February 24, 2017
Δ ADDENDUM #8 -- March 20, 2017
Δ ADDENDUM #9 -- April 11, 2017

data

project no:

draw by:

checked by:

title

PLUMBING
EQUIPMENT
SPECIFICATIONS
sheet

P02

BUILDING 'C'




324 S. State St., Suite 400
Salt Lake City, UT 84111
800-678-7077
801-328-5151
fax: 801-328-5155
www.spectrum-engineers.com

THE DESIGNS SHOWN AND DESCRIBED HEREIN INCLUDING ALL TECHNICAL DRAWINGS, GRAPHIC REPRESENTATION & MODELS THEREOF, ARE PROPRIETARY & CAN NOT BE COPIED, DUPLICATED, OR COMMERCIALY EXPLOITED IN WHOLE OR IN PART WITHOUT THE SOLE AND EXPRESS WRITTEN PERMISSION FROM DONALD L. WELCH ARCHITECT

THESE DRAWINGS ARE AVAILABLE FOR LIMITED REVIEW AND EVALUATION BY CLIENTS, CONSULTANTS, CONTRACTORS, GOVERNMENT AGENCIES, VENDORS, AND OFFICE PERSONNEL ONLY IN ACCORDANCE WITH THIS NOTICE.

consultant:

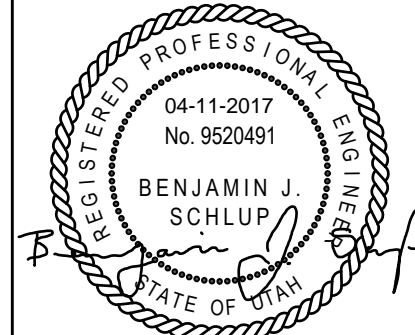

project:

Tenant Finish
for New
Brighton
Recovery
Campus
4905, 4911, 4915,
4925, 4931, & 4953
South 900 East
Salt Lake County,
Utah

date

April 11, 2017

revisions

- PERMIT SET-December 28, 2016
ADDENDUM #1-January 04, 2017
ADDENDUM #3-January 11, 2017
ADDENDUM #4-January 17, 2017
ADDENDUM #5-January 20, 2017
ADDENDUM#7-February 24, 2017
ADDENDUM#8 - March 20, 2017
ADDENDUM#9 - April 11, 2017

data

project no:

drawn by:

checked by:

title


PLUMBING
SCHEDULES &
DETAILS
sheet

P11

BUILDING 'C'

PLUMBING FIXTURE SCHEDULE (COORDINATE MOUNTING HEIGHTS WITH ARCH. PLANS)


SYMBOL	FIXTURE	MANUFACTURER AND MODEL NO.	COLD WATER	HOT WATER	WASTE	VENT	ACCESSORIES AND REMARKS
FD-1 FD-2	FLOOR DRAINS	SEE P02 (SPEC SECTION 221316)	-	-	2" OR 4"	1-1/2" OR 3"	REFERENCE SHEET P02. FLOOR DRAINS IN FINISHED SPACES TO BE FD-1 (2"). ALL WATER ENTRY DRAINS TO BE FD-2 (4"). INSTALL PROVENT TRAP GUARD OR EQUAL IN EACH DRAIN TYPE.
FIRE & DOMESTIC WATER ENTRIES DOUBLE CHECK & BACKFLOW DEVICES			SEE P02 (SPEC SECTION 221316)	SEE REMARKS	-	-	REFERENCE SHEET P02. MAKE/MODELS FOR FIRE/WATER ENTRY BACKFLOW PREVENTER AND DOUBLE CHECK DETECTOR ASSEMBLIES INDICATED. 4" FIRE ENTRY LINE WHERE INDICATED. BUILDINGS C & D TO INCORPORATE A 1-1/2" WATER SERVICE. BUILDINGS A, B, E, F TO HAVE 2" DOMESTIC WATER SERVICE. LOCATE FIRE CONTROL PANEL AT EACH FIRE ENTRY. <u>ELECTRICAL:</u> PROVIDE LINE VOLTAGE POWER (115V CIRCUITS) TO FIRE ENTRY FLOW SWITCH & AIR COMPRESSOR
SH-1	SHOWER (ADA) (FLOOR MOUNTED)	SEE ARCHITECTURAL	1/2"	1/2"	2"	1-1/2"	REFERENCE ARCHITECTURAL SHEET A6.1A. SPECIFICATIONS FOR SHOWER INSERT, DRAIN, SHOWERHEAD, VALVES, & ASSOCIATED ACCESSORIES ARE INDICATED.
GWH-1	GAS WATER HEATER (FLOOR MOUNTED)	BRADFORD WHITE EF-100T-300E-3N(A)	1-1/2"	1-1/2"	-	-	COMMERCIAL ULTRA HIGH EFFICIENCY GAS WATER HEATER. 92% THERMAL EFFICIENCY. DIRECT SPARK IGNITION. 300 MBH INPUT. 3/4" GAS CONNECTION. 100 GALLON CAPACITY. 335 GPH RECOVERY @ 100°F. DISCHARGE T&P VALVE INTO MOP SINK OR FLOOR DRAIN. PROVIDE 4.4 GALLON EXPANSION TANK (AMTROL EX-30 OR EQUAL). PROVIDE SEISMIC WATER HEATER STRAPS. DIMENSIONS: 77-5/8" H X 28-1/4" DIA. 900 LB SHIPPING WEIGHT. PROVIDE 4" (PVC, CPVC, OR ABS) VERTICAL VENTING. TERMINATE THROUGH ROOF WITH CONCENTRIC VENT KIT PER MANUFACTURER'S RECOMMENDATIONS. <u>ELECTRICAL:</u> 115V AC REQUIRED.
GWH-2	GAS WATER HEATER (FLOOR MOUNTED)	BRADFORD WHITE EF-100T-250E-3N(A)	1-1/2"	1-1/2"	-	-	COMMERCIAL ULTRA HIGH EFFICIENCY GAS WATER HEATER. 97% THERMAL EFFICIENCY. DIRECT SPARK IGNITION. 250 MBH INPUT. 3/4" GAS CONNECTION. 100 GALLON CAPACITY. 294 GPH RECOVERY @ 100°F. DISCHARGE T&P VALVE INTO MOP SINK OR FLOOR DRAIN. PROVIDE 4.4 GALLON EXPANSION TANK (AMTROL EX-30 OR EQUAL). PROVIDE SEISMIC WATER HEATER STRAPS. DIMENSIONS: 77-5/8" H X 28-1/4" DIA. 900 LB SHIPPING WEIGHT. PROVIDE 4" (PVC, CPVC, OR ABS) VERTICAL VENTING. TERMINATE THROUGH ROOF WITH CONCENTRIC VENT KIT PER MANUFACTURER'S RECOMMENDATIONS. <u>ELECTRICAL:</u> 115V AC REQUIRED.
GWH-3	GAS WATER HEATER (FLOOR MOUNTED)	BRADFORD WHITE LG2PDV50H603N	3/4"	3/4"	-	-	LIGHT DUTY COMMERCIAL POWER DIRECT VENT GAS WATER HEATER. 60 MBH INPUT. 1/2" GAS CONNECTION. 48 GALLON CAPACITY. 58 GPH RECOVERY @ 100°F. DISCHARGE T&P VALVE INTO MOP SINK OR FLOOR DRAIN. PROVIDE 2.1 GALLON EXPANSION TANK (WATTS PLT-5 OR EQUAL). PROVIDE SEISMIC WATER HEATER STRAPS. DIMENSIONS: 67" H X 22" DIA. 205 LB SHIPPING WEIGHT. PROVIDE 3" (PVC, CPVC, OR ABS) VERTICAL VENTING. TERMINATE THROUGH ROOF WITH CONCENTRIC VENT KIT PER MANUFACTURER'S RECOMMENDATIONS. <u>ELECTRICAL:</u> 110 VAC REQUIRED FOR POWER VENTING (3.1 AMPERES)
GWH-4	GAS WATER HEATER (FLOOR MOUNTED)	BRADFORD WHITE EF-60T-199E-3N(A)	1-1/2"	1-1/2"	-	-	COMMERCIAL ULTRA HIGH EFFICIENCY GAS WATER HEATER. 92% THERMAL EFFICIENCY. DIRECT SPARK IGNITION. 199 MBH INPUT. 3/4" GAS CONNECTION. 60 GALLON CAPACITY. 223 GPH RECOVERY @ 100°F. DISCHARGE T&P VALVE INTO MOP SINK OR FLOOR DRAIN. PROVIDE 4.4 GALLON EXPANSION TANK (AMTROL EX-30 OR EQUAL). PROVIDE SEISMIC WATER HEATER STRAPS. DIMENSIONS: 57" H X 28-1/4" DIA. 570 LB SHIPPING WEIGHT. PROVIDE 3" (PVC, CPVC, OR ABS) VERTICAL VENTING. TERMINATE THROUGH ROOF WITH CONCENTRIC VENT KIT PER MANUFACTURER'S RECOMMENDATIONS. <u>ELECTRICAL:</u> 115V AC REQUIRED.
HWCP-1	HOT WATER CIRCULATION PUMP	GRUNDFOS UP10-16BN5/TLC	-	1/2"	-	-	RECIRCULATION PUMP WITH MANUAL TIMER TO ALLOW FOR OPERATION DURING BUSINESS HOURS. INTEGRAL CHECK VALVE. <u>ELECTRICAL:</u> 115V PLUG IN TYPE. (6 FT LINE CORD)
HWCP-2	HOT WATER CIRCULATION PUMP	GRUNDFOS UP25-64SF	-	1/2"	-	-	RECIRCULATION PUMP. INTEGRAL CHECK VALVE. 5 GPM @ 15 FT HEAD, INTEGRAL CHECK VALVE. <u>ELECTRICAL:</u> 115V PLUG IN TYPE. (6 FT LINE CORD) 1/12 HP, 1.7 AMPS
MSB-1	MOP SINK BASIN	FLORESTONE MSR-2424	3/4"	3/4"	3"	1-1/2"	MOLDED MOP RECEPTOR. 24X24, 10" DEPTH. 18 GAUGE SS DRAIN GRID (#430). KOHLER K-8928. SERVICE SINK FAUCET, 3" THREADED THREADED SPOUT FOR HOSE CONNECTION, RUBBER HOSE WITH WALL HOOK. LEVER HANDLES
FS-1	FLOOR SINK	ZURN FD2375 (OR APPROVED EQUAL)	-	-	3"	1-1/2"	ENAMELED CAST IRON, ACID RESISTANT, DOME STRAINER, FULL GRATE
WM-1 WM-2	WATER METER (SUB-METERING)	BADGER RECORDALL MODEL M120 & M170 (OR APPROVED EQUAL)	-	1-1/2" 2"	-	-	LEAD FREE BRONZE ALLOW DISC METER (MATCH BUILDING WATER ENTRY SIZE 1-1/2" OR 2"), COMPLIES WITH AWWA STANDARD C700. 150 PSI MAX OPERATING PRESSURE.
BFP-1	BACKFLOW PREVENTER	WATTS MODEL SD-2 (OR APPROVED EQUAL)	1/2"	-	-	-	BACKFLOW PREVENTER FOR CARBONATED BEVERAGE MACHINES. DUAL CHECK DESIGN FOR PROTECTION OF WATER SUPPLY FROM CARBON DIOXIDE GAS AND CARBONATED WATER. ANSISNF STD 18 CERTIFIED, ASSE 1032 APPROVED DUAL CHECK VALVE, 316 STAINLESS STEEL BODY. MAX PRESSURE: 200 PSI, MAX TEMP: 110°F. PROVIDE RECOMMENDED STRAINER.
GD-1	FOOD WASTE DISPOSER	INSINKERATOR EVOLUTION	-	-	1-1/2"	-	ANTI-VIBRATION MOUNT, 34.6 OZ. CAPACITY, 12-1/4" HEIGHT. <u>ELECTRICAL:</u> 120 V, 3/4 HP, 8.1 AMPS
KS-1	KITCHEN SINK & FAUCET:	KOHLER K-3996-4 & KOHLER FORTE K-10445	1/2"	1/2"	1-1/2"	1-1/2"	33X22X6 DUAL BOWL TOP-MOUNT ADA SINK, 4 HOLE, 18 GAUGE SS, 4" FAUCET CENTERS, 18 GAUGE SS, FAUCET: PULL-OUT SPRAY, 1.8 GPM, LEVER HANDLES, (ADA), 7-3/4" SPOUT REACH, 4 HOLES.
UR-1 UR-2	URINAL (ADA)	SLOAN SU-1006 & ROYAL 181	1"	-	1-1/2"	1-1/2"	TOP SPUD WALL HUNG, STANDARD WASHDOWN URINAL, VITREOUS CHINA 1.5 GPF MANUAL FLUSHOMETER WITH WATER HAMMER ARRESTOR.
WC-1 WC-2	WATER CLOSET, FLOOR MOUNT (ADA)	SLOAN WETS-2450.1301 & ROYAL 113-1.28	1-1/2"	-	4"	2"	VITREOUS CHINA, ELONGATED BOWL, 1-1/2" TOP SPUD, COMMERCIAL TOILET SEAT, & BOLT CAP ACCESSORY 1.28 GPF MANUAL FLUSHOMETER. PROVIDE WITH WATER HAMMER ARRESTOR.
L-1	LAVATORY (ADA) FAUCET:	SLOAN SS-3001 & KOHLER K-16027-4	1/2"	1/2"	1-1/2"	1-1/2"	19.5"X16.5" VITREOUS CHINA UNDERMOUNTED WITH OVERFLOW. SINGLE HOLE BATHROOM FAUCET (ADA) LESS POP-UP TAIL PIECE. 1.2 GPM. 4-3/8" REACH. PROVIDE BDT VARIATION BELOW DECK THERMOSTATIC MIXING VALVE (SET WATER TEMP TO 110°F) PROVIDE UNDERCOUNTER PIPING INSULATION KIT.
L-2	LAVATORY (ADA) FAUCET:	SLOAN SS-3101 & KOHLER K-16027-4	1/2"	1/2"	2"	1-1/2"	20 3/4"X18 1/4" VITREOUS CHINA WALL MOUNTED LAVATORY. SINGLE HOLE. SINGLE HOLE BATHROOM FAUCET (ADA) LESS POP-UP TAIL PIECE. 1.2 GPM. 4-3/8" REACH. PROVIDE BDT VARIATION BELOW DECK THERMOSTATIC MIXING VALVE (SET WATER TEMP TO 110°F) PROVIDE UNDERCOUNTER PIPING INSULATION KIT.
S-1	SINK FAUCET:	KOHLER VAULT K-5286 UNDER-MOUNT KITCHEN SINK	1/2"	1/2"	1-1/2"	1-1/2"	24"X18-1/4" 16-GAUGE STAINLESS STEEL, SINGLE SQUARED BOWL, 9-INCH DEPTH FAUCET: KOHLER CORALAIS KITCHEN SINK FAUCET MODEL K-15888-K WRISTBLADE LEVER HANDLED FAUCET (ADA), 9" GOOSENECK SWING SPOUT. 1.8 GPM
S-2	SINK (ADA) FAUCET:	KOHLER VAULT K-3349-2 TOP MOUNT SINK	1/2"	1/2"	1-1/2"	1-1/2"	15"X15" 19-GAUGE STAINLESS STEEL, SINGLE BOWL, 2 FAUCET HOLES. 7-9/16-INCH DEPTH FAUCET: KOHLER CORALAIS KITCHEN SINK FAUCET MODEL K-15888-K WRISTBLADE LEVER HANDLED FAUCET (ADA), 9" GOOSENECK SWING SPOUT. 1.8 GPM
DF-1	DRINKING FOUNTAIN	ELKAY ECDFPW314C	1/2"	-	2"	1-1/2"	ADA HEIGHT DRINKING FOUNTAIN, WALL MOUNT, FULLY EXPOSED. 304 STAINLESS STEEL WITH SATIN FINISH.
EW-1	ELECTRIC WATER COOLER	ELKAY LZWS-LRPBM28K	1/2"	-	2"	1-1/2"	DUAL HEIGHT WATER COOLER WITH FILTER WITH INTEGRAL SENSOR ACTIVATED 1.1 GPM BOTTLE FILLING STATION. STAINLESS STEEL, 8 GPH. RECIPROCATING TYPE COOLING SYSTEM. ELECTRICAL: 115V, 370 WATTS, 5.0 FLA (INSTALLATION REQUIRES 12" WALL DEPTH)
NOTES: 1. ALL FIXTURE FINISHES TO BE REVIEWED BY ARCHITECT PRIOR TO ORDERING. 2. PROVIDE WATER HAMMER ARRESTORS @ ALL ICE MACHINES, WASHING MACHINES, & DISHWASHERS.							

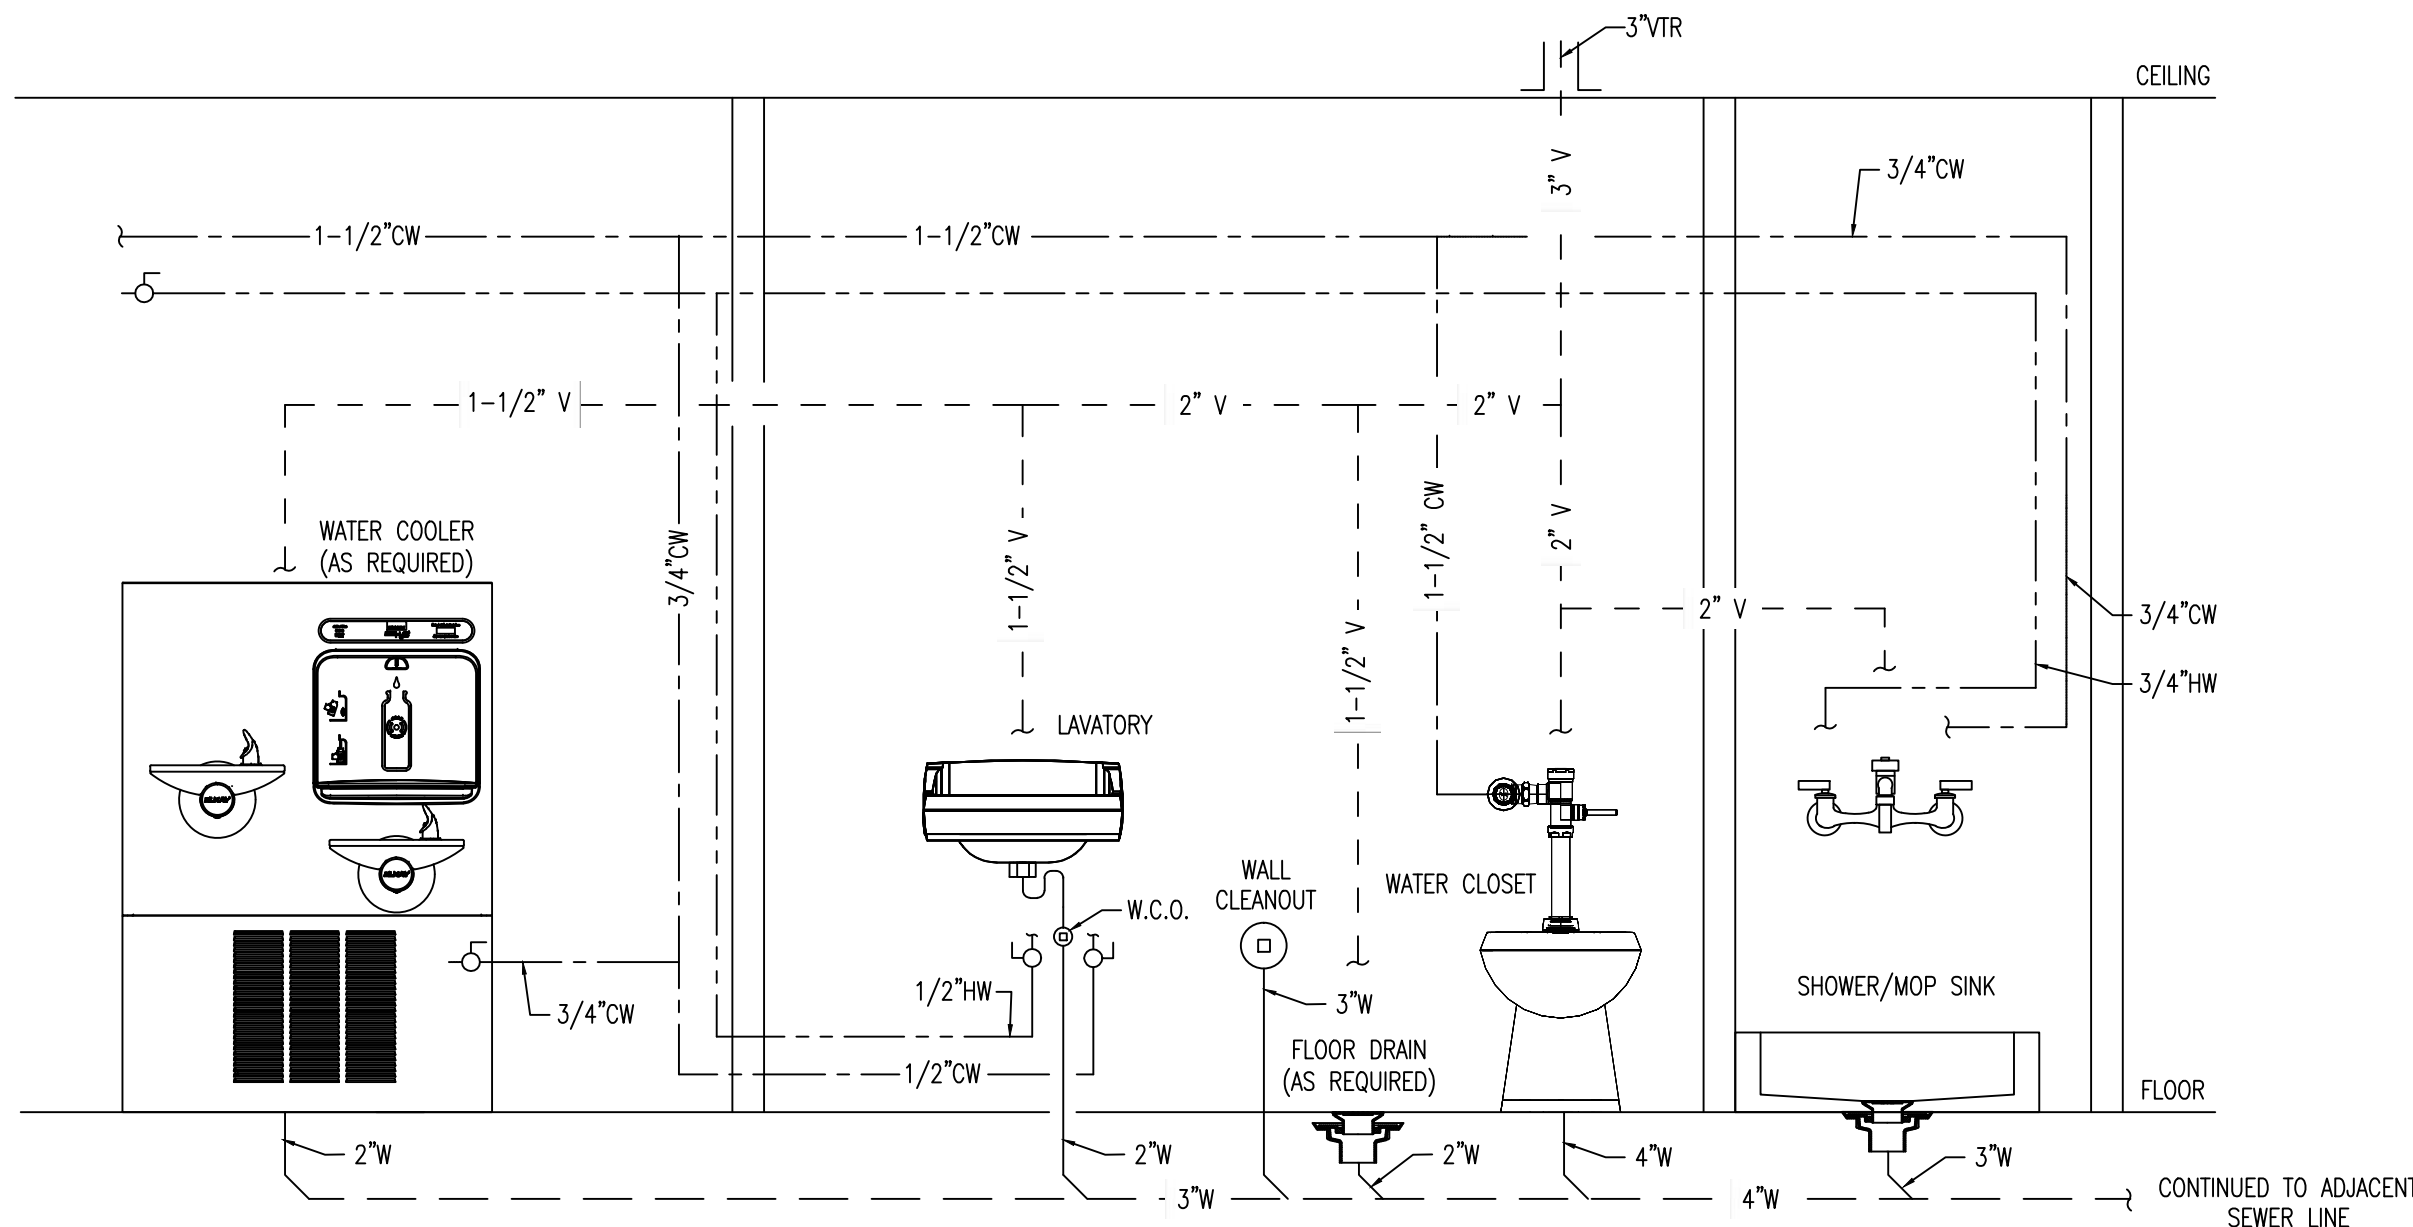


1

PLUMBING SCHEMATIC


SCALE: NTS

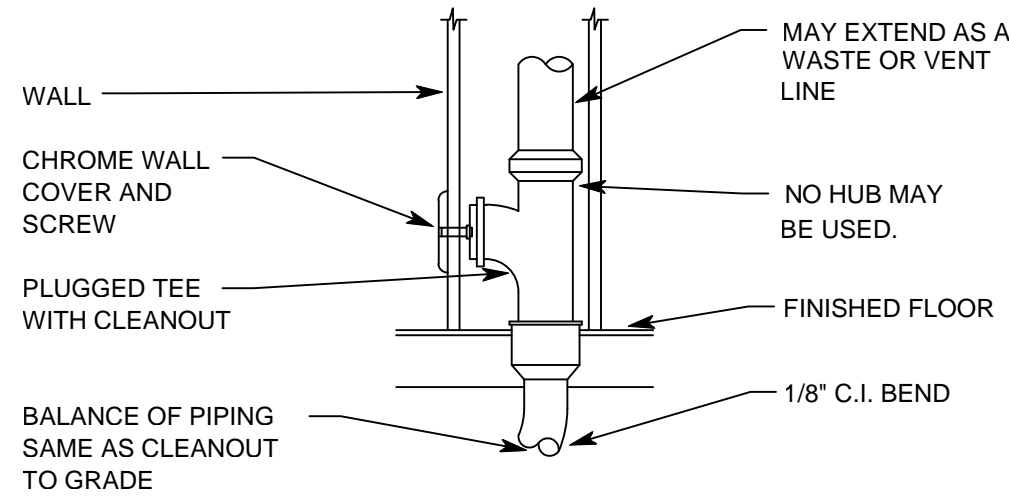


7 WALL CLEAN OUT
SCALE: NTS

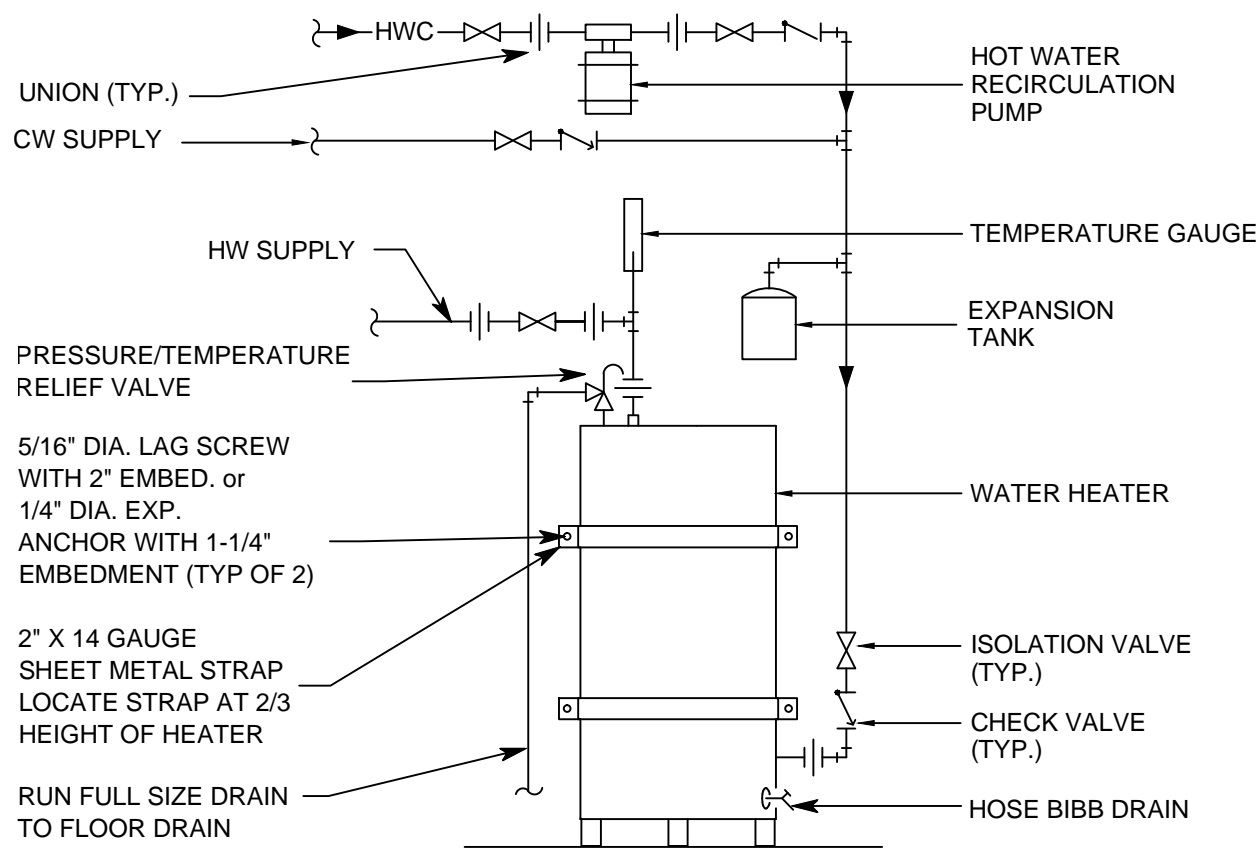


8 WATER HEATER DETAIL
SCALE: NTS

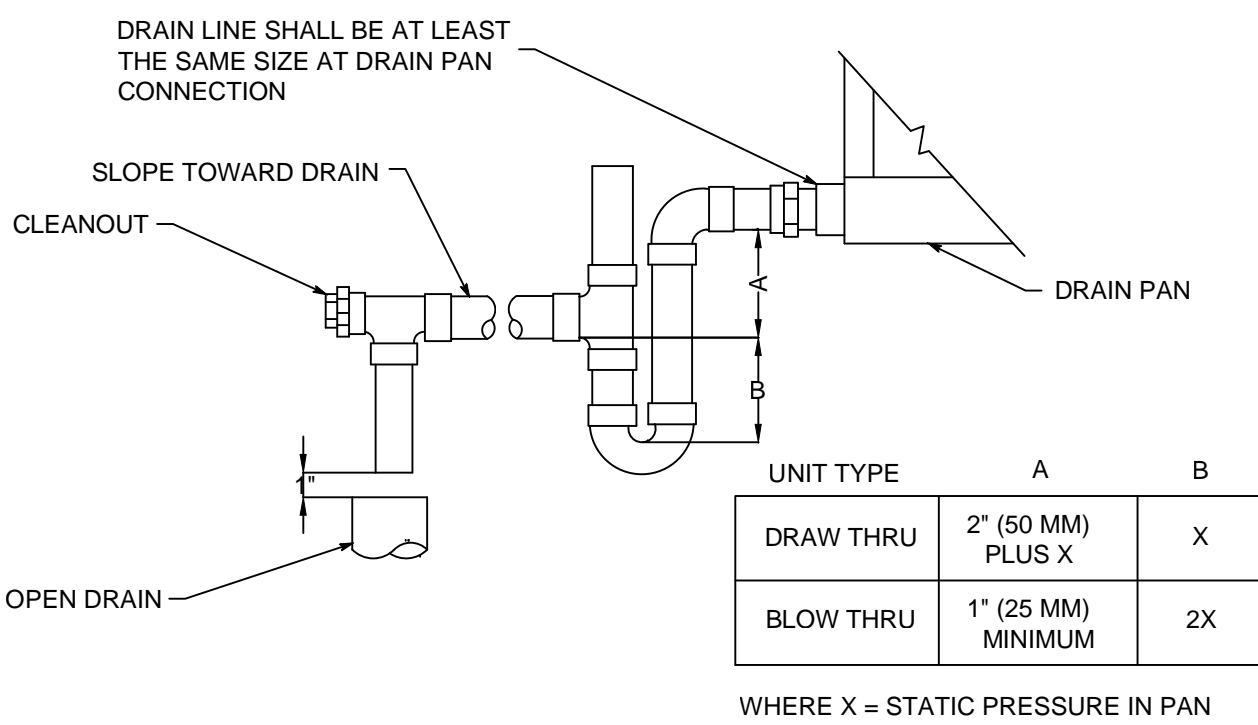


9 CONDENSATE DRAIN DETAIL
SCALE: NTS

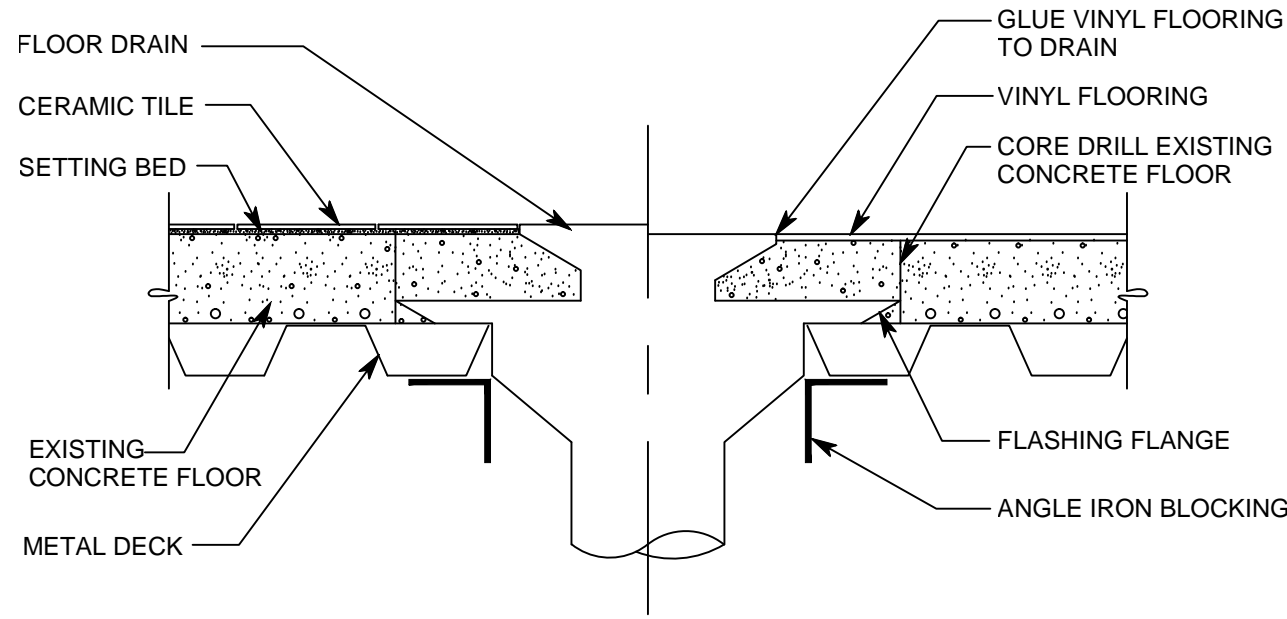


4 FLOOR DRAIN DETAIL
SCALE: NTS

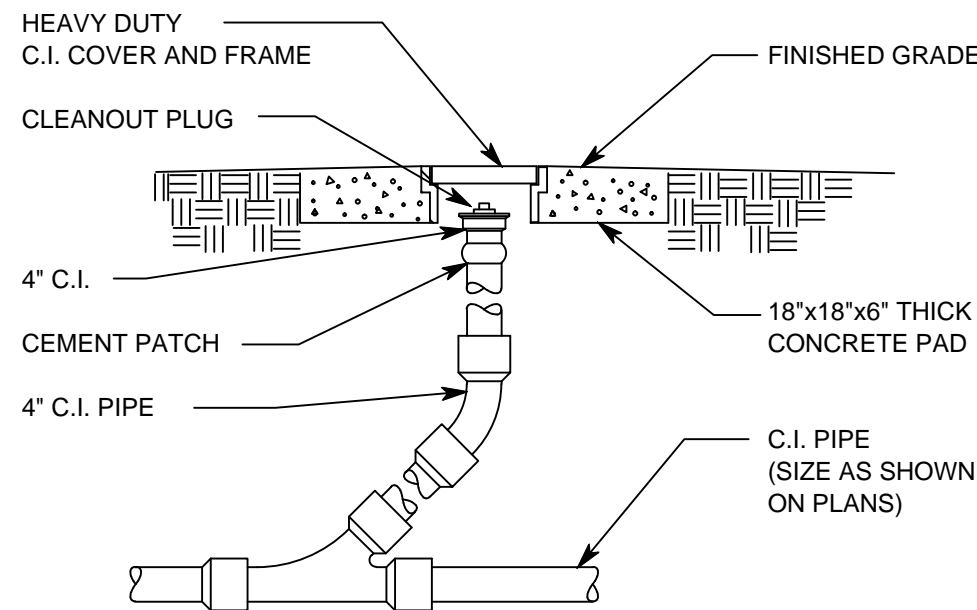


5 CLEANOUT TO GRADE
SCALE: NTS

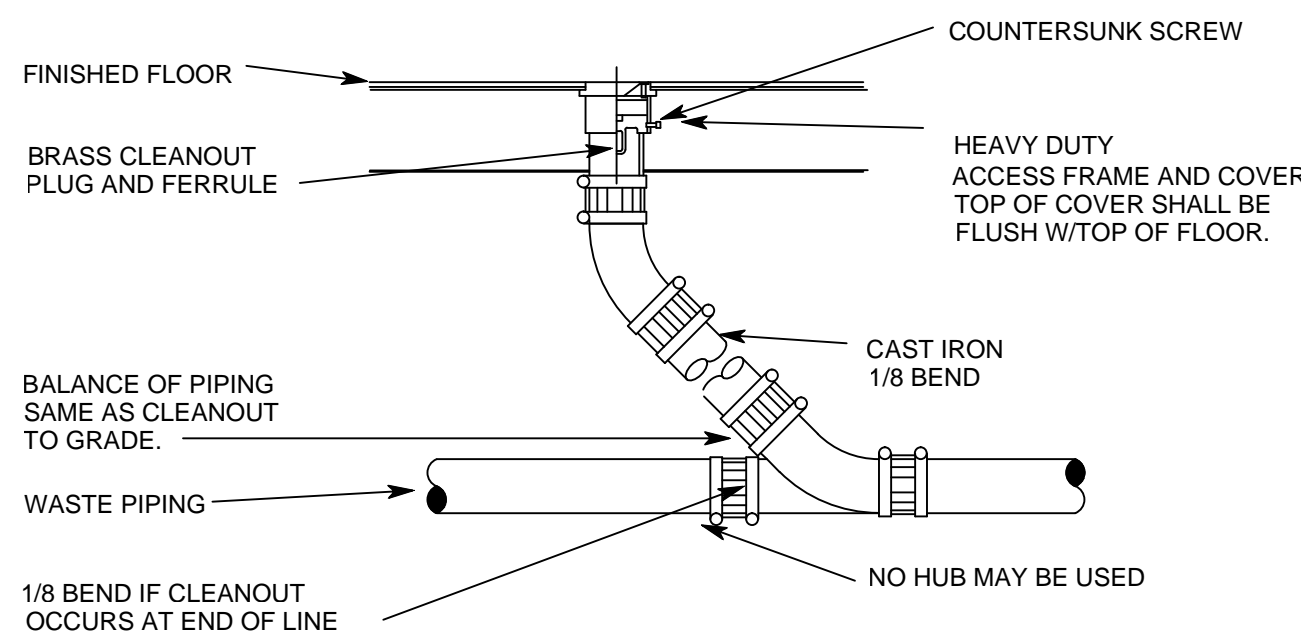


6 FLOOR CLEANOUT
SCALE: NTS

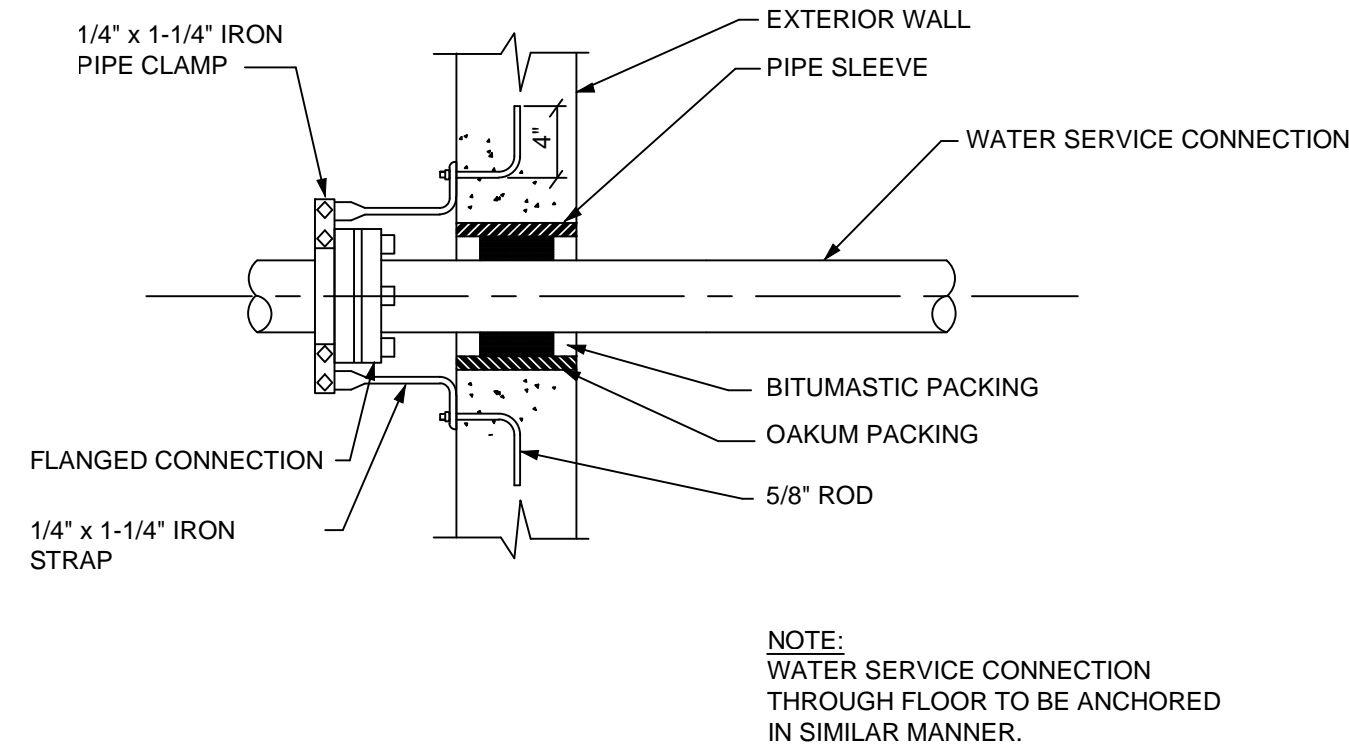

1 COLD WATER SERVICE ANCHORING
SCALE: NTS

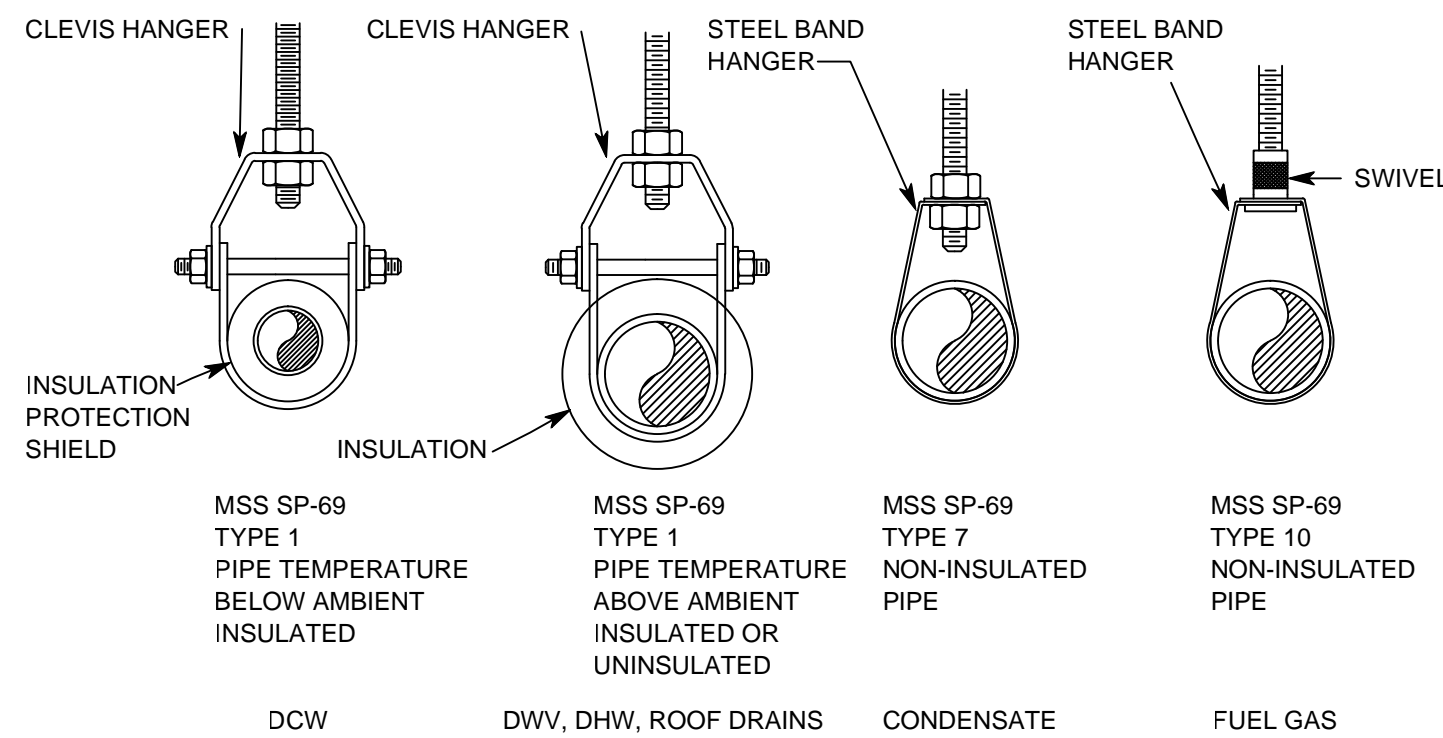

2 PIPE HANGER
SCALE: NTS

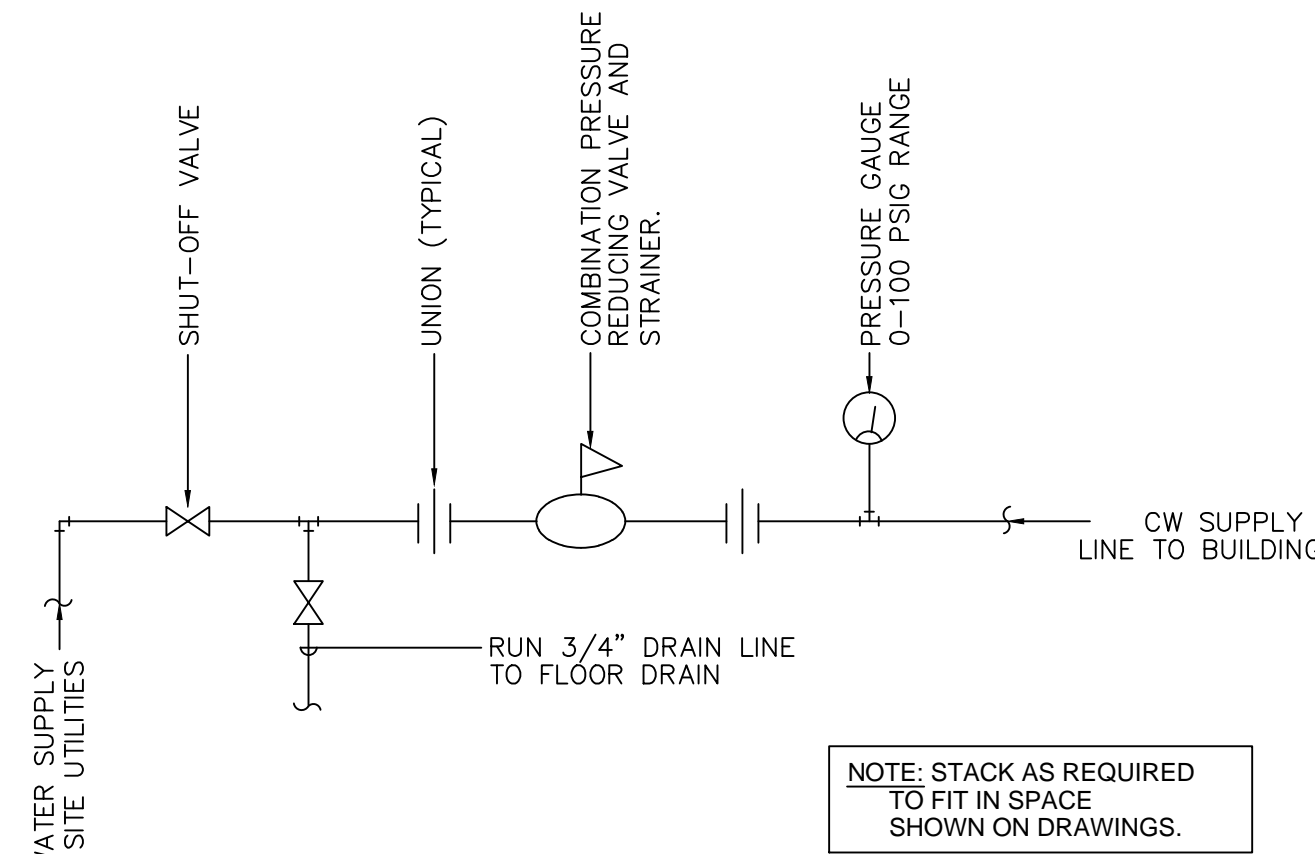

3 WATER ENTRY DETAIL
SCALE: NTS

Donald L. Welch
Architect
7533 Sandy Land Lane
Midvale, Utah 84047
801.548-6391
dwelch5977@msn.com




324 S. State St., Suite 400
Salt Lake City, UT 84111
800-678-7077
801-328-5151
fax: 801-328-5155
www.spectrum-engineers.com

THE DESIGNS SHOWN AND DESCRIBED HEREIN INCLUDING ALL TECHNICAL DRAWINGS, GRAPHIC REPRESENTATION & MODELS THEREOF, ARE PROPRIETARY & CAN NOT BE COPIED, DUPLICATED, OR COMMERCIALY EXPLOITED IN WHOLE OR IN PART WITHOUT THE SOLE AND EXPRESS WRITTEN PERMISSION FROM DONALD L. WELCH ARCHITECT

THESE DRAWINGS ARE AVAILABLE FOR LIMITED REVIEW AND EVALUATION BY CLIENTS, CONSULTANTS, CONTRACTORS, GOVERNMENT AGENCIES, VENDORS, AND OFFICE PERSONNEL ONLY IN ACCORDANCE WITH THIS NOTICE.

consultant:

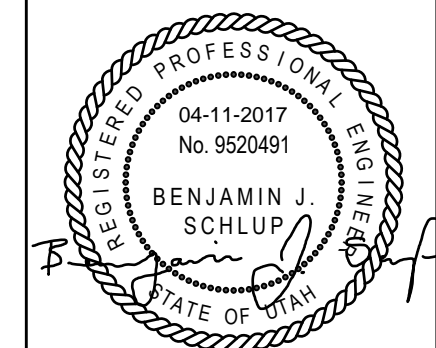

project:

Tenant Finish
for New
Brighton
Recovery
Campus
4905, 4911, 4915,
4925, 4931, & 4953
South 900 East
Salt Lake County,
Utah

date

April 11, 2017

revisions

- △ PERMIT SET-December 28, 2016
- △ ADDENDUM #1-January 04, 2017
- △ ADDENDUM #3-January 11, 2017
- △ ADDENDUM #4-January 17, 2017
- △ ADDENDUM #5-January 20, 2017
- △ ADDENDUM#7-February 24, 2017
- △ ADDENDUM#8 - March 20, 2017
- △ ADDENDUM#9 - April 11, 2017

data

project no:

drawn by:

checked by:


title

PLUMBING
DETAILS


sheet

P12


BUILDING 'C'

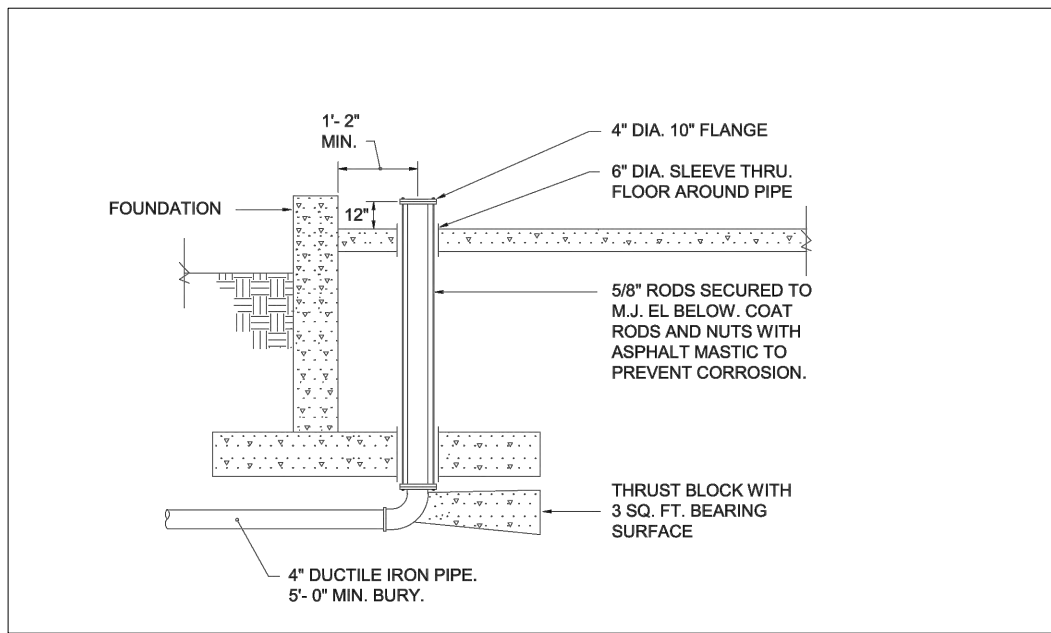


5 FIRE SPRINKLER ENTRY DETAIL
SCALE: NOT TO SCALE

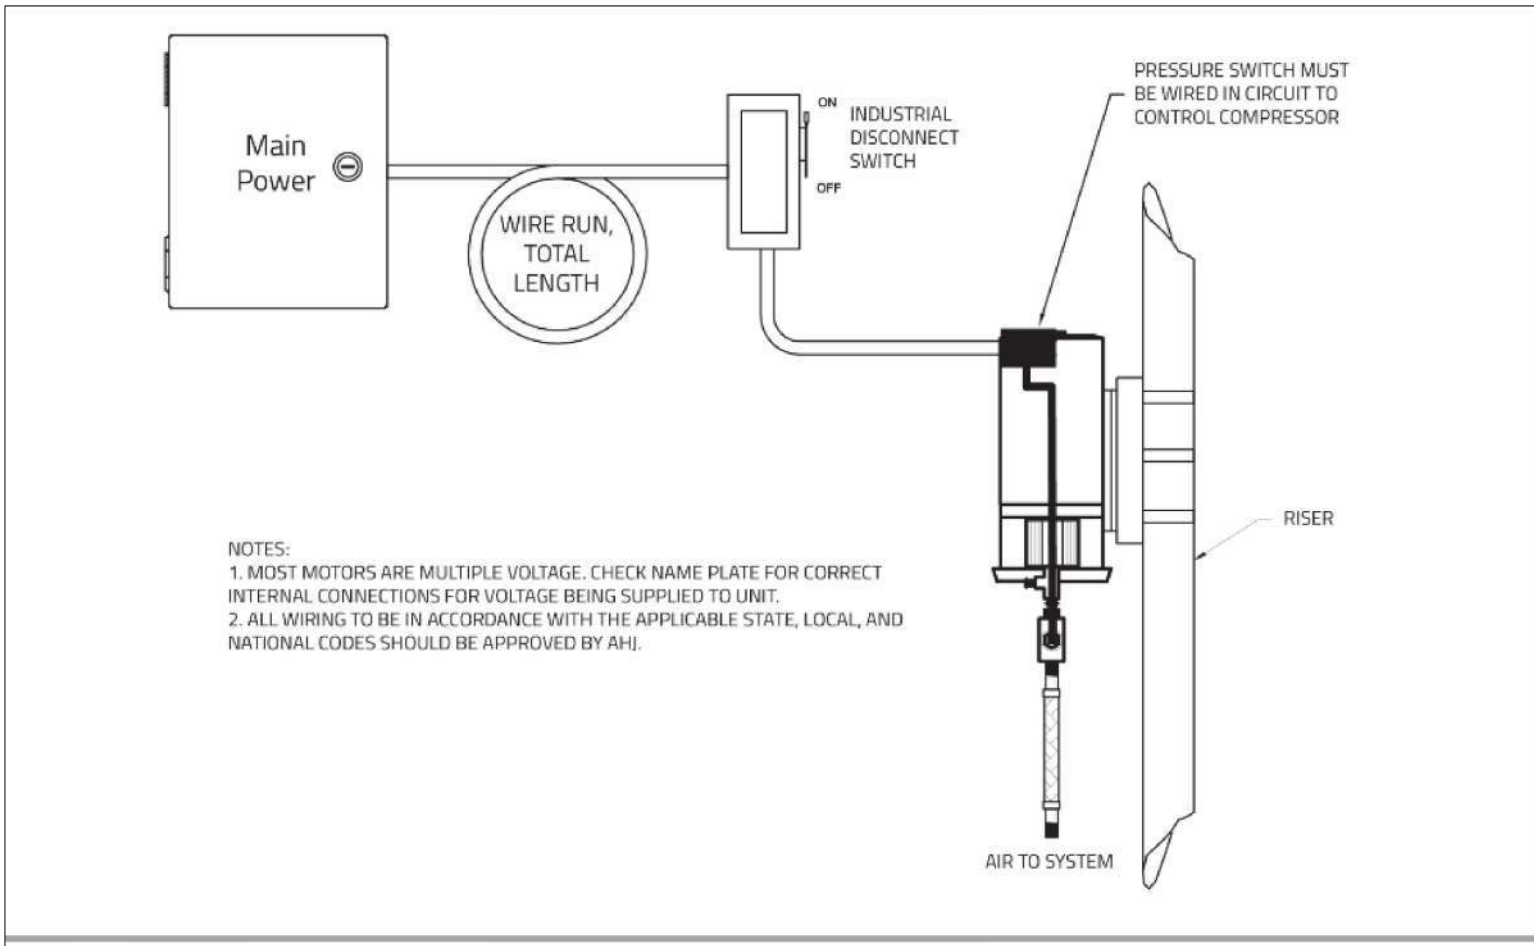


4 DRY PIPE FIRE SPRINKLER AIR COMPRESSOR DETAIL
SCALE: NOT TO SCALE

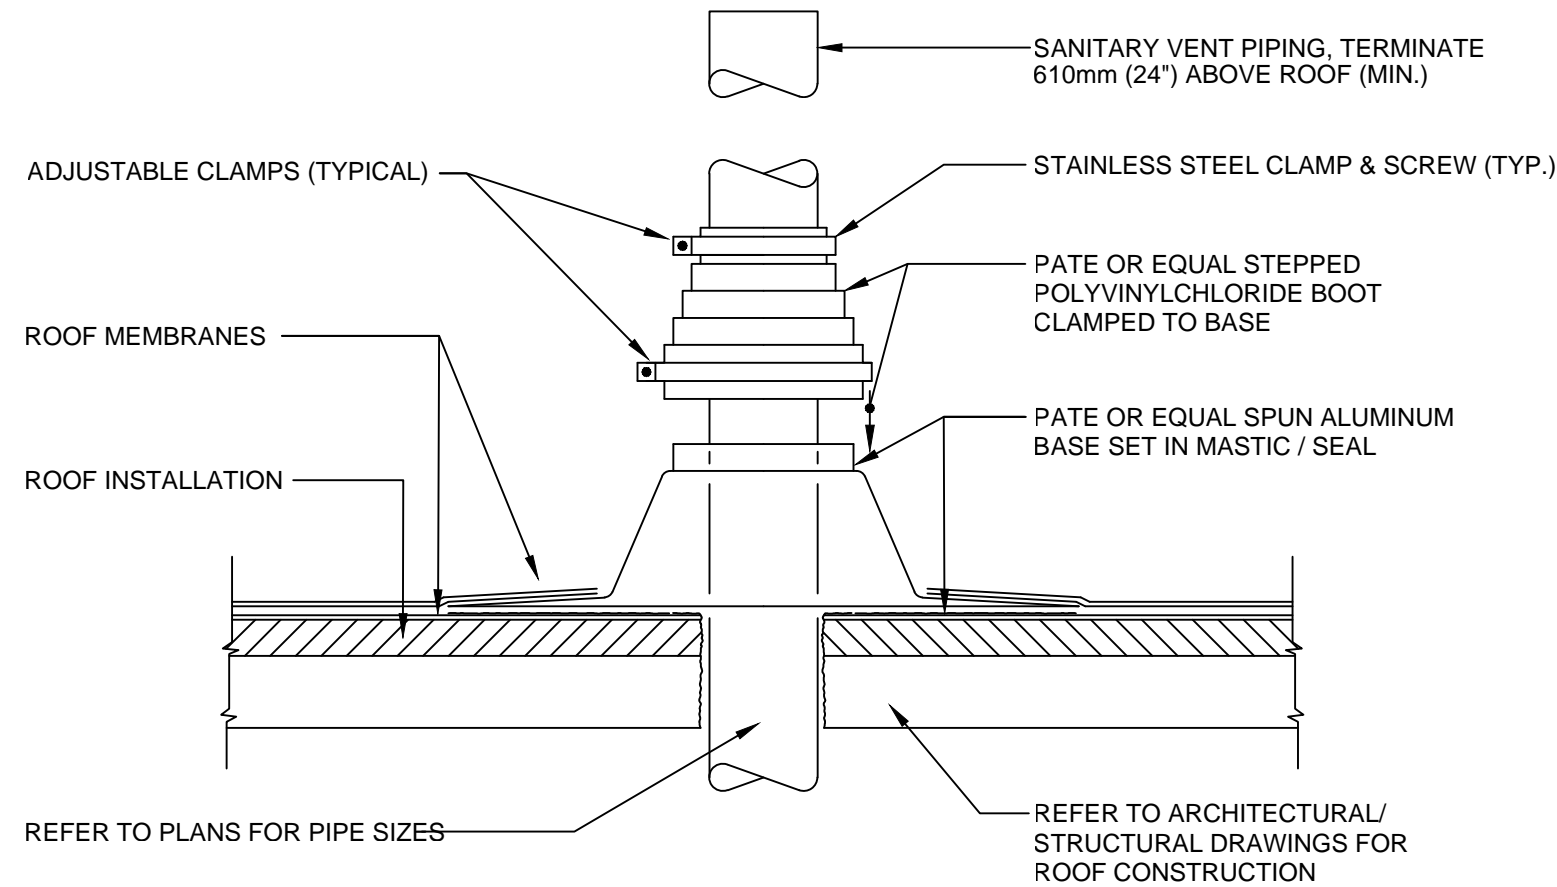


1 VENT THRU ROOF DETAIL
SCALE: NTS

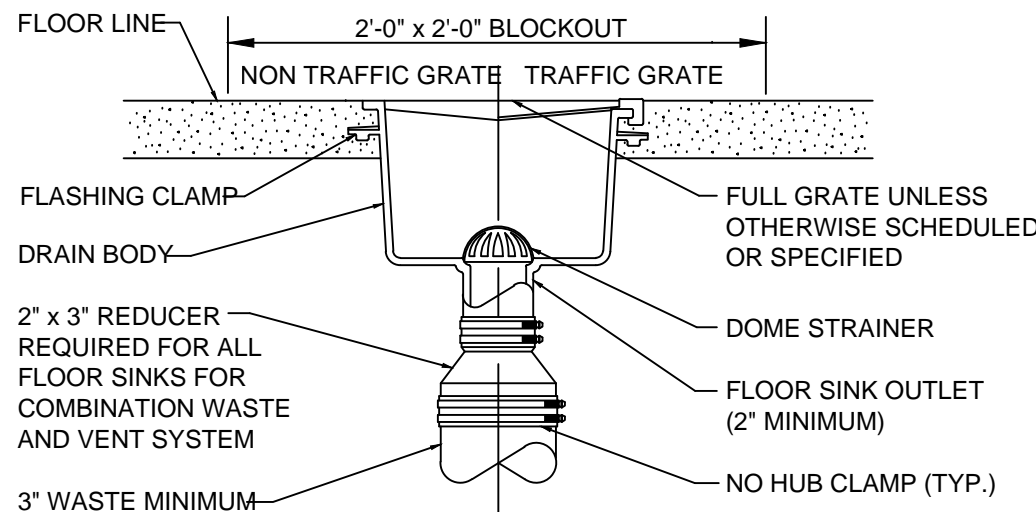


2 FLOOR SINK DETAIL
SCALE: NTS

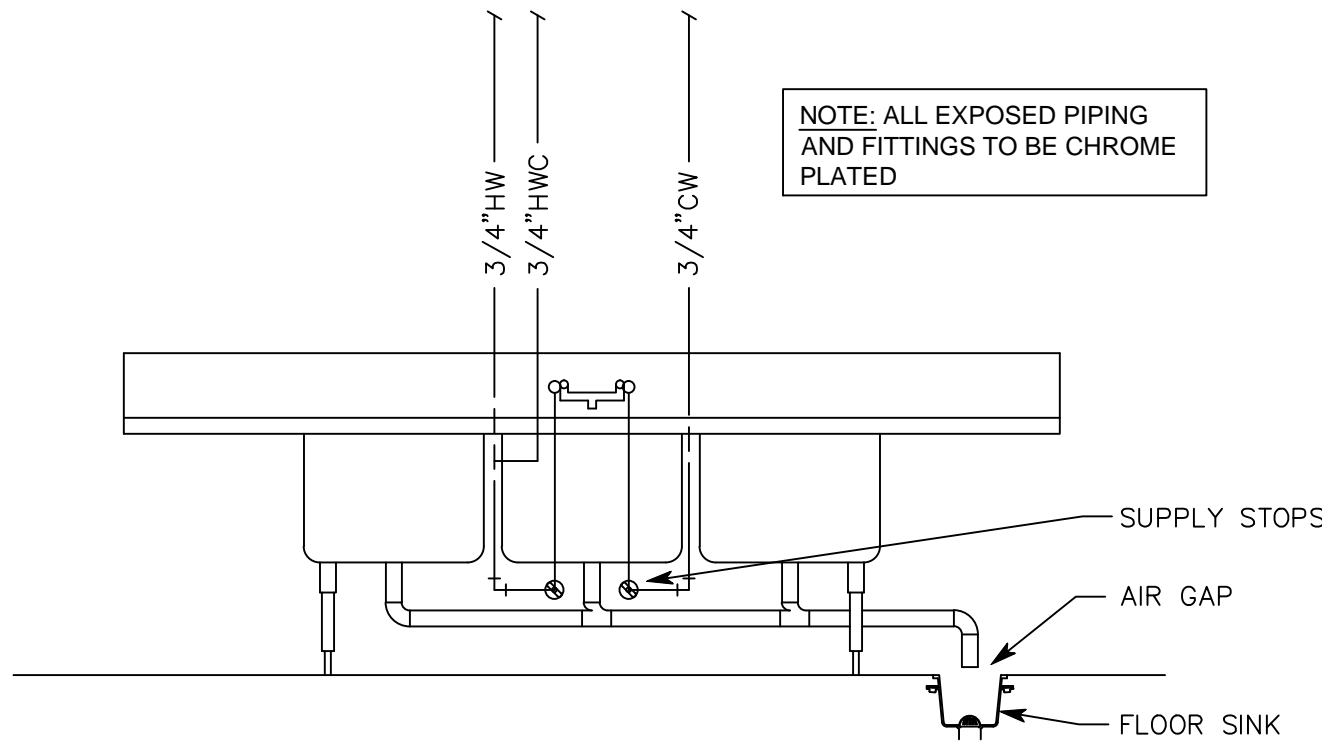

3 3-COMPARTMENT SINK DETAIL
SCALE: NTS
NOTE: PROVIDE HOT WATER CIRCULATION LINE AS NOTED ON PLAN VIEW. DISHWASHER TO DRAIN INTO FLOOR SINK BELOW 3-COMP SINK.

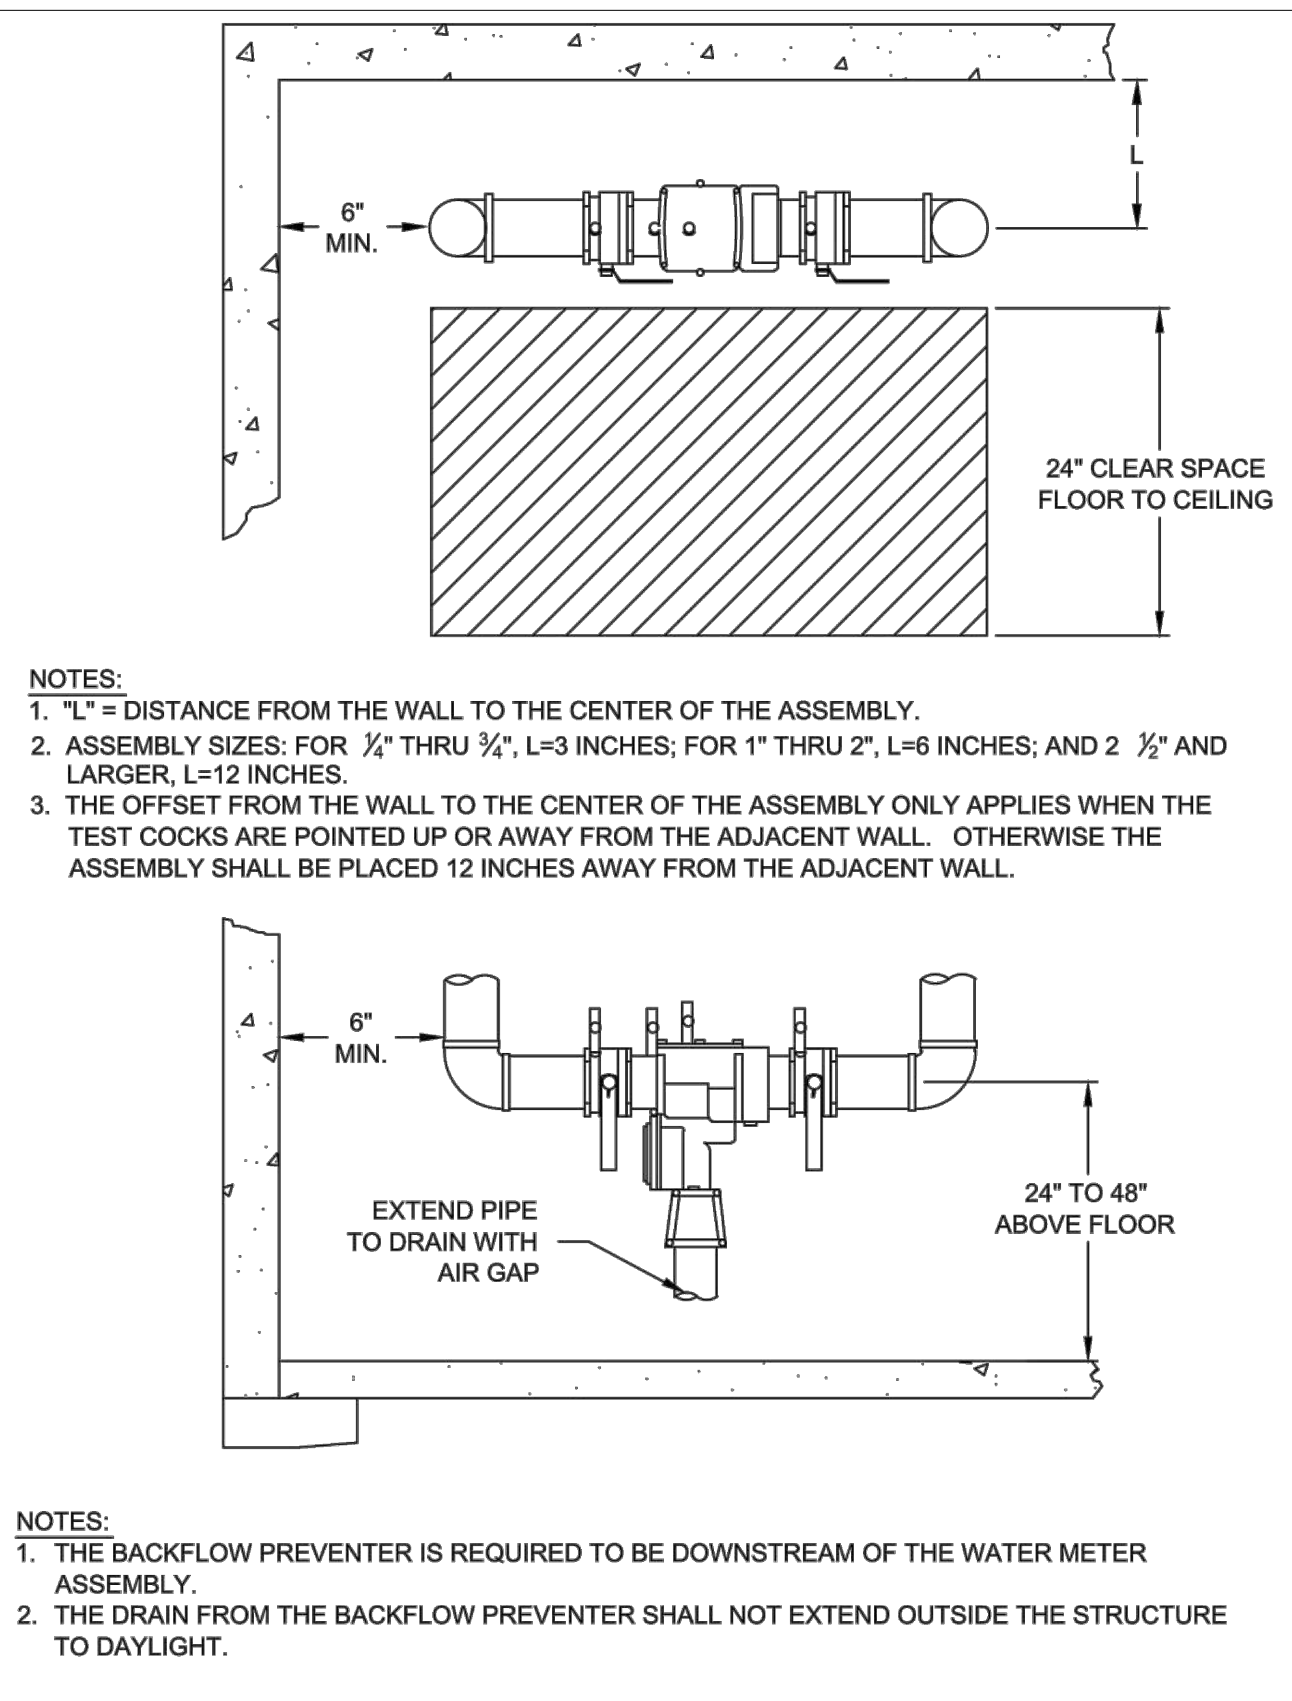

DOMESTIC REDUCED PRESSURE BACKFLOW PREVENTER

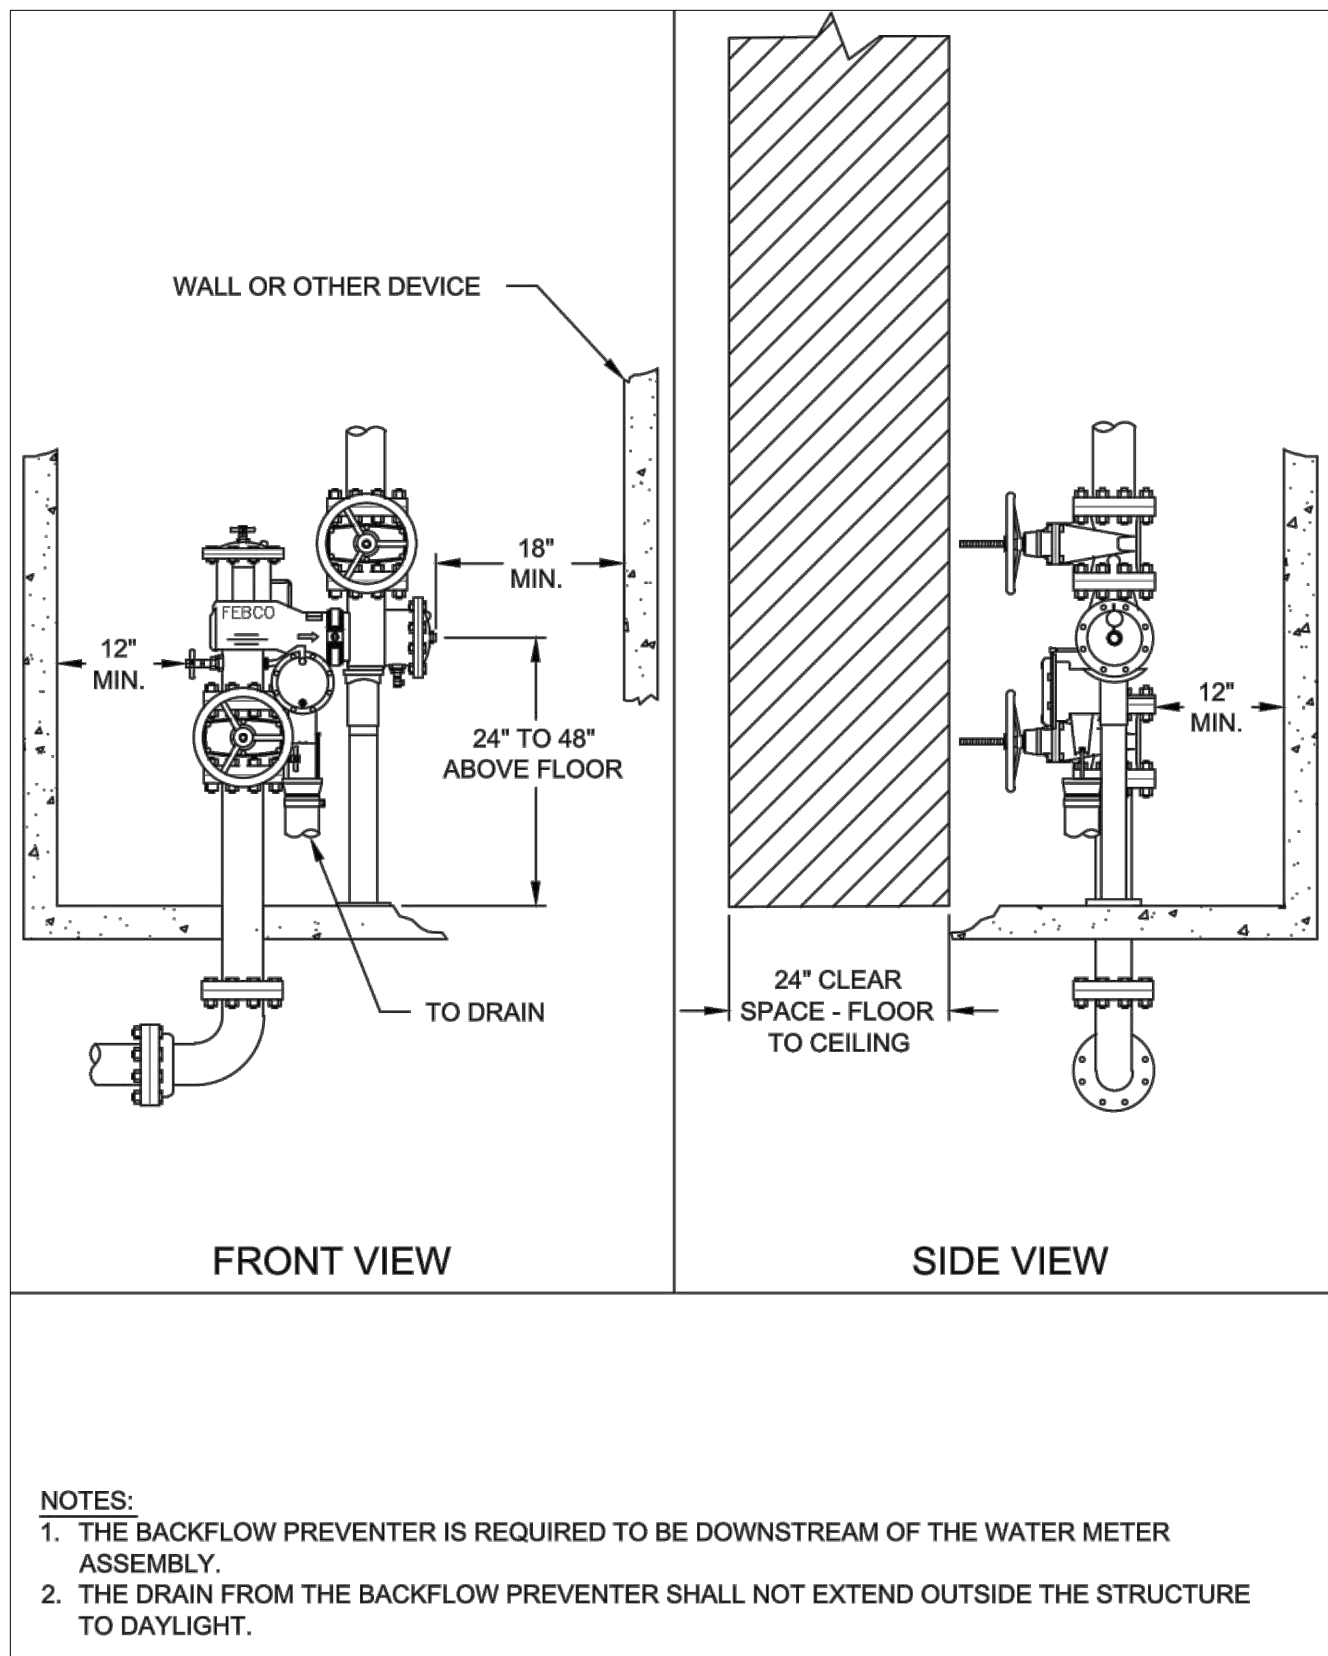

FIRE VERTICAL BACKFLOW PREVENTER

6 BACKFLOW PREVENTION DETAILS
SCALE: NOT TO SCALE

Donald L. Welch
Architect
7533 Sandy Land Lane
Midvale, Utah 84047
801.548.6391
dwelch5977@msn.com



324 S. State St., Suite 400
Salt Lake City, UT 84111
800-678-7077
801-328-5151
fax: 801-328-5155
www.spectrum-engineers.com

THE DESIGNS SHOWN AND DESCRIBED HEREIN INCLUDING ALL TECHNICAL DRAWINGS, GRAPHIC REPRESENTATION & MODELS THEREOF, ARE PROPRIETARY & CAN NOT BE COPIED, DUPLICATED, OR COMMERCIALY EXPLOITED IN WHOLE OR IN PART WITHOUT THE SOLE AND EXPRESS WRITTEN PERMISSION FROM DONALD L. WELCH ARCHITECT
THESE DRAWINGS ARE AVAILABLE FOR LIMITED REVIEW AND EVALUATION BY CLIENTS, CONSULTANTS, CONTRACTORS, GOVERNMENT AGENCIES, VENDORS, AND OFFICE PERSONNEL ONLY IN ACCORDANCE WITH THIS NOTICE.

consultant:



project:

Tenant Finish
for New
Brighton
Recovery
Campus
4905, 4911, 4915,
4925, 4931, & 4953
South 900 East
Salt Lake County,
Utah

date

April 11, 2017

revisions

- PERMIT SET-December 28, 2016
- ADDENDUM #1-January 04, 2017
- ADDENDUM #3-January 11, 2017
- ADDENDUM #4-January 17, 2017
- ADDENDUM #5-January 20, 2017
- ADDENDUM#7-February 24, 2017
- ADDENDUM#8 - March 20, 2017
- ADDENDUM#9 - April 11, 2017

data

project no:

drawn by:

checked by:


title

PLUMBING
DETAILS


sheet

P13

BUILDING 'C'

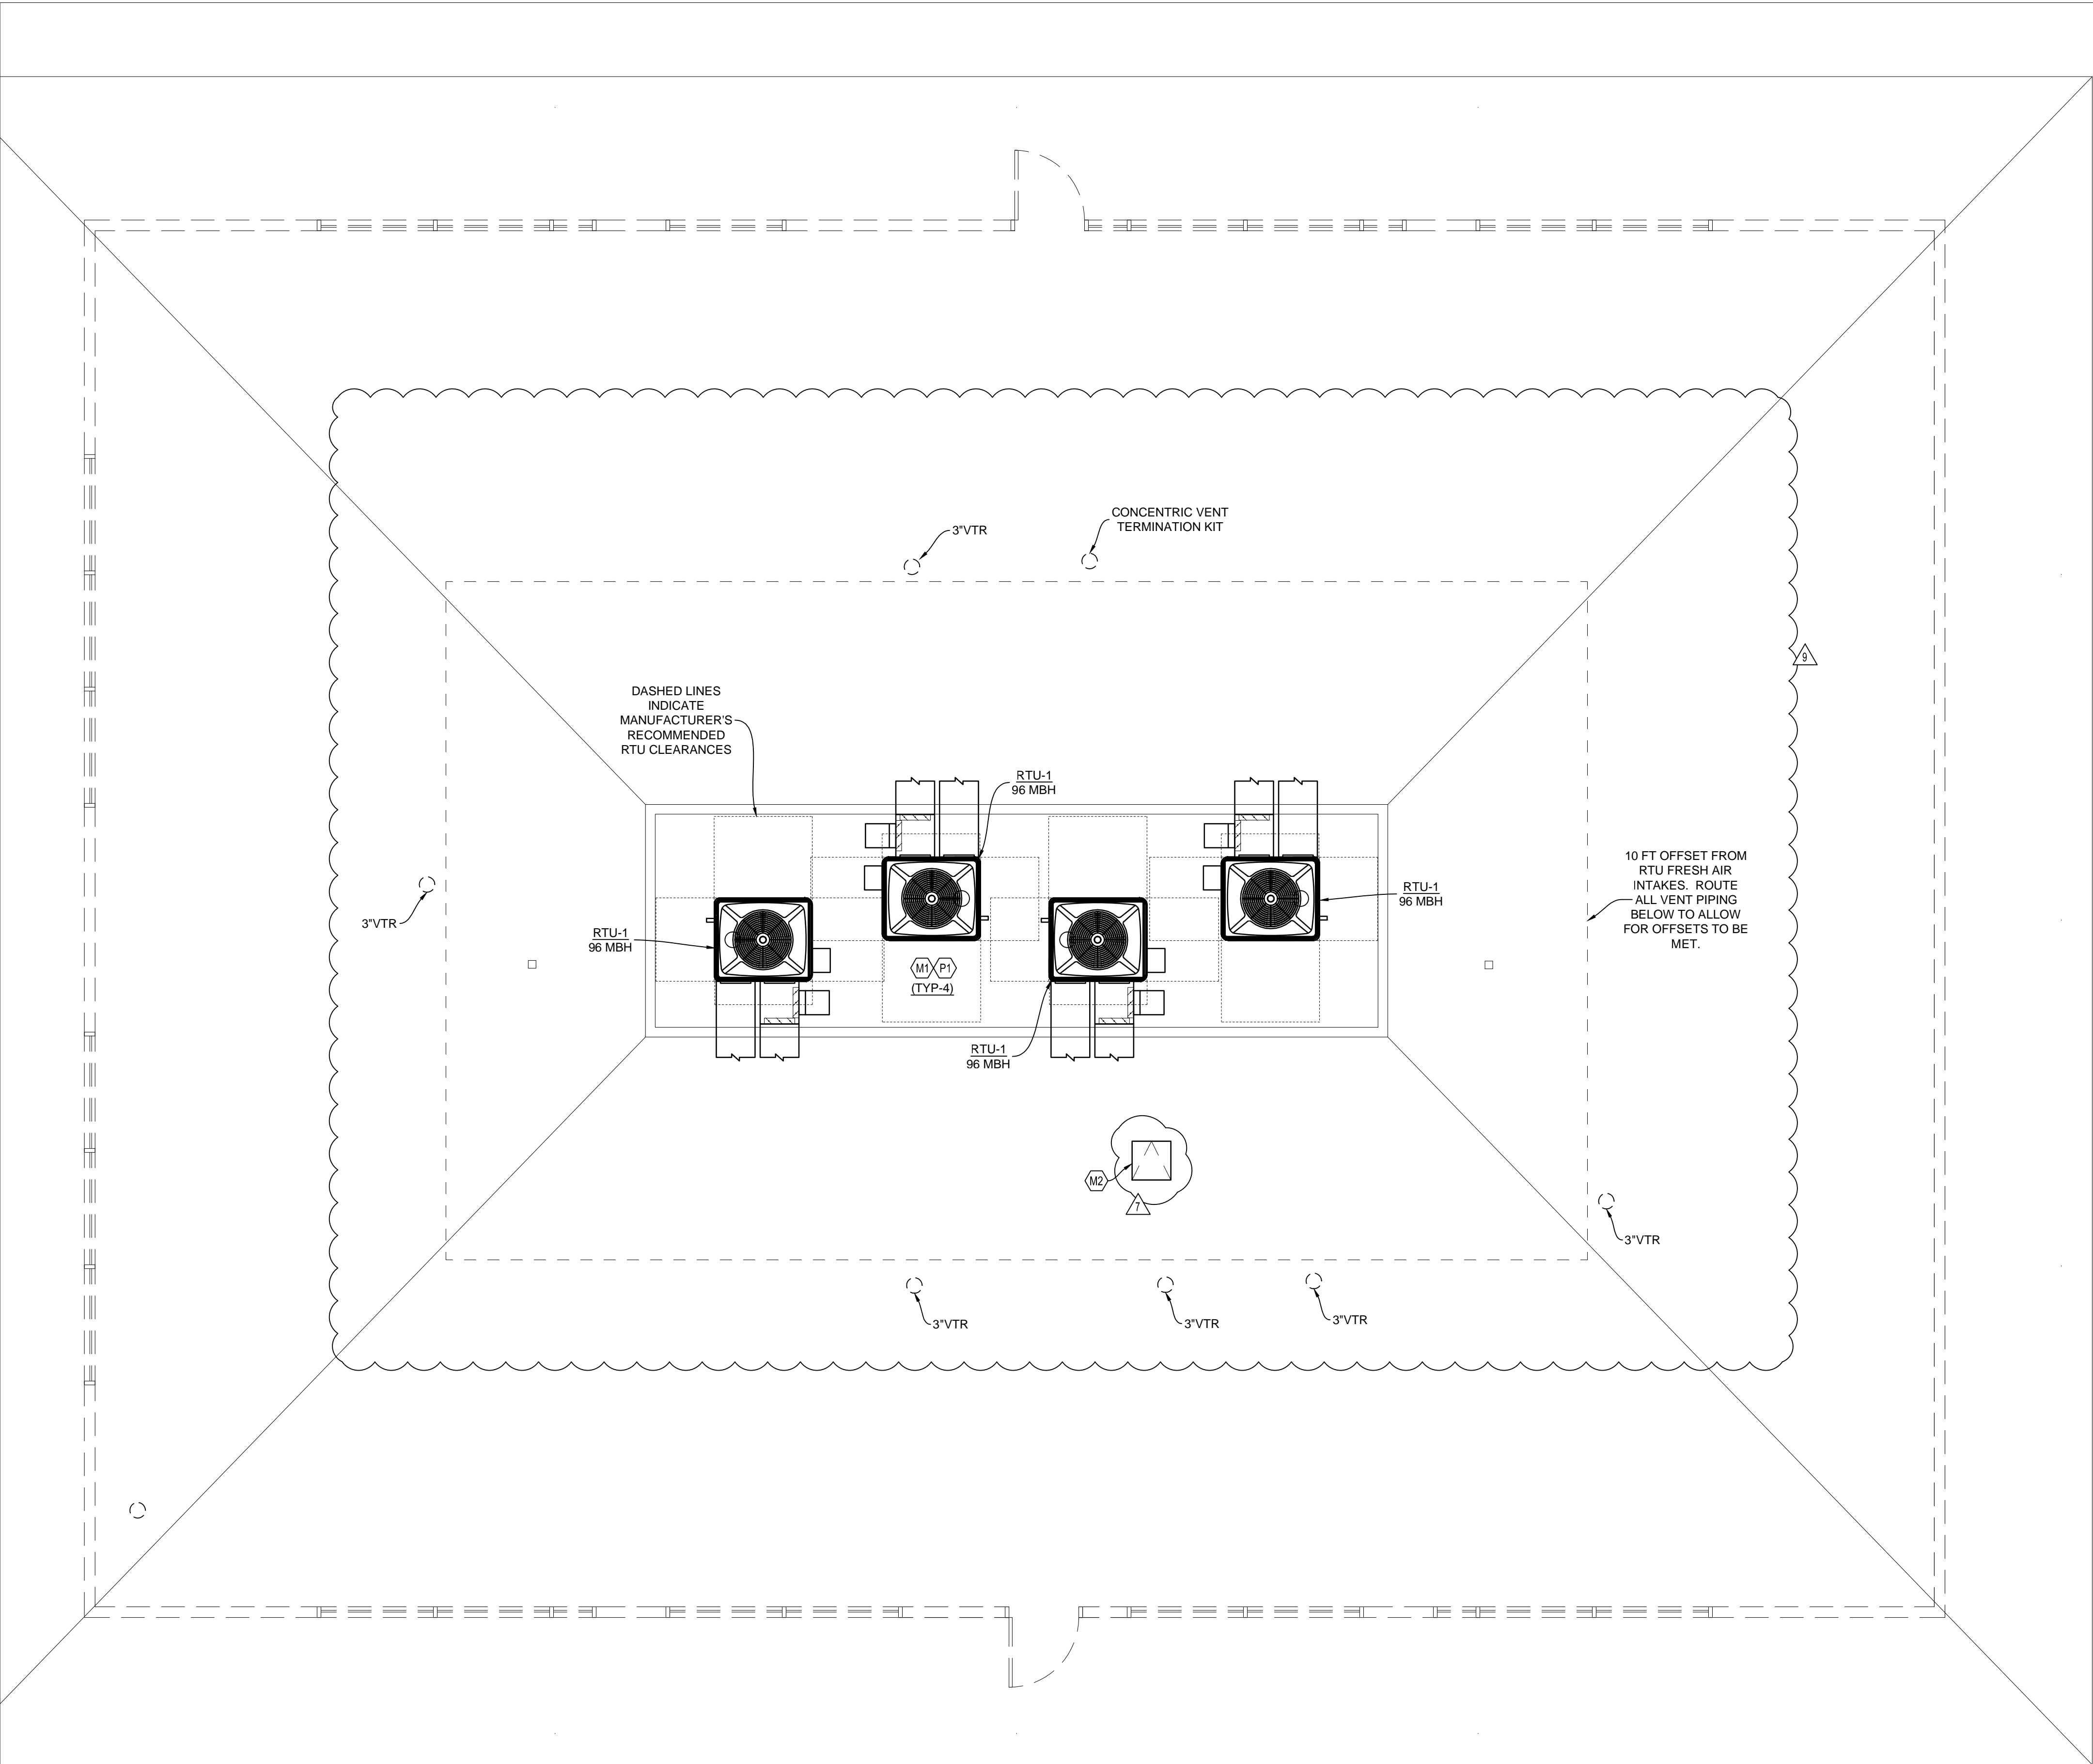

MECH/PLUMB ROOF PLAN-BLDG. 'C'
SCALE: 1/4" = 1'-0"

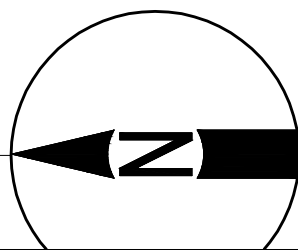

KEYED NOTES	
	MECHANICAL
M1	LOCATION OF NEW ROOFTOP UNIT. COORDINATION FINAL LOCATION WITH EXISTING STRUCTURE. PROVIDE FLEXIBLE CONNECTION ON SUPPLY AND RETURN DUCTWORK TO MINIMIZE VIBRATION. PROVIDE EQUIPMENT CURB WITH RTU.
M2	LOCATION OF ROOF ACCESS HATCH. HORIZONTAL ACCESS PATH TO SIDEWALL OF EXISTING EQUIPMENT WELL WITHIN ATTIC SPACE TO BE PROVIDED WHERE MAIN LEVEL CEILING ACCESS PANEL IS NOT LOCATED DIRECTLY BELOW EQUIPMENT WELL. REFERENCE ARCHITECTURAL PLANS FOR INSTALLATION DETAILS AND DIMENSIONS.
	PLUMBING
P1	ROUTE NEW GAS LINE TO UNDERSIDE OF ROOFTOP UNIT. PROVIDE GAS PRESSURE REGULATOR AND ISOLATION VALVE PER MANUFACTURER'S RECOMMENDATIONS.

GENERAL NOTES	
	1. PROVIDE NECESSARY EQUIPMENT CURBS/PLATFORMS FOR ALL EXTERIOR MECHANICAL EQUIPMENT.
	2. EXISTING PRIMARY AND OVERFLOW ROOF DRAINS TO REMAIN. COORDINATE LOCATIONS OF ROOFTOP UNITS ACCORDINGLY. REPLACE DAMAGED ROOF DRAINS AS REQUIRED.
	3. PROVIDE NECESSARY CLEARANCES TO ALLOW FOR SERVICE TO ALL ROOFTOP EQUIPMENT. COORDINATE RTU LOCATIONS WITH ROOF ACCESS HATCHES.
	4. ALL GAS PIPING SIZED PER TABLE 402.4(2) 2015 IFGC. GAS PRESSURE DOWNSTREAM OF METER IS LESS THAN 2 PSI.
	5. EXISTING VENT-THRU-ROOF LOCATIONS TO BE REUSED WHERE POSSIBLE. PROVIDE NEW VERTICAL VENT EXTENSIONS AS REQUIRED.
	6. ROUTE CONDENSATE LINES FROM RTUS TO NEARBY EXISTING ROOF DRAIN. PROVIDE FULL SIZE DRAIN LINE AND TRAP PER MANUFACTURER'S RECOMMENDATIONS.
	7. PROVIDE 10 FEET SEPARATION DISTANCE BETWEEN ALL RTU OUTSIDE AIR INTAKE LOCATIONS AND PLUMBING VENT TERMINATIONS.

Donald L. Welch
Architect
7533 Sandy Land Lane
Midvale, Utah 84047
801.548-6391
dwelch5977@msn.com




324 S. State St., Suite 400
Salt Lake City, UT 84111
801-328-5151
800-678-7077
fax: 801-328-5155
www.spectrum-engineers.com

THE DESIGNS SHOWN AND DESCRIBED HEREIN INCLUDING ALL TECHNICAL DRAWINGS, GRAPHIC REPRESENTATION & MODELS THEREOF, ARE PROPRIETARY & CAN NOT BE COPIED, DUPLICATED, OR COMMERCIALY EXPLOITED IN WHOLE OR IN PART WITHOUT THE SOLE AND EXPRESS WRITTEN PERMISSION FROM DONALD L. WELCH ARCHITECT

THESE DRAWINGS ARE AVAILABLE FOR LIMITED REVIEW AND EVALUATION BY CLIENTS CONSULTANTS, CONTRACTORS, GOVERNMENT AGENCIES, VENDORS, AND OFFICE PERSONNEL ONLY IN ACCORDANCE WITH THIS NOTICE.

consultant:

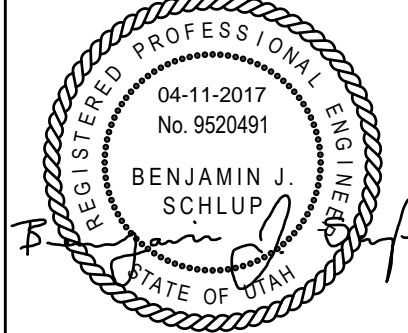

project:

Tenant Finish
for New
Brighton
Recovery
Campus
4905, 4911, 4915,
4925, 4931, & 4953
South 900 East
Salt Lake County,
Utah

date

April 11, 2017

revisions

- PERMIT SET-December 28, 2016
- ADDENDUM #1-January 04, 2017
- ADDENDUM #3-January 11, 2017
- ADDENDUM #4-January 17, 2017
- ADDENDUM #5-January 20, 2017
- ADDENDUM#7-February 24, 2017
- ADDENDUM#8 - March 20, 2017
- ADDENDUM#9 - April 11, 2017

data

project no:


drawn by:

checked by:

title

MECH/PLUMB
ROOF PLAN
BUILDING 'C'
sheet

MP1C
BUILDING 'C'

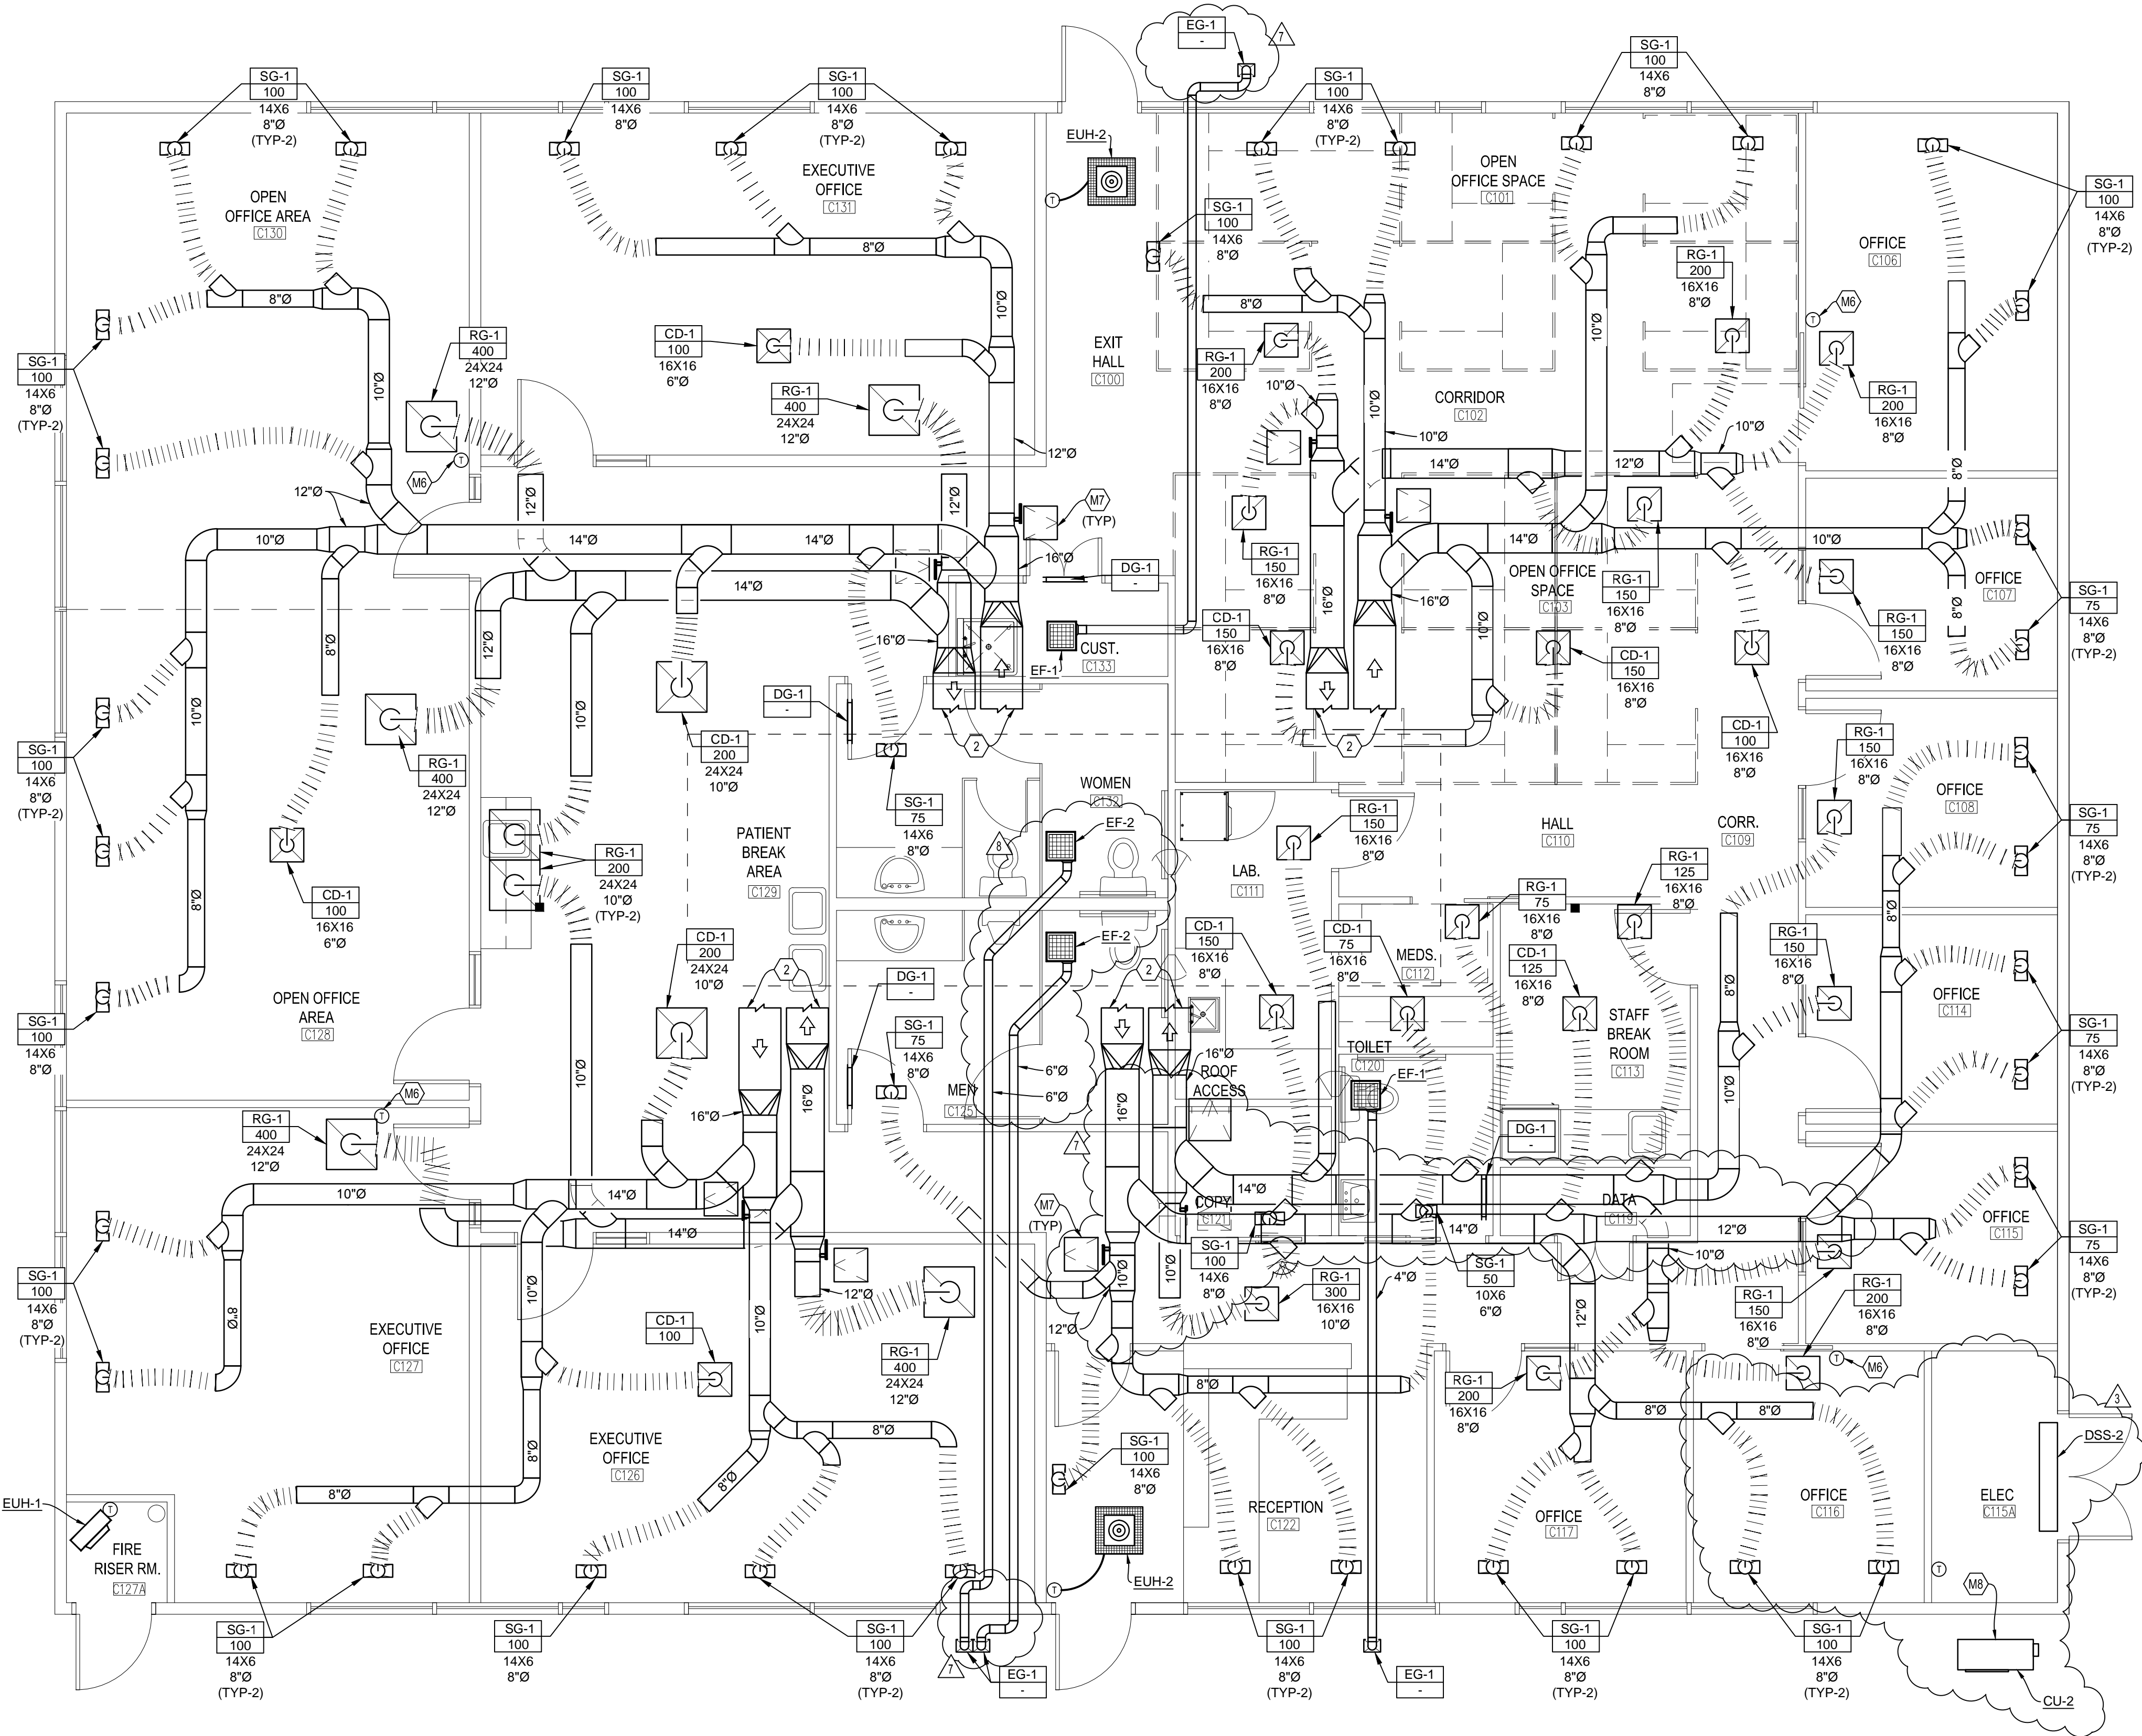

MECHANICAL PLAN-BLDG. 'C'
SCALE: 1/4" = 1'-0"

KEYED NOTES

- M1 INSTALL EXHAUST FAN AT THIS LOCATION. CONTINUE EXHAUST DUCT TO TERMINATE AT UNDERSIDE OF BUILDING OVERHANG AS INDICATED. COORDINATE LOCATION WITH OVERHEAD PLUMBING.
- M2 SEE ROOF PLAN FOR CONTINUATION OF SUPPLY AND RETURN AIR DUCTWORK.
- M3 LOCATION OF RECESSED DRYER VENT BOX. CONTINUE 4" DRYER DUCT TO TERMINATE AT UNDERSIDE OF BUILDING OVERHANG AS INDICATED.
- M4 RE-CIRCULATING KITCHEN HOOD.
- M5 PROVIDE TERMINATION KIT FOR DRYER EXHAUST AT THIS LOCATION.
- M6 LOCATION FOR DIGITAL THERMOSTAT WITHIN LOCKING ENCLOSURE.
- M7 ACCESS PANEL TO ALLOW FOR ADJUSTMENT TO ABOVE CEILING BALANCING DAMPER.
- M8 LOCATE OUTDOOR CONDENSING UNIT AS REQUIRED. PROVIDE CONCRETE EQUIPMENT PAD AS NECESSARY. SEE EQUIPMENT SCHEDULE FOR NECESSARY ACCESSORIES. CONCEAL ALL REFRIGERANT PIPING.

GENERAL NOTES

- PROVIDE BALANCING DAMPERS ON ALL GRILLES, REGISTERS, & DIFFUSERS CONNECTED TO A ROOFTOP UNIT. ALLOW FOR ADJUSTMENT BY REMOVAL OF EXHAUST GRILLES OR BY PROVIDING ACCESS PANELS. (TYPICAL)
- ROUTE SUPPLY AND RETURN AIR DUCTWORK THROUGH STRUCTURE AS REQUIRED. PROVIDE NECESSARY TRANSITIONS TO ALLOW FOR CLEAN PATH THE TERMINAL AIR DEVICES.
- PROVIDE WATER TIGHT SEAL ON ALL DUCTWORK AS IT PENETRATE EXTERIOR ROOFING/WALL ASSEMBLIES.
- PROVIDE (R-12 MIN.) INSULATION ON ALL ABOVE CEILING DUCTWORK ROUTED IN UNCONDITIONED SPACE.
- COORDINATE LOCATIONS OF CEILING GRILLES, REGISTERS, AND DIFFUSERS WITH OVERHEAD PLUMBING PIPING ROUTING.
- VENTILATION PROVIDED BY RTU ECONOMIZER SET TO 20% MIN. OSA
- ENVIRONMENTAL FANS SHALL NOT TERMINATE CLOSER THAN 3 FEET ADJACENT TO BUILDING OPENINGS.
- PROVIDE FIRE-RATED DAMPERS AT ALL CEILING DIFFUSERS AND GRILLES TO MAINTAIN FIRE-RATED ASSEMBLY.

Donald L. Welch
Architect
7533 Sandy Land Lane
Midvale, Utah 84047
801.548-6391
dwlch5977@msn.com




324 S. State St., Suite 400
Salt Lake City, UT 84111
800-678-7077
801-328-5151
fax: 801-328-5155
www.spectrum-engineers.com

THE DESIGNS SHOWN AND DESCRIBED HEREIN INCLUDING ALL TECHNICAL DRAWINGS, GRAPHIC REPRESENTATION & MODELS THEREOF, ARE PROPRIETARY & CAN NOT BE COPIED, DUPLICATED, OR COMMERCIALY EXPLOITED IN WHOLE OR IN PART WITHOUT THE SOLE AND EXPRESS WRITTEN PERMISSION FROM DONALD L. WELCH ARCHITECT

THESE DRAWINGS ARE AVAILABLE FOR LIMITED REVIEW AND EVALUATION BY CLIENTS, CONSULTANTS, CONTRACTORS, GOVERNMENT AGENCIES, VENDORS, AND OFFICE PERSONNEL ONLY IN ACCORDANCE WITH THIS NOTICE.

consultant:

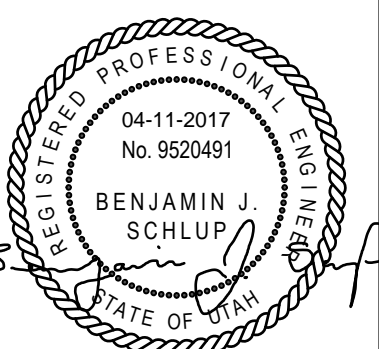

project:

Tenant Finish
for New
Brighton
Recovery
Campus
4905, 4911, 4915,
4925, 4931, & 4953
South 900 East
Salt Lake County,
Utah

date

April 11, 2017

revisions

- PERMIT SET-December 28, 2016
- ADDENDUM #1-January 04, 2017
- ADDENDUM #3-January 11, 2017
- ADDENDUM #4-January 17, 2017
- ADDENDUM #5-January 20, 2017
- ADDENDUM #7-February 24, 2017
- ADDENDUM #8 - March 20, 2017
- ADDENDUM #9 - April 11, 2017

data

project no:

drawn by:


checked by:

title

MECHANICAL
PLAN
BUILDING 'C'
sheet

M1C

BUILDING 'C'

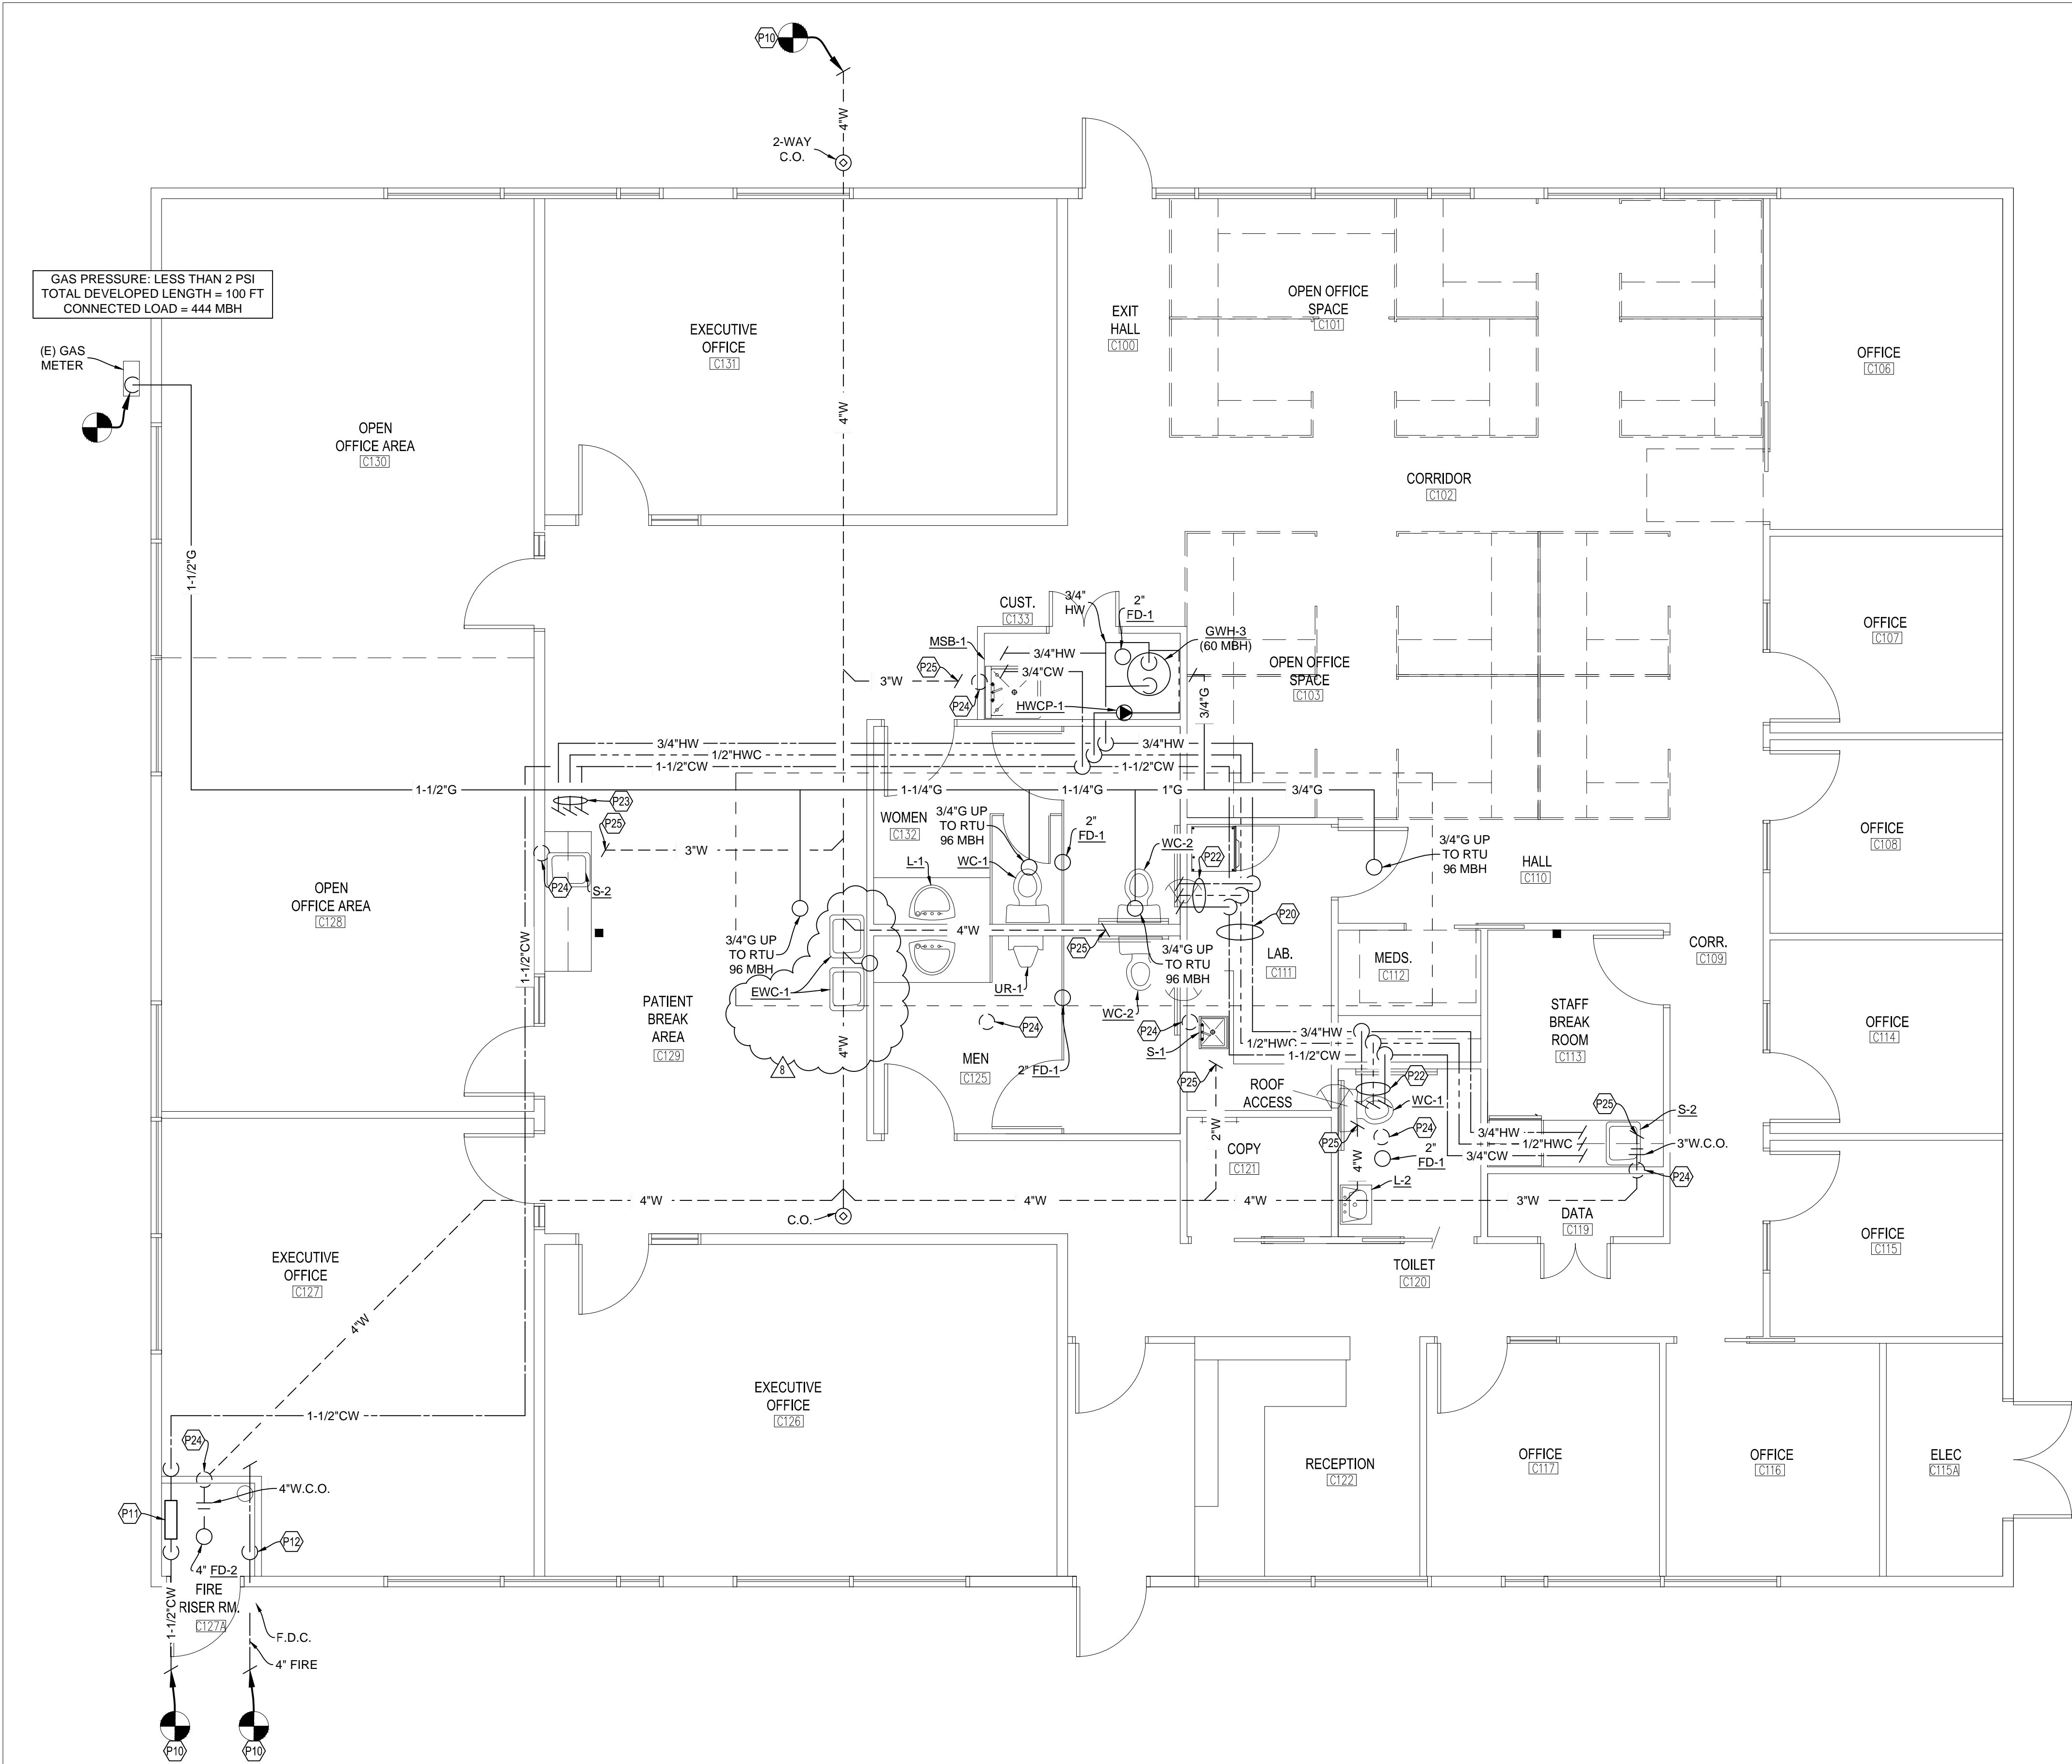

PLUMBING PLAN-BLDG. 'C'
SCALE: 1/4" = 1'-0"

KEYED NOTES

- P1 PROVIDE AIR ADMITTANCE VALVE WITHIN CABINETS AT THIS LOCATION. INSTALL PER MANUFACTURER'S RECOMMENDATIONS.
- P2 LOCATION OF HOT WATER CIRCULATION PUMP. INSTALL PER MANUFACTURER'S RECOMMENDATIONS. PROVIDE CIRCUIT SETTERS AT FIXTURES AS REQUIRED TO ALLOW FOR HOT WATER CIRCULATION.
- P3 NEW WATER HEATER. DIRECT T&P VALVE INTO FLOOR DRAIN. CONTINUE TO NEW FIXTURES AND PROVIDE ISOLATION VALVES AT EACH FIXTURE. PROVIDE GAS LINE ISOLATION VALVE AND SEISMIC BRACING. PROVIDE FLUE AND INTAKE PIPING PER SCHEDULE AND TERMINATE THROUGH ROOF WITH CONCENTRIC VENT KIT.
- P4 NEW URINAL. TIE INTO NEW WASTE. VENT, AND DOMESTIC COLD WATER PIPING. SEE PLUMBING SCHEDULE FOR FIXTURE PIPING SIZES.
- P5 NEW SINK. TIE INTO NEW WASTE. VENT, AND DOMESTIC HOT/COLD WATER PIPING. SEE PLUMBING SCHEDULE FOR FIXTURE PIPING SIZES.
- P6 NEW KITCHEN SINK. TIE INTO NEW WASTE. VENT, AND DOMESTIC HOT/COLD WATER PIPING. SEE PLUMBING SCHEDULE FOR FIXTURE PIPING SIZES. PROVIDE RECESSED WALL BOX FOR REFRIGERATOR COLD WATER CONNECTION. PROVIDE HOT WATER CONNECTION TO SERVE DISHWASHER.
- P7 LOCATION OF NEW WATER CLOSET. PROVIDE WATER, WASTE, & VENT CONNECTION. SEE PLUMBING SCHEDULE FOR FIXTURE PIPING SIZES.
- P8 LOCATION OF NEW LAVATORY. PROVIDE WATER, WASTE, & VENT CONNECTION. SEE PLUMBING SCHEDULE FOR FIXTURE PIPING SIZES.
- P9 LOCATION OF NEW FLOOR DRAIN. PROVIDE WASTE & VENT CONNECTION. SEE PLUMBING SCHEDULE FOR FIXTURE PIPING SIZES.
- P10 SEE CIVIL PLANS FOR CONTINUATION.
- P11 PROVIDE COLD WATER ENTRY WITH BACKFLOW PREVENTER. REFERENCE SHEET P02 FOR DEVICE MAKE/MODEL.
- P12 PROVIDE 4" FIRE ENTRY DOUBLE CHECK DETECTOR ASSEMBLY. REFERENCE SHEET P02 FOR DEVICE MAKE/MODEL. PROVIDE POWER (115V) FOR RISER MOUNTED COMPRESSOR & PRESSURE SWITCH. REFERENCE SHEET P13 FOR DETAILS. INSTALL COMPRESSOR ABOVE HEIGHT OF DOOR HEADER TO KEEP OUT OF TRAVEL PATH.
- P13 PROVIDE 3" VENT THROUGH ROOF.
- P14 PROVIDE WALL CLEANOUT AT THIS LOCATION.
- P15 PROVIDE GAS LINE WITH VENTLESS REGULATOR AND ISOLATION VALVE. CONNECT TO UNDERSIDE OF NEW RTU. NO ROOF PENETRATION REQUIRED WITH RTU MODEL SPECIFIED.
- P16 PROVIDE GAS LINE TO FLUELESS DECORATIVE FIREPLACE (20 MBH). INSTALL PER MANUFACTURER'S RECOMMENDATIONS.
- P17 PROVIDE EMERGENCY FUEL SHUTOFF SWITCH NEAR KITCHEN HOOD. SWITCH TO CLOSE GAS LINE SOLENOID VALVE ASSOCIATED WITH ALL GAS-FIRED APPLIANCES IN KITCHEN.
- P18 ROUTE 1/2" CW, HW, & HWC LINES BELOW FLOOR TO ISLAND KITCHEN SINK AT THIS LOCATION. EXTEND 1/2" HW LINE TO ADJACENT DISHWASHER.
- P19 ROUTE CW LINE TO REFRIGERATOR WATER CONNECTION. PROVIDED RECESSED WALL BOX WITH ISOLATION VALVE.
- P20 PROVIDE PIPING TRANSITIONS UNDER STRUCTURAL BEAM AS REQUIRED. (TYPICAL)
- P21 ROUTE CW, HW, & HWC LINES TO CLOTHES WASHER WALL BOX. PROVIDE INTEGRAL ISOLATION VALVES AND WATER HAMMER ARRESTOR.
- P22 ROUTE 1-1/2" CW, 3/4" HW, & 1/2" HWC LINES TO BATHROOM GROUP. PROVIDE HOT AND COLD WATER ISOLATION VALVES AT LAVATORIES.
- P23 ROUTE 3/4" CW, 3/4" HW, & 1/2" HWC LINES TO MOP SINK/SINK.
- P24 COMBINE VENT PIPING FROM BATHROOM FIXTURE AND TERMINATE THROUGH ROOF AT THIS LOCATION. MULTIPLE BATHROOMS GROUPS CAN BE GROUPED TO MINIMIZE ROOFING PENETRATIONS IF NEEDED. ALL VENT THROUGH ROOF PENETRATIONS TO BE 3" MINIMUM.
- P25 CONTINUE WASTE LINE TO ADJACENT FIXTURE GROUPS. REFERENCE PLUMBING FIXTURE SCHEDULE FOR INDIVIDUAL FIXTURE WASTE LINE SIZES.

Donald L. Welch
Architect
7533 Sandy Land Lane
Midvale, Utah 84047
801.548-6391
dwelch5977@msn.com




324 S. State St., Suite 400
Salt Lake City, UT 84111
800-678-7077
801-328-5151
fax: 801-328-5155
www.spectrum-engineers.com

THE DESIGNS SHOWN AND DESCRIBED HEREIN INCLUDING ALL TECHNICAL DRAWINGS, GRAPHIC REPRESENTATION & MODELS THEREOF, ARE PROPRIETARY & CAN NOT BE COPIED, DUPLICATED, OR COMMERCIALY EXPLOITED IN WHOLE OR IN PART WITHOUT THE SOLE AND EXPRESS WRITTEN PERMISSION FROM DONALD L. WELCH ARCHITECT

THESE DRAWINGS ARE AVAILABLE FOR LIMITED REVIEW AND EVALUATION BY CLIENTS, CONSULTANTS, CONTRACTORS, GOVERNMENT AGENCIES, VENDORS, AND OFFICE PERSONNEL ONLY IN ACCORDANCE WITH THIS NOTICE.

consultant:

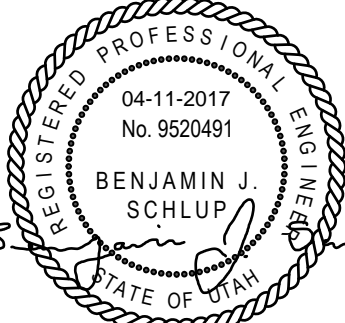

project:

Tenant Finish
for New
Brighton
Recovery
Campus
4905, 4911, 4915,
4925, 4931, & 4953
South 900 East
Salt Lake County,
Utah

date

April 11, 2017

revisions

- PERMIT SET-December 28, 2016
- ADDENDUM #1-January 04, 2017
- ADDENDUM #3-January 11, 2017
- ADDENDUM #4-January 17, 2017
- ADDENDUM #5-January 20, 2017
- ADDENDUM #7-February 24, 2017
- ADDENDUM #8 - March 20, 2017
- ADDENDUM #9 - April 11, 2017

data

project no:

drawn by:

checked by:

title

PLUMBING
PLAN
BUILDING 'C'
sheet

P1C

BUILDING 'C'