



## Review Comments #2

**Project:** Brighton Recovery Campus-Building F  
**Project No:** 20160686

**From:** Jason Worthen  
**Date:** March 20, 2017

---

### DISCIPLINES

Mechanical Engineering  
Electrical Engineering  
Technology Design  
Acoustical Engineering  
Lighting Design  
Theatre Design  
Fire Protection Engineering  
Building Commissioning

### CENTERS OF

### ENGINEERING EXCELLENCE

Healthcare  
Higher Education  
K-12 Education  
Government  
Houses of Worship  
Special Projects

### SALT LAKE CITY

324 S. State Street  
Suite 400  
Salt Lake City, UT 84111  
phone: 801-328-5151  
fax: 801-328-5155

### PHOENIX

1501 W. Fountainhead Parkway  
Suite 340  
Tempe, AZ 85282  
phone: 480-621-3444  
fax: 480-621-3445

www.spectrum-engineers.com  
800-678-7077

### BUILDING F RESPONSES

E2. Please address the following.

A. Locations of main disconnect panel.

PC2: Sheet EP601: Per NEC 225.32 the main panel in each building is required to have a disconnecting means located at the point of entrance of the building. It appears that each of the building panels are provided with main lugs only. Please provide a disconnect for each panel. This comment also applies to sheets EP602 and EP603.

Response: All branch panels will be changed to have main circuit breakers.

### BUILDING F DRAWINGS

#### EP601 (see attached sheet)

1. Changed all branch circuit panels from main lugs only to main circuit breaker panels.
2. Added panel LE2.

#### EP602 (see attached sheet)

1. Added panel AIC ratings to panel schedules.
2. Changed branch panels to have main circuit breakers.
3. Updated panel schedules.

#### EP603 (see attached sheet)

1. Added panel AIC ratings to panel schedules.
2. Changed branch panels to have main circuit breakers.
3. Updated panel schedules.
4. Added panel schedule for panel LE2.

SYMBOL LEGEND	
SYMBOL	DESCRIPTION
	DETAIL INDICATOR: A5 INDICATES DETAIL NUMBER, E-501 INDICATES DRAWING SHEET WHERE DETAIL IS SHOWN.
	ELEVATION OR SECTION INDICATOR, EXTERIOR: A5 INDICATES ELEVATION OR SECTION NUMBER, E-201 INDICATES DRAWING SHEET WHERE ELEVATION OR SECTION IS SHOWN.
	ROOM IDENTIFIER WITH ROOM NAME AND NUMBER.
	KEYNOTE INDICATOR.
	REVISION INDICATOR.
	EQUIPMENT INDICATOR.
	BREAK, STRAIGHT: TO BREAK PARTS OF DRAWING.
	BREAK, ROUND.
WIRING METHODS	
	WIRING.
	BRANCH CIRCUIT HOME RUN TO PANELBOARD: NUMBER OF ARROWS INDICATES NUMBER OF CIRCUITS. LETTER AND NUMBER NOTATIONS IDENTIFY PANEL AND CIRCUIT NUMBERS. USE #12 CONDUCTORS, EXCEPT #10 CONDUCTORS SHALL BE INSTALLED IF DISTANCES EXCEED THOSE SPECIFIED IN THE ELECTRICAL SPECIFICATIONS.
	BRANCH CIRCUIT HOME RUN TO PANELBOARD: NUMBER OF ARROWS INDICATES NUMBER OF CIRCUITS. LETTER AND NUMBER NOTATIONS IDENTIFY PANEL AND CIRCUIT NUMBERS. NUMBER IN BOX REFERS TO THE CONDUCTOR AND CONDUIT SCHEDULE. FOR BRANCH WIRING USE #12 CONDUCTORS, EXCEPT #10 CONDUCTORS SHALL BE INSTALLED IF DISTANCES EXCEED THOSE SPECIFIED IN THE ELECTRICAL SPECIFICATIONS.
	WIRING AND/OR RACEWAY: THIN LINE. WHERE "X" = : CATV = CABLE TELEVISION NC = NURSE CALL CCTV = CLOSED CIRCUIT P = POWER TELEVISION RC = RIGID CONDUIT FA = FIRE ALARM S = SOUND FO = FIBER OPTICS T = TELEPHONE I = INTERCOM TV = TELEVISION  OTHERS AS NOTED IN OTHER SCHEDULES. RACEWAYS AND WIRING SHALL BE SIZED AS SHOWN AND/OR SPECIFIED.
	CONDUIT STUB. DIMENSION RECORD DRAWINGS AND MARK.
	CONDUCTOR & CONDUIT ("CC") SCHEDULE INDICATOR. REFER TO ONE-LINE DIAGRAM.
	JUNCTION BOX.
	CABLE TRAY ABOVE ACCESSIBLE CEILING.
	LADDER RACK.
WIRING DEVICES	
	RECEPTACLE, SINGLE: NEMA 5-20R.
	RECEPTACLE, DUPLEX: NEMA 5-20R.
	RECEPTACLE, DUPLEX, ABOVE COUNTER: NEMA 5-20R.
	RECEPTACLE, DUPLEX, CEILING: NEMA 5-20R.
	RECEPTACLE, DUPLEX, DEDICATED CIRCUIT: NEMA 5-20R.
	RECEPTACLE, DUPLEX WITH GROUND FAULT CIRCUIT INTERRUPTER, DRINKING FOUNTAIN: CONCEAL WATER COOLER RECEPTACLE BEHIND WATER COOLER. SEE MECHANICAL/PLUMBING SHOP DRAWINGS FOR INSTALLATION REQUIREMENTS.
	RECEPTACLE, DUPLEX, SWITCHED: NEMA 5-20R.
	RECEPTACLE, DUPLEX, WEATHERPROOF: NEMA 5-20R.
	RECEPTACLE, DUPLEX ON EMERGENCY POWER: NEMA 5-20R.
	RECEPTACLE, DUPLEX WITH GROUND FAULT CIRCUIT INTERRUPTER, WEATHERPROOF: NEMA 5-20R.
	RECEPTACLE, QLADRAPLEX: NEMA 5-20R.
	RECEPTACLE, QLADRAPLEX ON EMERGENCY POWER: NEMA 5-20R.
	RECEPTACLE, QLADRAPLEX WITH GROUND FAULT CIRCUIT INTERRUPTER: NEMA 5-20R.
	RECEPTACLE, SPECIAL PURPOSE. PROVIDE RECEPTACLE TO MATCH EQUIPMENT PLUG.
	RECEPTACLE, SPECIAL PURPOSE ON EMERGENCY POWER. PROVIDE RECEPTACLE TO MATCH EQUIPMENT PLUG.
	RECEPTACLE, DRYER: NEMA 14-30R.
	RECEPTACLE, RANGE: NEMA 10-50R.
	MULTI-OUTLET ASSEMBLY: NEMA 5-20R.
	SWITCH, DIMMER.
	SWITCH, SINGLE POLE ("X" INDICATES FIXTURES CONTROLLED).
	SWITCH, THREE-WAY ("X" INDICATES FIXTURES CONTROLLED).

SYMBOL LEGEND	
SYMBOL	DESCRIPTION
ELECTRICAL POWER AND DISTRIBUTION	
	CIRCUIT BREAKER, MOLDED CASE (ONE-LINE DIAGRAM).
	TRANSFORMER (ONE-LINE DIAGRAM).
	PANELBOARD (ONE-LINE DIAGRAM).
	PANELBOARD WITH MAIN LUGS ONLY. BUS SIZE AND PHASE AS SHOWN (ONE-LINE DIAGRAM).
	TRANSITION CABINET (ONE-LINE DIAGRAM).
	CT CABINET PER UTILITY'S REQUIREMENTS (ONE-LINE DIAGRAM).
	SERVICE ENTRANCE SURGE PROTECTION (ONE-LINE DIAGRAM).
	METER.
	DISCONNECT SWITCH, FUSED.
	DISCONNECT SWITCH, UNFUSED.
	STARTER, COMBINATION WITH DISCONNECT SWITCH.
	STARTER OR MOTOR CONTROLLER.
	PANELBOARD CABINET, FLUSH MOUNTED.
	PANELBOARD CABINET, SURFACE MOUNTED, 1 SECTION.
	PANELBOARD CABINET, SURFACE MOUNTED, 2 SECTION.
	DISTRIBUTION PANEL OR SWITCHBOARD.
	LIGHTING RELAY, CONTACTOR PANEL, OR DIMMING ENCLOSURE.
	TRANSFORMER: NUMBER INDICATES KVA.
	MECHANICAL EQUIPMENT CONNECTION.
LIGHTING (REFER TO FIXTURE SCHEDULE FOR SYMBOLS)	
	FIXTURE IDENTIFICATION: (W-3) INDICATES FIXTURE TYPE AS SCHEDULED.
	FIXTURE IDENTIFICATION, EMERGENCY WITH BATTERY PACK, CONNECTED TO GENERATOR AS INDICATED: (W-3) INDICATES FIXTURE TYPE AS SCHEDULED.
	EGRESS DIRECTION ARROW.
	NIGHT LIGHT, DO NOT SWITCH.
LIGHTING CONTROL	
	OCCUPANCY SENSOR, DUAL TECHNOLOGY, OMNI-DIRECTIONAL, CEILING.
	OCCUPANCY SENSOR, DUAL TECHNOLOGY, WALL.
	OCCUPANCY SENSOR, DUAL TECHNOLOGY, DIRECTIONAL.
	VACANCY SENSOR, DUAL TECHNOLOGY.
STRUCTURED CABLING	
	TELEPHONE, WALL MOUNTED ("X" INDICATES QUANTITY OF CABLES).
	TELEPHONE, WALL MOUNTED: PAY PHONE.
	TELEPHONE, WALL MOUNTED: WALL PHONE.
	TWO-WAY EMERGENCY COMMUNICATION DEVICE PER IBC, WALL MOUNTED IN RECESSED BOX.
	OUTLET, DATA COMMUNICATION ("X" INDICATES QUANTITY OF CABLES).
	OUTLET, BUILDING STANDARD COMBINATION TELEPHONE/ DATA COMMUNICATION.
	TELEPHONE TERMINAL BOARD, FIRE TREATED PLYWOOD PAINTED.
	LAN RACK, FLOOR STANDING.
	DATA CABLE, CATEGORY 5 (ONE-LINE DIAGRAM).
	VOICE CABLE, CATEGORY 3 (ONE-LINE DIAGRAM).
	DATA CONNECTION: WIRELESS ACCESS POINT (WAP). REQUIRES (2) DATA DROPS PER DEVICE.
	DATA CONNECTION: WIRELESS ACCESS POINT (WAP). REQUIRES (2) DATA DROPS PER DEVICE.

SYMBOL LEGEND	
SYMBOL	DESCRIPTION
FIRE ALARM	
	FIRE SYSTEM ANNUNCIATOR.
	FIRE ALARM CONTROL PANEL, SEMI-RECESSED.
	FIRE ALARM NOTIFICATION POWER SUPPLY.
	CONTROL MODULE.
	MONITOR MODULE.
	FIRE ALARM MANUAL PULL STATION.
	MAGNETIC DOOR HOLDER.
	DETECTOR, SMOKE.
	DETECTOR, SMOKE, RESIDENTIAL. CONNECTED TO FIRE ALARM INITIATING LOOP. EMITS LOW-FREQUENCY ALARM.
	DETECTOR, SMOKE, DUCT WITH HOUSING AND SAMPLING TUBE.
	DETECTOR, HEAT.
	STROBE.
	ALARM, HORN/SPEAKER, WEATHERPROOF.
	ALARM, HORN/STROBE, ONE ASSEMBLY.
	DETECTOR, FLOW SWITCH: FLOW SWITCHES SHALL BE PROVIDED AND INSTALLED WITH FIRE SPRINKLER SYSTEM AND SHALL BE CONNECTED TO LOCATIONS SHOWN ON THE FIRE SPRINKLER SHOP DRAWINGS.
	DETECTOR, TAMPER SWITCH WITH VALVE: TAMPER SWITCHES SHALL BE PROVIDED AND INSTALLED WITH FIRE SPRINKLER SYSTEM AND SHALL BE CONNECTED TO LOCATIONS SHOWN ON THE FIRE SPRINKLER SHOP DRAWINGS.
	SMOKE DAMPER.
	FIRE AND SMOKE DAMPER.
	DETECTOR, CARBON MONOXIDE.
TECHNOLOGY SYSTEMS	
	SPEAKER, CEILING MOUNTED.
	EQUIPMENT CABINET.
	MEDIA CONNECTION PLATE.
	AUDIO/VISUAL OUTLET.
	TRANSIENT VOLTAGE SURGE SUPPRESSOR, AC LINE CONDITIONER.
NURSE CALL	
	JUNCTION BOX.
	CORRIDOR LIGHT.
	BATHROOM PULL CORD STATION.
	DUTY STATION.
	EMERGENCY ASSISTANCE CALL STATION.
	EMERGENCY ASSISTANCE CODE BLUE CALL STATION.
	PATIENT STATION.
	STAFF STATION.
	TOUCH SCREEN NURSE CALL MASTER STATION.
	ZONE LIGHT CONTROLLER.
	NURSE CALL AREA CONTROL UNIT & POWER SUPPLIES.
CCTV	
	CCTV CABLE, POWER.
	CCTV CABLE, VIDEO SIGNAL.
	CCTV HEADEND EQUIPMENT.
	CCTV MONITOR.
	CCTV CAMERA/ENCLOSURE WITH LENS, TYPICAL. SEE SCHEDULE.
	CCTV CAMERA WITH PAN, TILT AND ZOOM.
	PANNING CAMERA TRANSVERSE ANGLE.

SYMBOL LEGEND	
SYMBOL	DESCRIPTION
SECURITY	
	SECURITY CABLE. SEE EQUIPMENT SCHEDULE FOR CABLE TYPE.
	ACCESS CONTROL HEADEND EQUIPMENT.
	SECURITY CONTROL PANEL.
	INTRUSION DETECTION HEADEND EQUIPMENT.
	CARD ACCESS DOOR TYPE #1 OR AS NOTED. SEE SCHEDULE.
	CARD READER.
TV DISTRIBUTION	
	TV DISTRIBUTION CABLE, INDIVIDUAL DROPS.
	TV DISTRIBUTION CABLE, TRUNK.
	COMBINER.
	DIRECTIONAL COUPLER.
	DISTRIBUTION AMPLIFIER (ONE-LINE DIAGRAM).
	SPLITTER (ONE-LINE DIAGRAM).
	TV OUTLET.
	SATELLITE ANTENNA.
	TV ANTENNA (ONE-LINE DIAGRAM).
	TERMINATOR, 75 OHM (TV DISTRIBUTION).
DEFINITIONS	
NOTE: ALL DEFINITIONS MAY NOT BE USED.	
INDICATED: THE TERM "INDICATED" REFERS TO GRAPHIC REPRESENTATIONS, NOTES, OR SCHEDULES ON THE DRAWINGS, OTHER PARAGRAPHS OR SCHEDULES IN THE SPECIFICATIONS, AND SIMILAR REQUIREMENTS IN THE CONTRACT DOCUMENTS. WHERE TERMS SUCH AS "SHOWN", "NOTED", "SCHEDULED", AND "SPECIFIED" ARE USED, IT IS TO HELP THE READER LOCATE THE REFERENCE, NO LIMITATION ON LOCATION IS INTENDED.	
DIRECTED: TERMS SUCH AS "DIRECTED", "REQUESTED", "AUTHORIZED", "SELECTED", "APPROVED", "REQUIRED", AND "PERMITTED" MEAN "DIRECTED BY THE ENGINEER", "REQUESTED BY THE ENGINEER", AND SIMILAR PHRASES.	
APPROVED: THE TERM "APPROVED", WHERE USED IN CONJUNCTION WITH THE ENGINEER'S ACTION ON THE CONTRACTOR'S SUBMITTALS, APPLICATIONS, AND REQUESTS, IS LIMITED TO THE ENGINEER'S DUTIES AND RESPONSIBILITIES AS STATED IN GENERAL AND SUPPLEMENTARY CONDITIONS.	
FURNISH: THE TERM "FURNISH" IS USED TO MEAN "SUPPLY AND DELIVER TO THE PROJECT SITE, READY FOR UNLOADING, UNPACKING, ASSEMBLY, INSTALLATION, AND SIMILAR OPERATIONS."	
INSTALL: THE TERM "INSTALL" IS USED TO DESCRIBE OPERATIONS AT PROJECT SITE INCLUDING THE ACTUAL "UNLOADING, UNPACKING, ASSEMBLY, ERECTION, PLACING, ANCHORING, APPLYING, WORKING TO DIMENSION, FINISHING, CURING, PROTECTING, CLEANING, AND SIMILAR OPERATIONS."	
PROVIDE: THE TERM "PROVIDE" MEANS "TO FURNISH AND INSTALL, COMPLETE AND READY FOR THE INTENDED USE."	
INSTALLER: AN "INSTALLER" IS THE CONTRACTOR OR AN ENTITY ENGAGED BY THE CONTRACTOR, EITHER AS AN EMPLOYEE, SUBCONTRACTOR, OR SUB-SUBCONTRACTOR, FOR PERFORMANCE OF A PARTICULAR CONSTRUCTION ACTIVITY, INCLUDING INSTALLATION, ERECTION, APPLICATION, AND SIMILAR OPERATIONS. INSTALLERS ARE REQUIRED TO BE EXPERIENCED IN THE OPERATIONS THEY ARE ENGAGED TO PERFORM.	
TECHNOLOGY SYSTEMS: THE TERM "TECHNOLOGY SYSTEMS" IS USED TO DESCRIBE ALL LOW VOLTAGE SYSTEMS GENERALLY REFERRED TO AS "SPECIAL SYSTEMS". THESE SYSTEMS INCLUDE BUT ARE NOT NECESSARILY LIMITED TO ALL SYSTEMS WHICH UTILIZE VOLTAGES OF LESS THAN 71 VOLTS SUCH AS SOUND SYSTEMS, VIDEO SYSTEMS, TV SYSTEMS, SECURITY SYSTEMS, VOICE AND DATA CABLING SYSTEMS, ETC...	

## GENERAL ELECTRICAL NOTES

- CLARIFICATION METHODS: AT THE TIME OF BIDDING, BIDDERS SHALL FAMILIARIZE THEMSELVES WITH THE DRAWINGS AND SPECIFICATIONS. ANY QUESTIONS, MISUNDERSTANDINGS, CONFLICTS, DELETIONS, DISCONTINUED PRODUCTS, CATALOG NUMBER DISCREPANCIES, DISCREPANCIES BETWEEN THE EQUIPMENT SUPPLIED AND THE INTENT OR FUNCTION OF THE EQUIPMENT, ETC, SHALL BE SUBMITTED TO THE ARCHITECT/ENGINEER IN WRITING FOR CLARIFICATION PRIOR TO ISSUANCE OF THE FINAL ADDENDUM AND BIDDING OF THE PROJECT. WHERE DISCREPANCIES OR MULTIPLE INTERPRETATIONS OCCUR, THE MOST STRINGENT (WHICH IS GENERALLY RECOGNIZED AS THE MOST COSTLY) THAT MEETS THE INTENT OF THE DOCUMENTS SHALL BE ENFORCED.
- OWNER FURNISHED ITEMS: THE OWNER WILL FURNISH MATERIAL AND EQUIPMENT AS INDICATED IN THE CONTRACT DOCUMENTS TO BE INCORPORATED INTO THE WORK. THESE ITEMS ARE ASSIGNED TO THE INSTALLER AND COSTS FOR RECEIVING, HANDLING, STORAGE, IF REQUIRED, AND INSTALLATION ARE INCLUDED IN THE CONTRACT SUM.
  - THE INSTALLER'S RESPONSIBILITIES ARE THE SAME AS IF THE INSTALLER FURNISHED THE MATERIALS OR EQUIPMENT.
  - THE OWNER WILL ARRANGE AND PAY FOR DELIVERY OF OWNER FURNISHED ITEMS FREIGHT ON BOARD JOB SITE AND THE INSTALLER WILL INSPECT DELIVERIES FOR DAMAGE. IF OWNER FURNISHED ITEMS ARE DAMAGED, DEFECTIVE OR MISSING, DOCUMENT DAMAGED ITEMS WITH THE TRANSPORT COMPANY AND THE OWNER WILL ARRANGE FOR REPLACEMENT. THE OWNER WILL ALSO ARRANGE FOR MANUFACTURER'S FIELD SERVICES, AND THE DELIVERY OF MANUFACTURER'S WARRANTIES AND BONDS TO THE INSTALLER.
  - THE INSTALLER IS RESPONSIBLE FOR DESIGNATING THE DELIVERY DATES OF OWNER FURNISHED ITEMS AND FOR RECEIVING, UNLOADING AND HANDLING OWNER FURNISHED ITEMS AT THE SITE. THE INSTALLER IS RESPONSIBLE FOR PROTECTING OWNER FURNISHED ITEMS FROM DAMAGE, INCLUDING DAMAGE FROM EXPOSURE TO THE ELEMENTS, AND TO REPAIR OR REPLACE ITEMS DAMAGED AS A RESULT OF HIS OPERATIONS.
- EXPOSED STRUCTURE AREAS (EXCLUDING MECHANICAL, ELECTRICAL, AND COMMUNICATION SPACES): INSTALL RACEWAYS BETWEEN DECK AND STRUCTURE WHEREVER POSSIBLE IN EXPOSED STRUCTURE CEILING AREAS. ROUTE RACEWAYS IN CONCEALED AREAS WHEREVER POSSIBLE. REFER ALL CONDITIONS WHERE RACEWAYS MUST BE INSTALLED WHICH CANNOT COMPLY WITH THESE REQUIREMENTS TO THE ARCHITECT.
- SUBMITTALS: PROVIDE ORIGINAL ELECTRONIC PDF FORMAT, BOUND, BOOKMARKED (EACH SECTION AND PRODUCT), AND HIGHLIGHTED. JOB NAME AND SUBCONTRACTOR SHALL BE ON THE FRONT COVER. PREPARE INDEX OF EQUIPMENT SUBMITTED IN EACH TAB.
- REFLECTED CEILING PLANS: COORDINATE THE LOCATION OF LIGHT FIXTURES WITH THE ARCHITECTURAL REFLECTED CEILING PLANS. REFER ALL DISCREPANCIES TO THE ARCHITECT AND ENGINEER.
- ALL WORK SHALL BE DONE ACCORDINGS TO THE CURRENT NATIONAL ELECTRIC CODE (NEC), IBC, NFPA, AND IFC. COMPLIANCE AND FINAL APPROVAL IS SUBJECT TO THE ON SITE FIELD INSPECTION OF THE A.H.J.

## ELECTRICAL SHEET INDEX


SHEET NO	SHEET TITLE
EE001	SYMBOL SCHEDULE, SHEET INDEX
ES101	ELECTRICAL SITE PLAN
EP11F	POWER PLAN - BUILDING 'F'
EP401	TYPICAL POWER PLANS
EP501	DETAILS
EP502	DETAILS
EP503	DETAILS
EP601	ONE LINE DIAGRAM
EP602	PANEL SCHEDULES
EP603	PANEL SCHEDULES
EL11F	LIGHTING PLAN - BUILDING 'F'
EL601	LIGHTING FIXTURE SCHEDULE
EY11F	AUXILIARY PLAN - BUILDING 'F'
EY601	AUXILIARY RISER DIAGRAMS
EY602	AUXILIARY RISER DIAGRAMS
EY603	AUXILIARY RISER DIAGRAMS
FA11F	FIRE ALARM PLAN - BUILDING 'F'
FA601	FIRE ALARM RISER DIAGRAM

Donald L. Welch  
Architect  
7533 Sandy Land Lane  
Midvale, Utah 84047  
801.348.6381  
dwelch5977@msn.com

THE DESIGNS SHOWN AND DESCRIBED HEREIN INCLUDING ALL TECHNICAL DRAWINGS, GRAPHIC REPRESENTATION & MODELS THEREOF, ARE PROPRIETARY & CAN NOT BE COPIED, DUPLICATED, OR COMMERCIALY EXPLOITED IN WHOLE OR IN PART WITHOUT THE SOLE AND EXPRESS WRITTEN PERMISSION FROM DONALD L. WELCH ARCHITECT

THESE DRAWINGS ARE AVAILABLE FOR LIMITED REVIEW AND EVALUATION BY CLIENTS, CONSULTANTS, CONTRACTORS, GOVERNMENT AGENCIES, VENDORS, AND OFFICE PERSONNEL ONLY IN ACCORDANCE WITH THIS NOTICE.

## consultant:

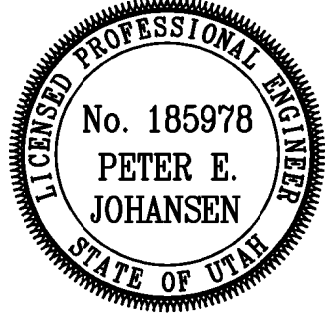

## project:

**Tenant Finish  
for New  
Brighton  
Recovery  
Campus**  
4905, 491, 4915, 4925,  
4931, & 4953 South 900  
East  
Salt Lake County, Utah

## date

January 04, 2017

## revisions

- PERMIT SET-December 28, 2016  
ADDENDUM #2-January 06, 2017  
ADDENDUM #3-January 11, 2017  
ADDENDUM #4-January 17, 2017  
ADDENDUM #5-January 19, 2017  
ADDENDUM #7-February 24, 2017  
ADDENDUM #8-March 20, 2017

## data

project no:

drawn by:

checked by:

## title


SYMBOL  
SCHEDULE,  
SHEET INDEX  
sheet

EE001

File Name: P:\2016\20160686\Drawings\3Sheet\Building F\86ES101.dwg Last Plotted: 2017/03/21 @ 8:59 AM By: jrw

1 ELECTRICAL SITE PLAN

SCALE: 1" = 20'-0"

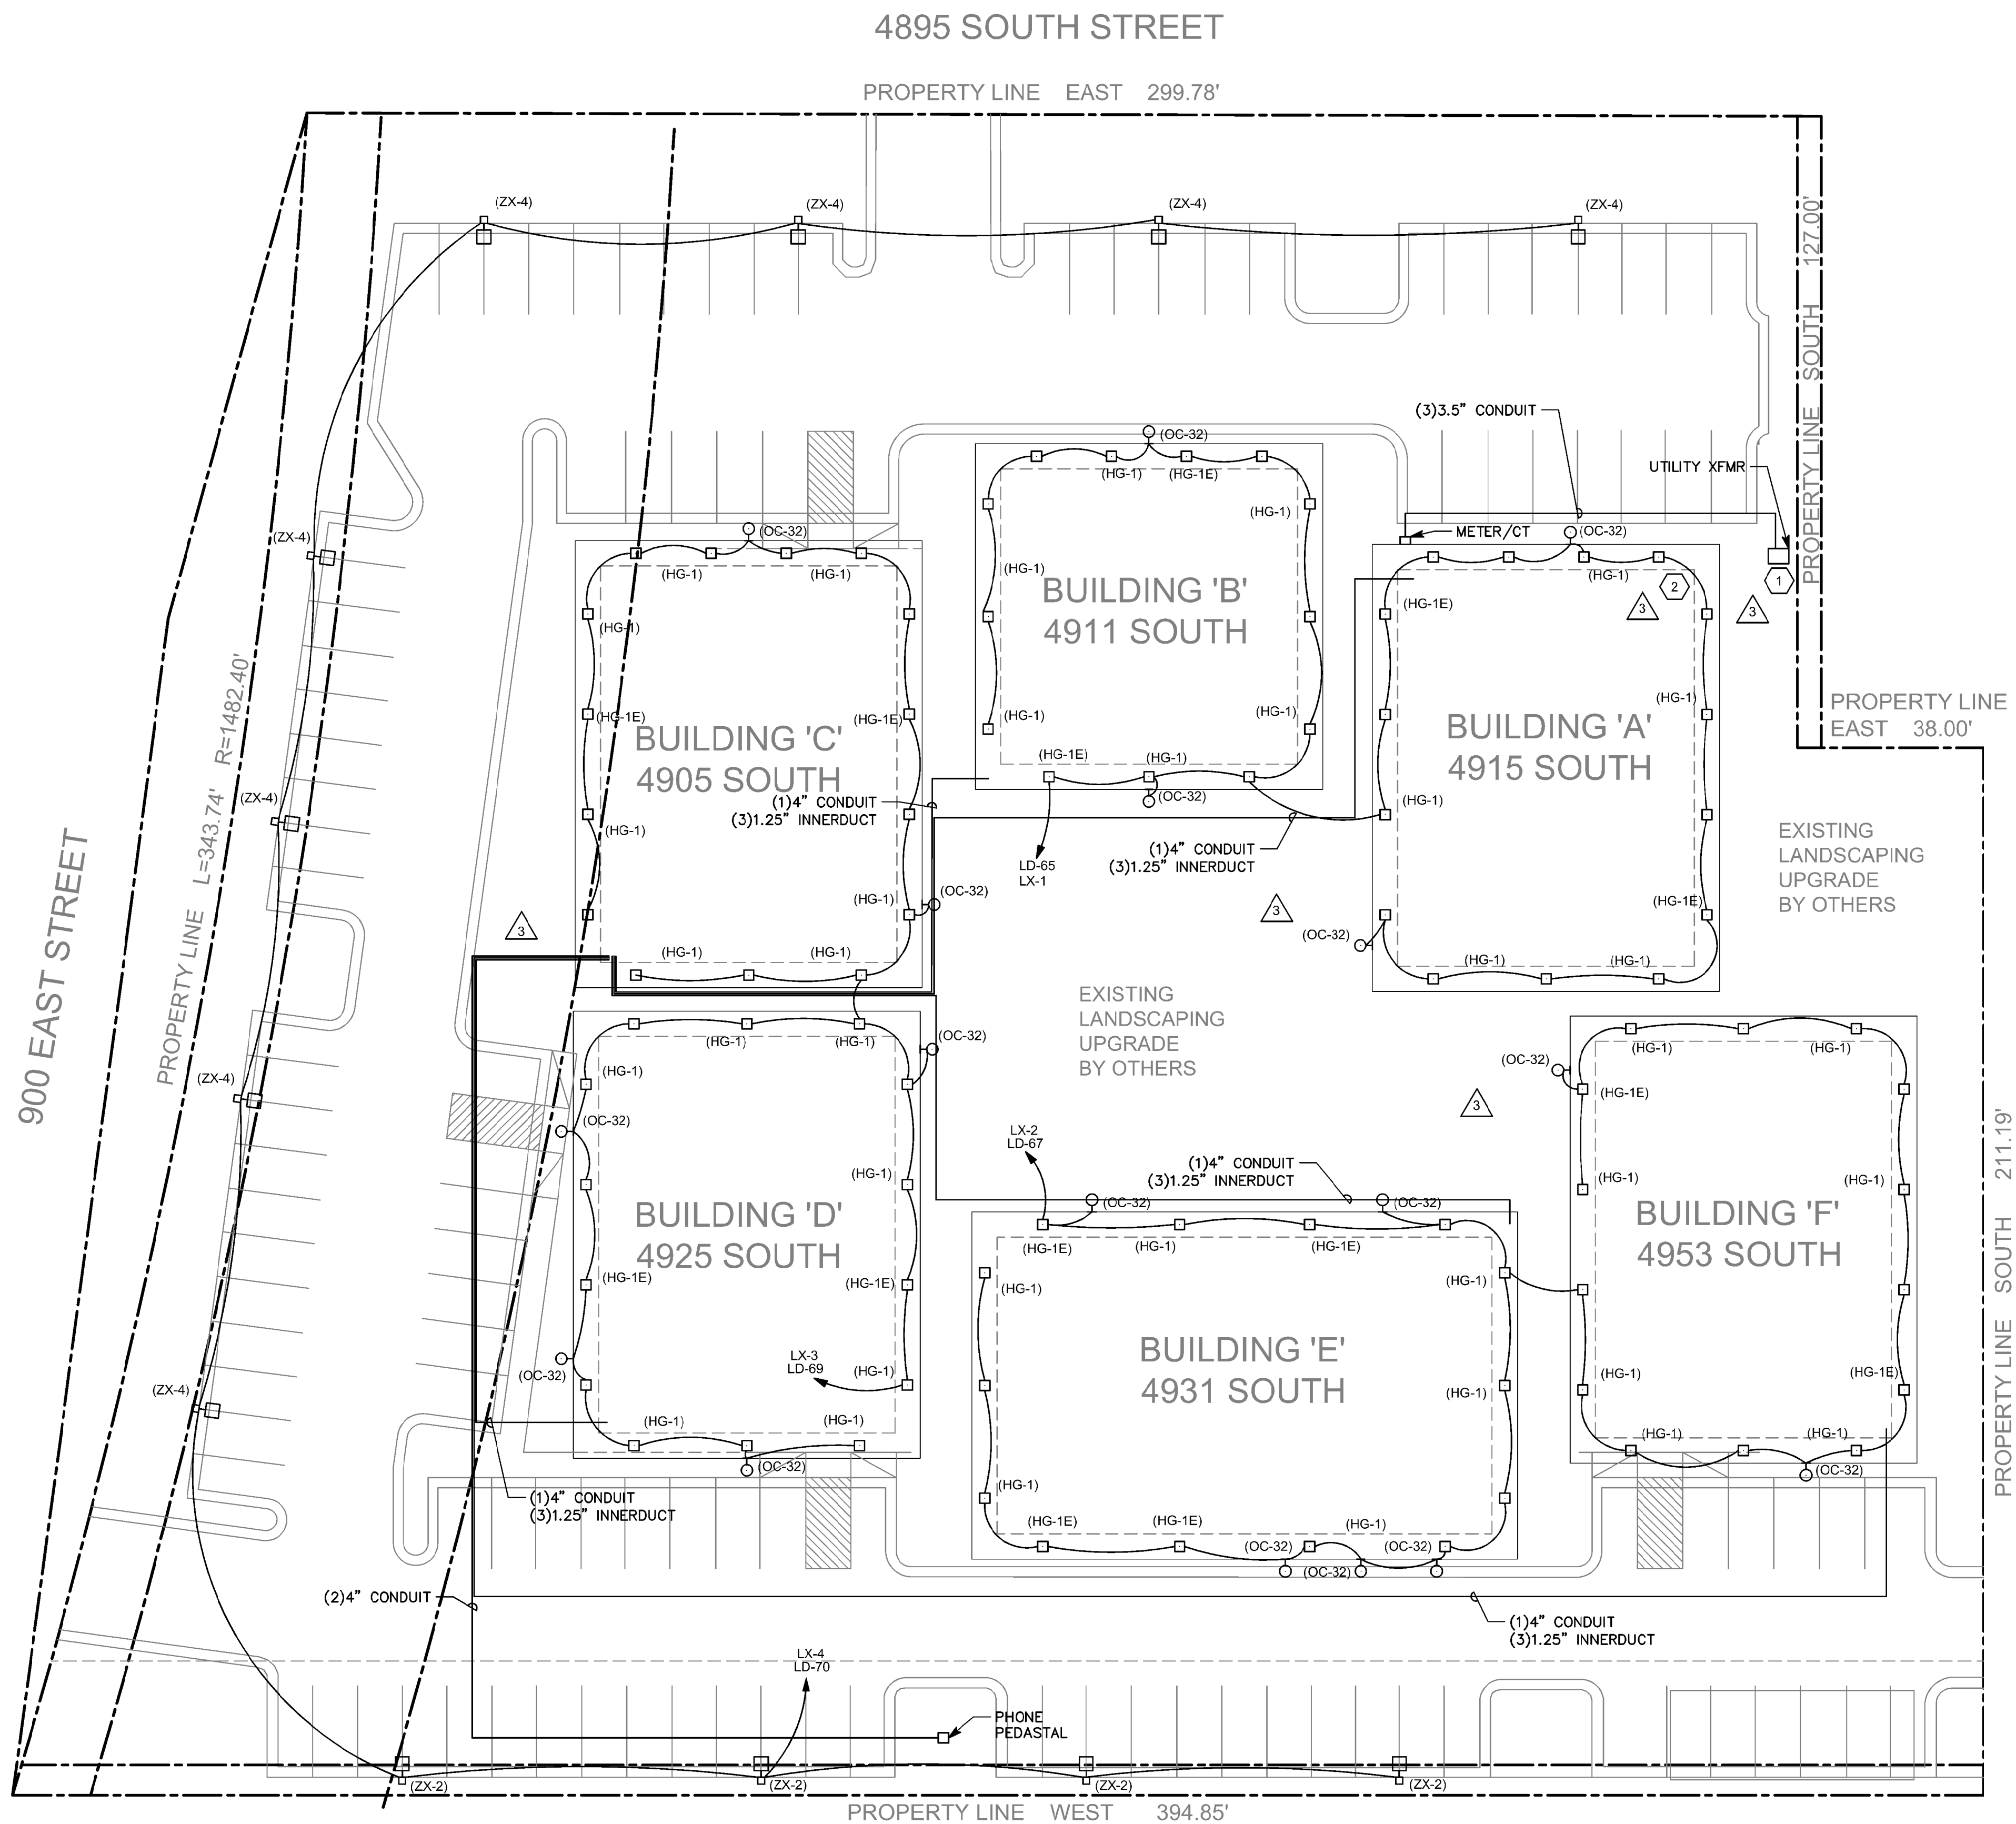

GENERAL SHEET NOTES

SHEET KEYNOTES


1. EXISTING ROCKY MOUNTAIN TRANSFORMER. COORDINATE WITH ROCKY MOUNTAIN POWER TO DETERMINE IF THE EXISTING TRANSFORMER NEEDS TO BE REPLACED.
2. THE EXISTING ELECTRICAL ROOM IS LOCATED IN NORTHEAST CORNER OF BUILDING A. ALL OF THE ELECTRICAL EQUIPMENT IN THIS ROOM IS TO BE DEMOLISHED, INCLUDING THE ELECTRICAL PANEL AND METER CENTER. REMOVE ALL ASSOCIATED WIRING BACK TO THE UTILITY TRANSFORMER.

Donald L. Welch  
Architect  
7533 Sandy Land Lane  
Midvale, Utah 84047  
801.548-6391  
dwelch5977@msn.com

THE DESIGNS SHOWN AND DESCRIBED HEREIN, INCLUDING ALL TECHNICAL DRAWINGS, GRAPHIC REPRESENTATION & MODELS THEREOF, ARE PROPRIETARY & CAN NOT BE COPIED, DUPLICATED, OR COMMERCIALY EXPLOITED IN WHOLE OR IN PART WITHOUT THE SOLE AND EXPRESS WRITTEN PERMISSION FROM DONALD L. WELCH ARCHITECT.

THESE DRAWINGS ARE AVAILABLE FOR LIMITED REVIEW AND EVALUATION BY CLIENTS CONSULTANTS, CONTRACTORS, GOVERNMENT AGENCIES, VENDORS, AND OFFICE PERSONNEL ONLY IN ACCORDANCE WITH THIS NOTICE.

consultant:

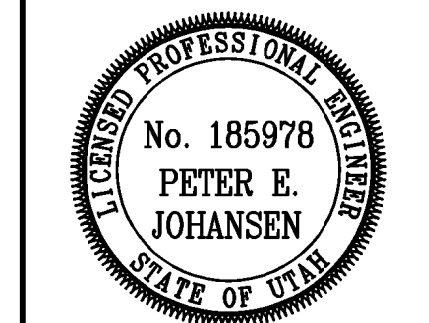

project:

Tenant Finish  
for New  
Brighton  
Recovery  
Campus  
4905, 4911, 4915, 4925,  
4931, & 4953 South 900  
East  
Salt Lake County, Utah

date

January 04, 2017

revisions

- PERMIT SET--December 28, 2016
- ADDENDUM #2--January 06, 2017
- ADDENDUM #3--January 11, 2017
- ADDENDUM #4--January 17, 2017
- ADDENDUM #5--January 19, 2017
- ADDENDUM #7--February 24, 2017
- ADDENDUM #8--March 20, 2017

data

project no:

drawn by:

checked by:

title

ELECTRICAL SITE  
PLAN

sheet


ES101

BUILDING 'F' 4953 South 900 East PARCEL #22081850130000



1 POWER PLAN - BUILDING 'F'

SCALE: 1/4"=1'-0"

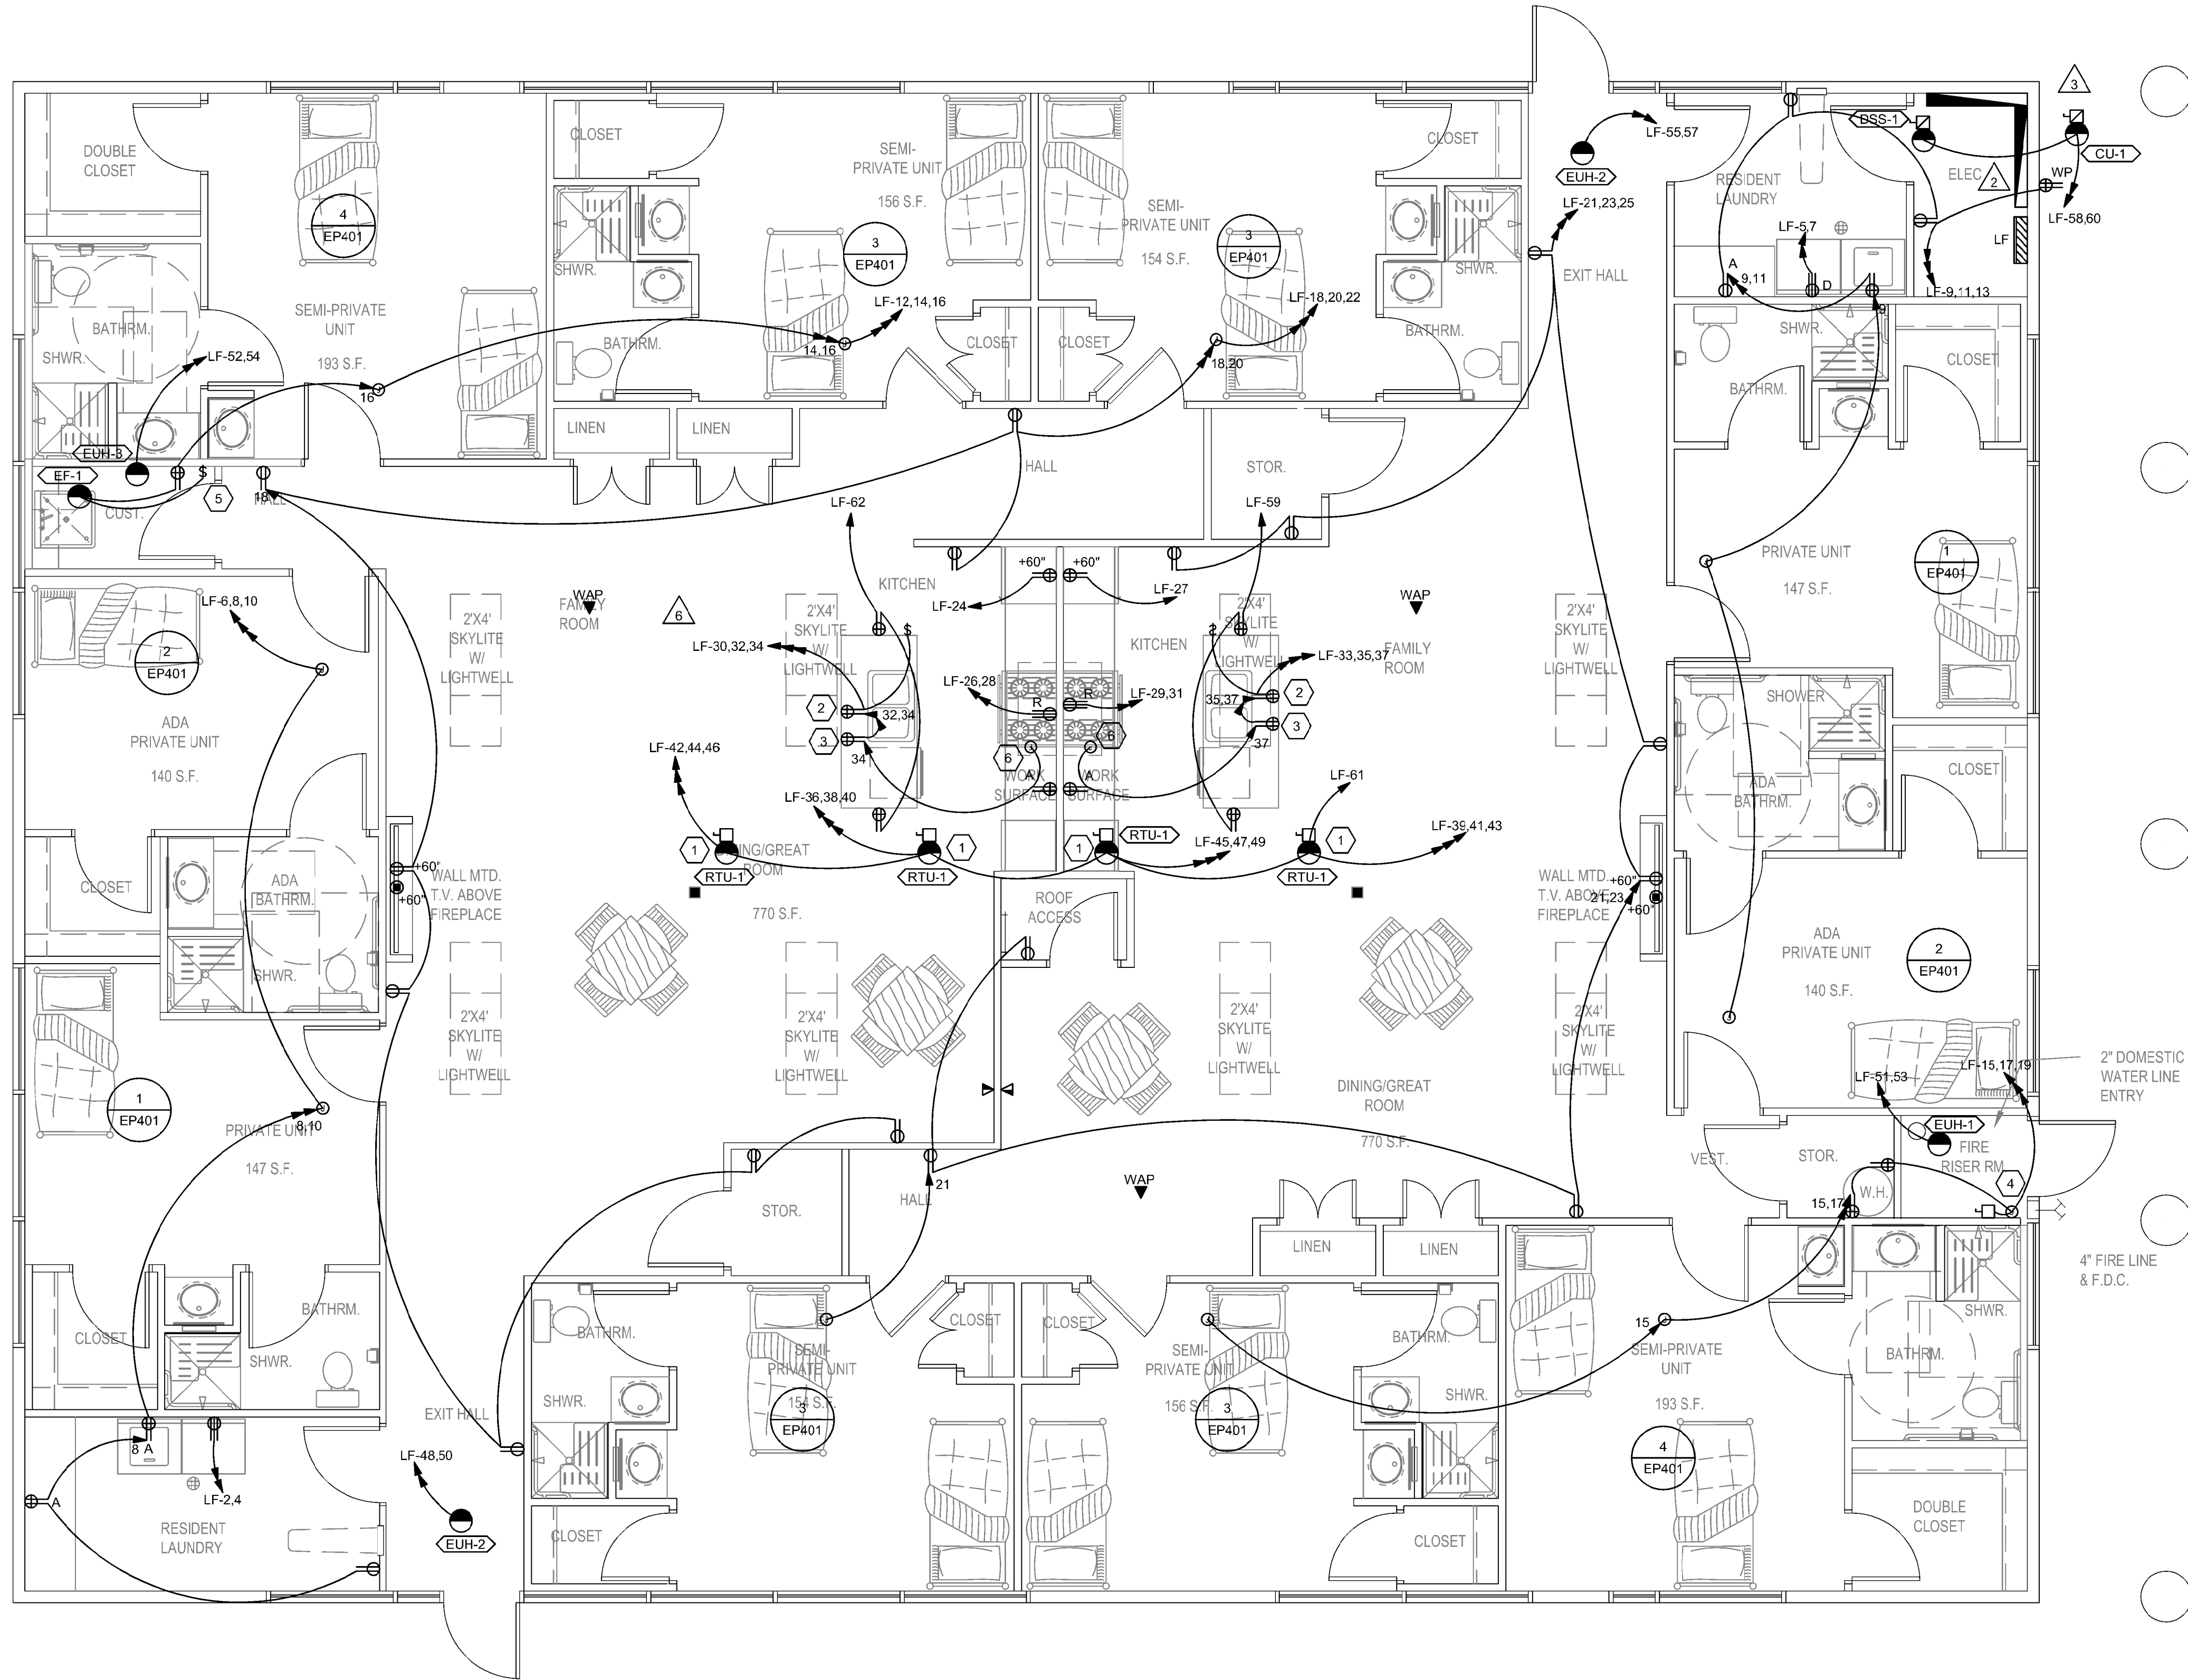

GENERAL SHEET NOTES

1. ALL BRANCH CIRCUITS FEEDING 15 AMP OR 20 AMP RECEPTACLES SHALL BE PROTECTED BY AN ARC FAULT CIRCUIT INTERRUPTER (ACFI) TYPE CIRCUIT BREAKER.
2. ALL RECEPTACLES SHALL BE TAMPER RESISTANT.

SHEET KEYNOTES


1. RTU LOCATED ON ROOF. PROVIDE 208/3 DEDICATD CIRCUIT FOR EACH RTU AND A 120/1 CIRCUIT FOR ALL CONVENIENCE OUTLETS INTEGRAL WITH RTU.
2. PROVIDE DEDICATED 120V SWITCHED CIRCUIT FOR GARBAGE DISPOSAL.
3. PROVIDE DEDICATED 120V CIRCUIT FOR DISHWASHER.
4. PROVIDE DEDICATED 120V CIRCUIT AND A 30/3P DISCONNECT FOR FIRE ENTRY FLOW SWITCH AND AIR COMPRESSOR.
5. PROVIDE A 20A/1P SWITCH TO CONTROL CUSTODIAN EXHAUST FAN.
6. PROVIDE 120V CIRCUIT AS SHOWN FOR EXHAUST HOOD.

Donald L. Welch  
Architect  
7533 Sandy Land Lane  
Midvale, Utah 84047  
801.346-6391  
dwelch5977@msn.com

THE DESIGNS SHOWN AND DESCRIBED HEREIN INCLUDING ALL TECHNICAL DRAWINGS, GRAPHIC REPRESENTATION & MODELS THEREOF, ARE PROPRIETARY & CAN NOT BE COPIED, DUPLICATED, OR COMMERCIALY EXPLOITED IN WHOLE OR IN PART WITHOUT THE SOLE AND EXPRESS WRITTEN PERMISSION FROM DONALD L. WELCH ARCHITECT.

THESE DRAWINGS ARE AVAILABLE FOR LIMITED REVIEW AND EVALUATION BY CLIENTS CONSULTANTS, CONTRACTORS, GOVERNMENT AGENCIES, VENDORS, AND OFFICE PERSONNEL ONLY IN ACCORDANCE WITH THIS NOTICE.

consultant:

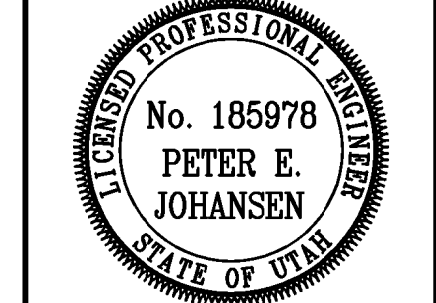

project:

**Tenant Finish  
for New  
Brighton  
Recovery  
Campus**  
4905, 4911, 4915, 4925,  
4931, & 4953 South 900  
East  
Salt Lake County, Utah

date

January 04, 2017

revisions

- PERMIT SET-December 28, 2016
- ADDENDUM #2-January 06, 2017
- ADDENDUM #3-January 11, 2017
- ADDENDUM #4-January 17, 2017
- ADDENDUM #5-January 19, 2017
- ADDENDUM #7-February 24, 2017
- ADDENDUM #8-March 20, 2017

data

project no:

drawn by:

checked by:

title


POWER PLAN -  
BUILDING 'F'

sheet


EP1 1F

BUILDING 'F' 4953 South 900 East PARCEL #22081850130000




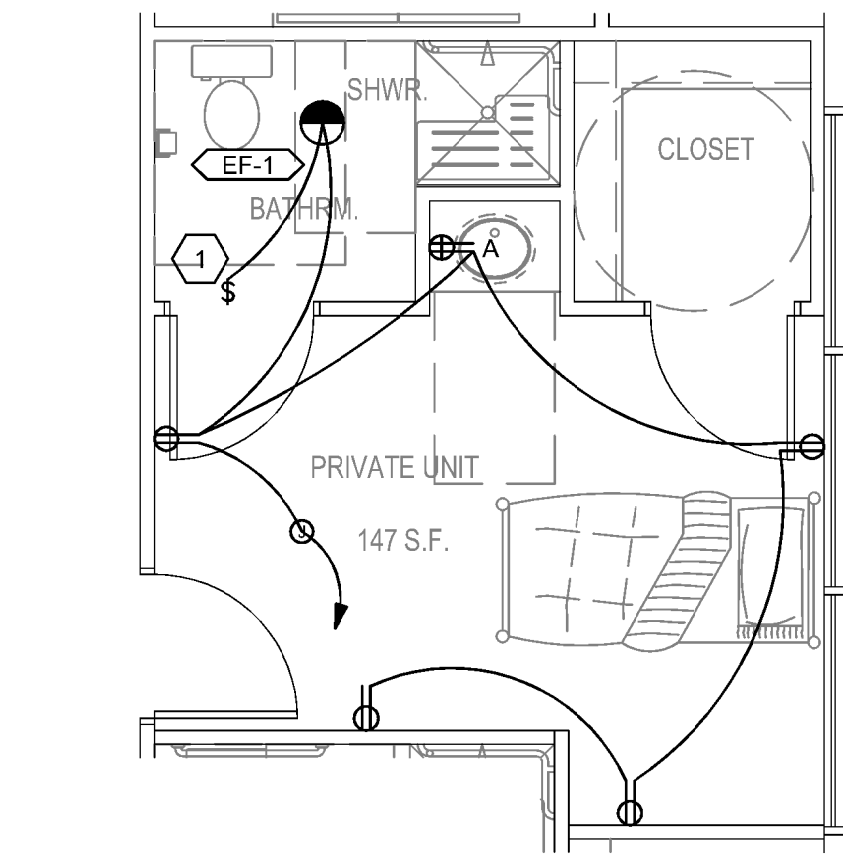


1  
TYPICAL PRIVATE UNIT  
POWER PLAN  
SCALE: 1/4"=1'-0"

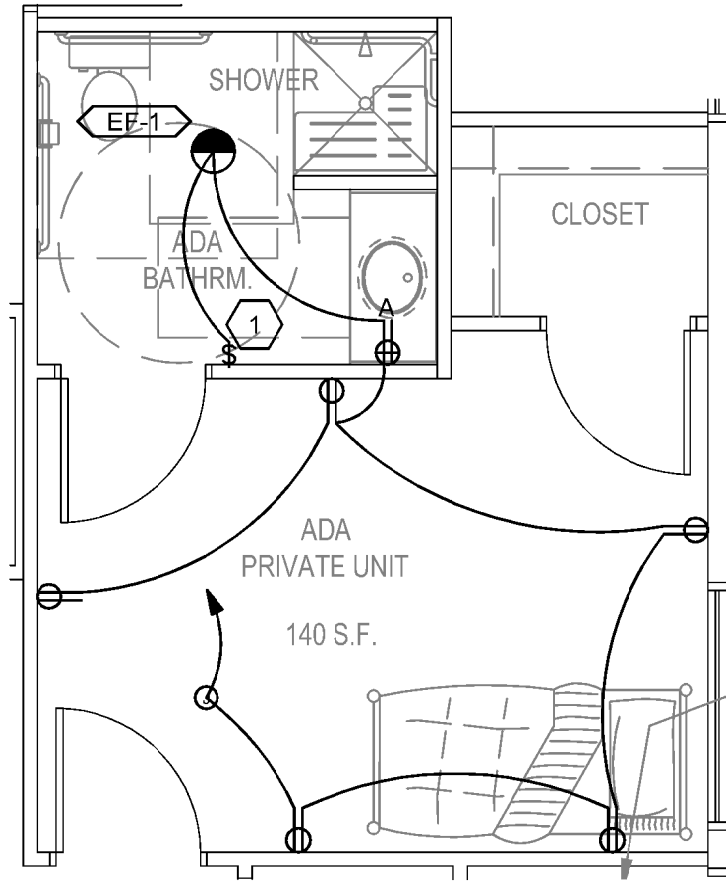

2  
TYPICAL ADA PRIVATE  
UNIT POWER PLAN  
SCALE: 1/4"=1'-0"

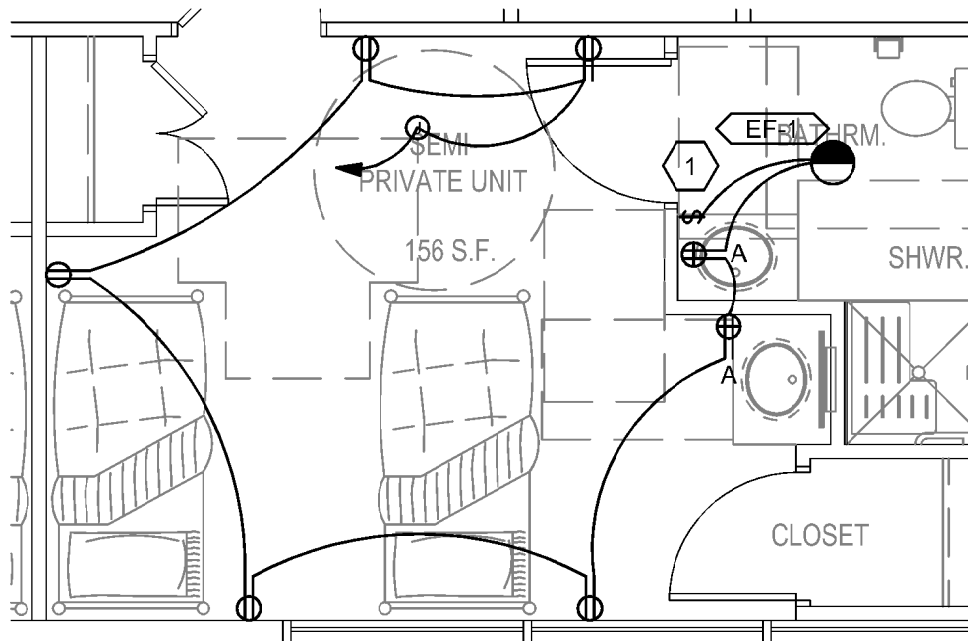

3  
TYPICAL SEMI-PRIVATE  
UNIT POWER PLAN  
SCALE: 1/4"=1'-0"

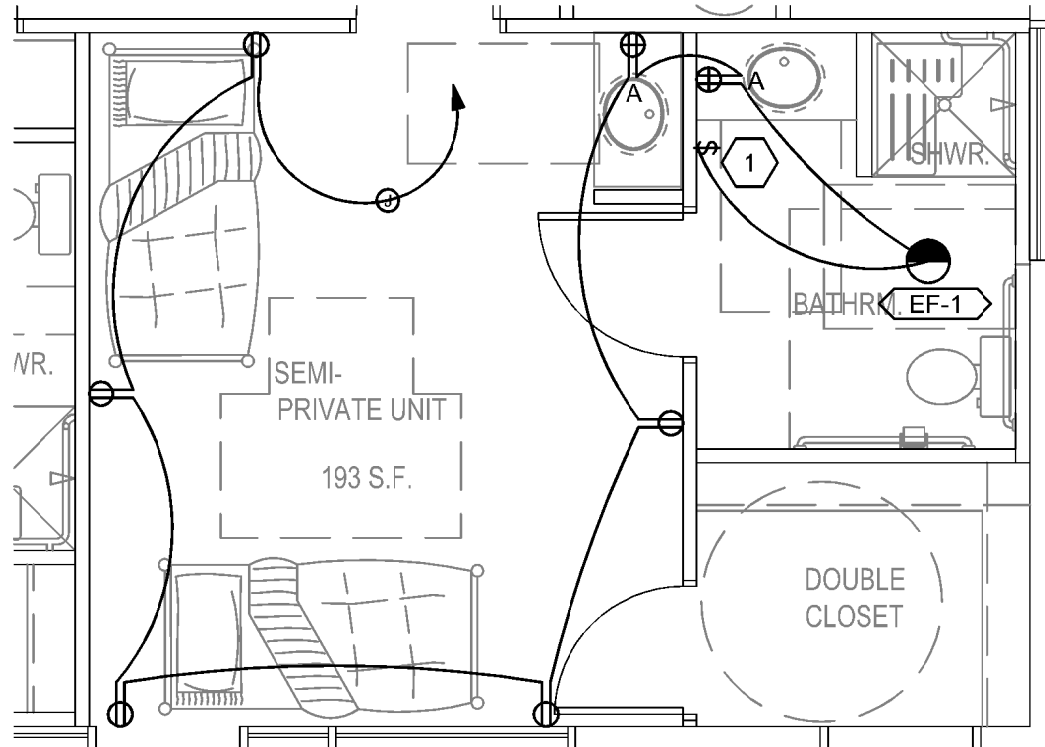

4  
TYPICAL ADA SEMI-PRIVATE  
UNIT POWER PLAN  
SCALE: 1/4"=1'-0"

GENERAL SHEET NOTES

1. ALL BRANCH CIRCUITS FEEDING 15 AMP OR 20 AMP RECEPTACLES SHALL BE PROTECTED BY AN ARC FAULT CIRCUIT INTERRUPTER (ACFI) TYPE CIRCUIT BREAKER.
2. ALL RECEPTACLES SHALL BE TAMPER RESISTANT.

SHEET KEYNOTES


1. PROVIDE A 20A/1P SWITCH TO CONTROL BATHROOM EXHAUST FAN.

Donald L. Welch  
Architect  
7533 Sandy Land Lane  
Midvale, Utah 84047  
801.346-6391  
dwelch5977@msh.com

THE DESIGNS SHOWN AND DESCRIBED HEREIN INCLUDING ALL TECHNICAL DRAWINGS, GRAPHIC REPRESENTATION & MODELS THEREOF, ARE PROPRIETARY & CAN NOT BE COPIED, DUPLICATED, OR COMMERCIALY EXPLOITED IN WHOLE OR IN PART WITHOUT THE SOLE AND EXPRESS WRITTEN PERMISSION FROM DONALD L. WELCH ARCHITECT

THESE DRAWINGS ARE AVAILABLE FOR LIMITED REVIEW AND EVALUATION BY CLIENTS CONSULTANTS, CONTRACTORS, GOVERNMENT AGENCIES, VENDORS, AND OFFICE PERSONNEL ONLY IN ACCORDANCE WITH THIS NOTICE.

consultant:

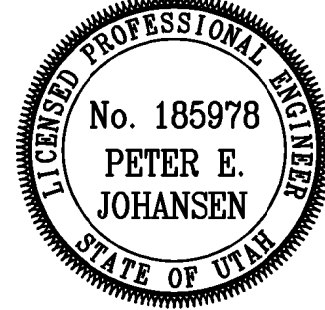

project:

Tenant Finish  
for New  
Brighton  
Recovery  
Campus  
4905, 4911, 4915, 4925,  
4931, & 4953 South 900  
East  
Salt Lake County, Utah

date

January 04, 2017

revisions

- PERMIT SET--December 28, 2016
- ADDENDUM #2--January 06, 2017
- ADDENDUM #3--January 11, 2017
- ADDENDUM #4--January 17, 2017
- ADDENDUM #5--January 19, 2017
- ADDENDUM #7--February 24, 2017
- ADDENDUM #8--March 20, 2017

data

project no:

drawn by:


checked by:

title

TYPICAL POWER  
PLANS

sheet

EP401

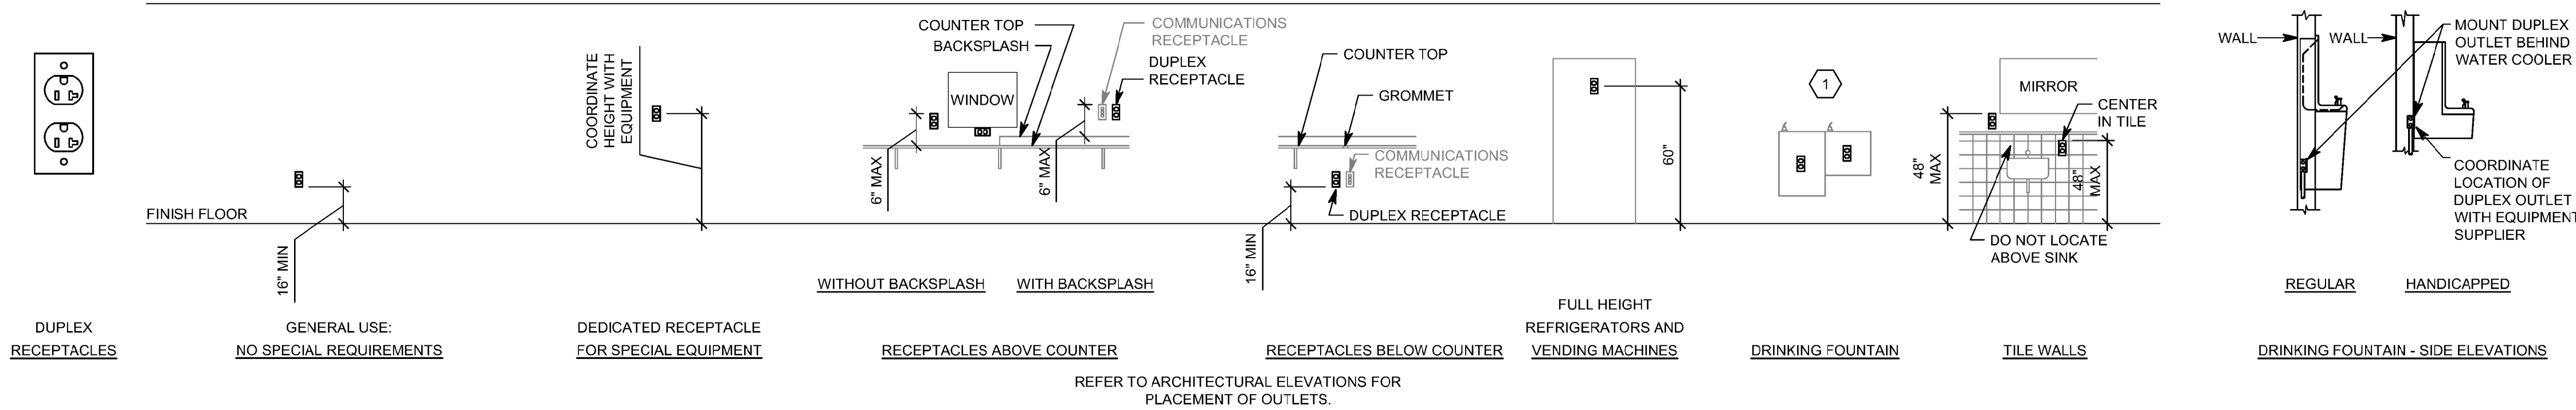


## 7 RECEPTACLE MOUNTING DETAILS

## GENERAL SHEET NOTES


1. DETERMINE MOUNTING HEIGHTS OF ELECTRICAL AND ELECTRONIC EQUIPMENT IN THE FOLLOWING ORDER OF PRIORITY:  
1 - ELEVATIONS (ARCHITECTURAL, ELECTRICAL, MECHANICAL, ETC).  
2 - EQUIPMENT SHOP DRAWINGS.  
3 - FIELD INSTRUCTIONS.
2. LOCATE RECEPTACLES SERVING THE SAME TYPE OF USE AT A UNIFORM HEIGHT UNLESS DIRECTED OTHERWISE.
3. MECHANICAL, ELECTRICAL, AND COMMUNICATION ROOMS: COORDINATE LOCATION OF LIGHTING AND POWER RECEPTACLES WITH EQUIPMENT, PIPING, AND DUCTWORK. DO NOT INSTALL RECEPTACLES BEHIND EQUIPMENT OR WHERE OTHERWISE INACCESSIBLE. POSITION LIGHTING REGARDLESS OF WHERE SHOWN ON DRAWING TO PROVIDE PROPER ILLUMINATION.
4. MOUNT RECEPTACLE BOXES FOR SWITCHES AND RECEPTACLES WITH LONG AXIS OF THE DEVICE VERTICAL UNLESS OTHERWISE INDICATED.
5. SET BOXES WITH PLASTER RINGS FLUSH WITH FINISHED SURFACE.
6. LOCATE BOX COVERS OR DEVICE PLATES SO THEY WILL NOT SPAN DIFFERENT TYPES OF BUILDING FINISHES EITHER VERTICALLY OR HORIZONTALLY.
7. VERIFY ALL DOOR CONDITIONS ON ARCHITECTURAL DRAWINGS PRIOR TO INSTALLING SWITCHES.
8. LOCATE WIRING DEVICES WHICH ARE ADJACENT AND ARE COMPATIBLE VOLTAGES IN ONE PLATE.

## SHEET KEYNOTES


1. LOCATE RECEPTACLES BEHIND DRINKING FOUNTAINS.
2. REFER TO ARCHITECTURAL ELEVATIONS FOR PLACEMENT OF OUTLETS.
3. LOCATE AT BOTTOM OF BEAMS IF D < 1H AND W < 4H OR AT CEILING FOR LEVEL CEILINGS. FOR PAN-TYPE CEILINGS, CORRIDORS, SMALL ROOMS, SLOPED/BEAMED CEILINGS, AND OTHER CONDITIONS, REFER TO NFPA 72.
4. LOCATE DETECTOR ANYWHERE IN SHADED AREA BUT NOT IN TOP 4" OF PEAK.
5. LOCATE AT BOTTOM OF BEAMS IF D/H < 1 OR W/H < 4; OTHERWISE, LOCATE IN BEAM POCKET. FOR D > 4 REDUCE SPACING .33 PERPENDICULAR TO BEAMS.

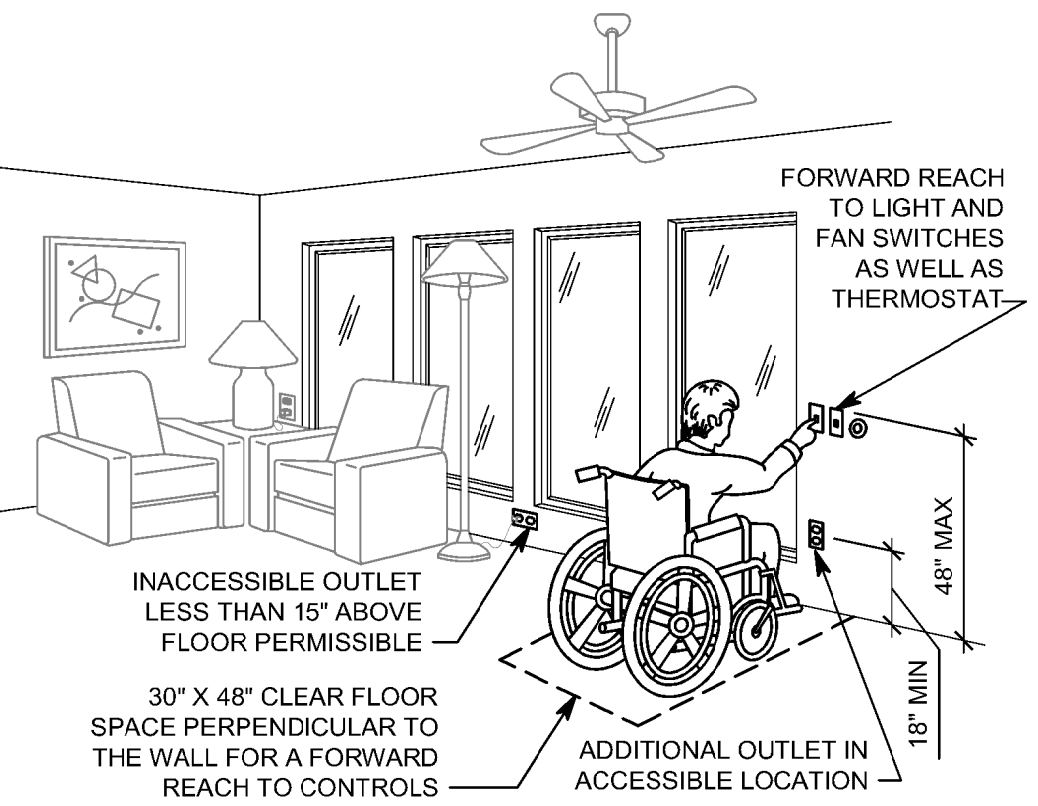


## 5 ADA DETAIL

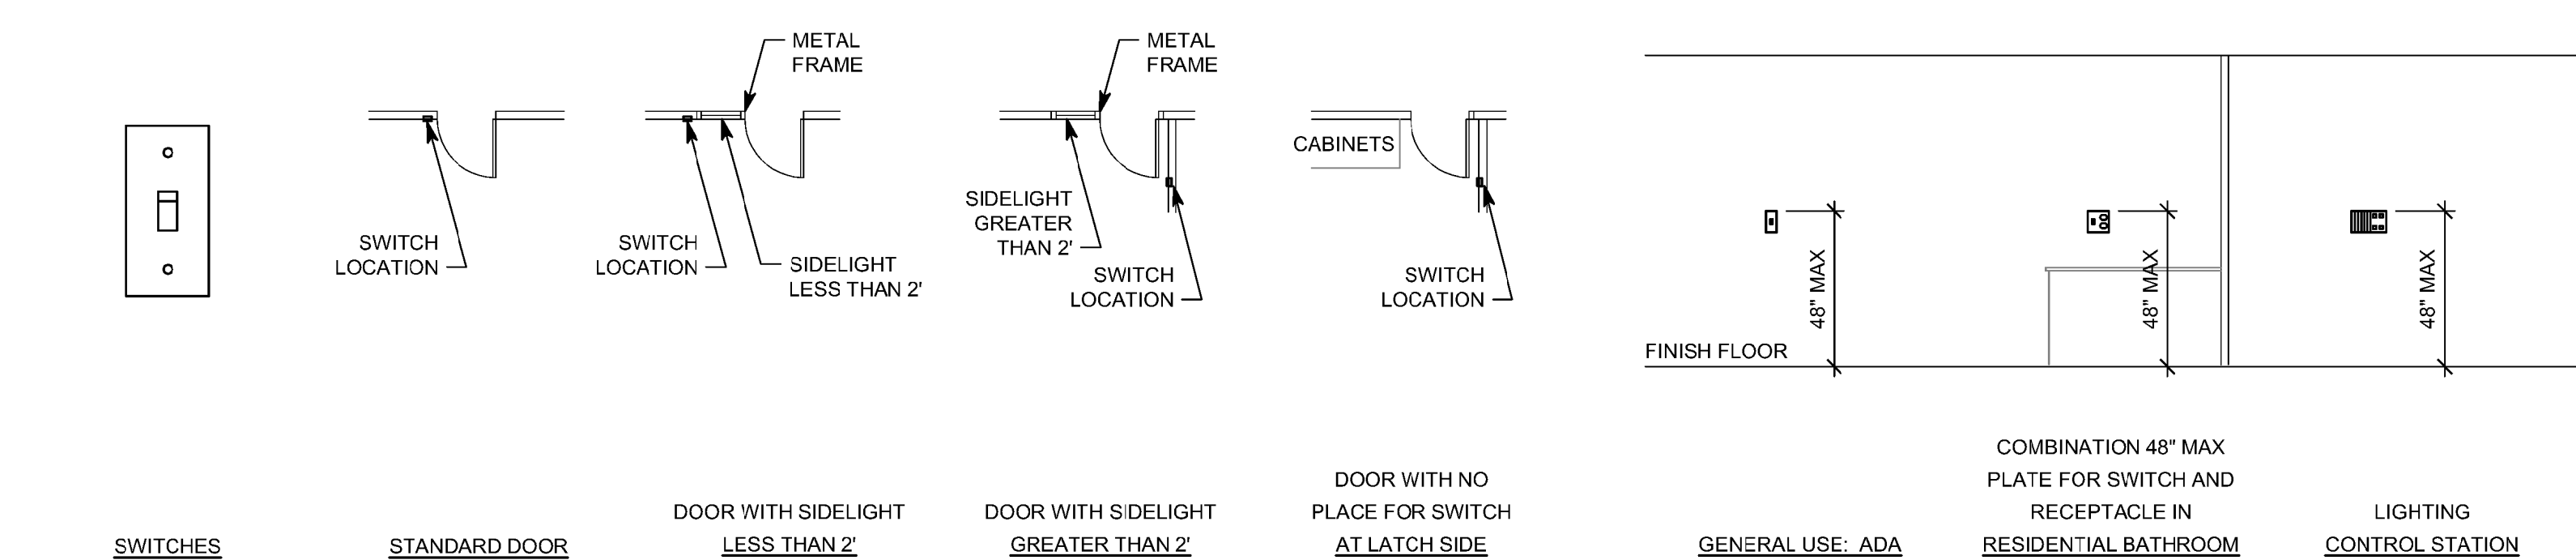


## 6 SWITCH MOUNTING DETAILS

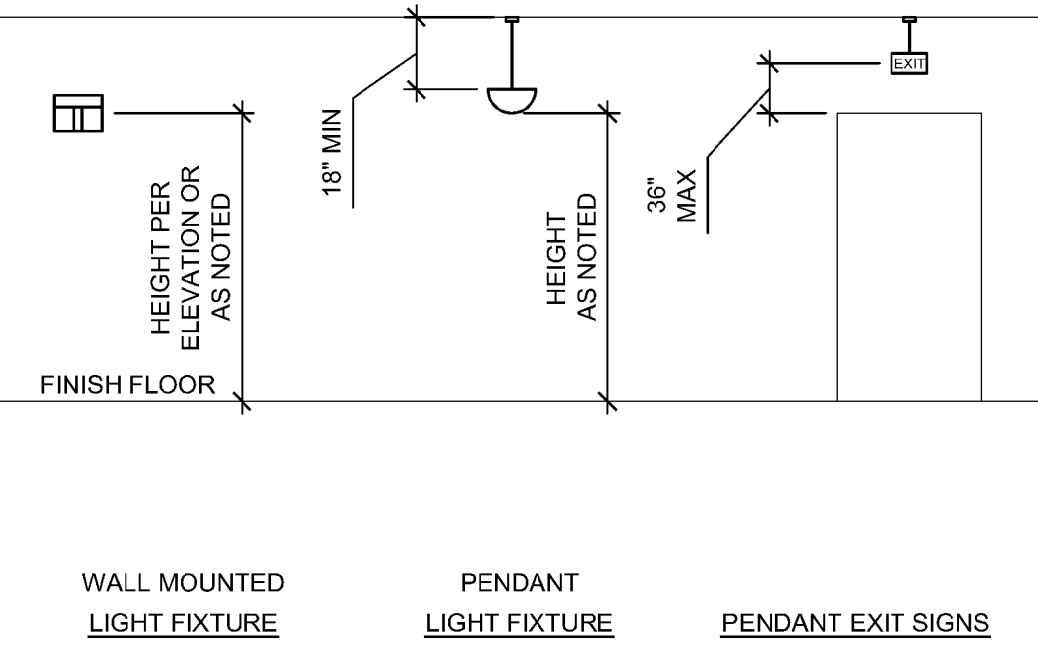


## 2 LIGHTING MOUNTING DETAILS

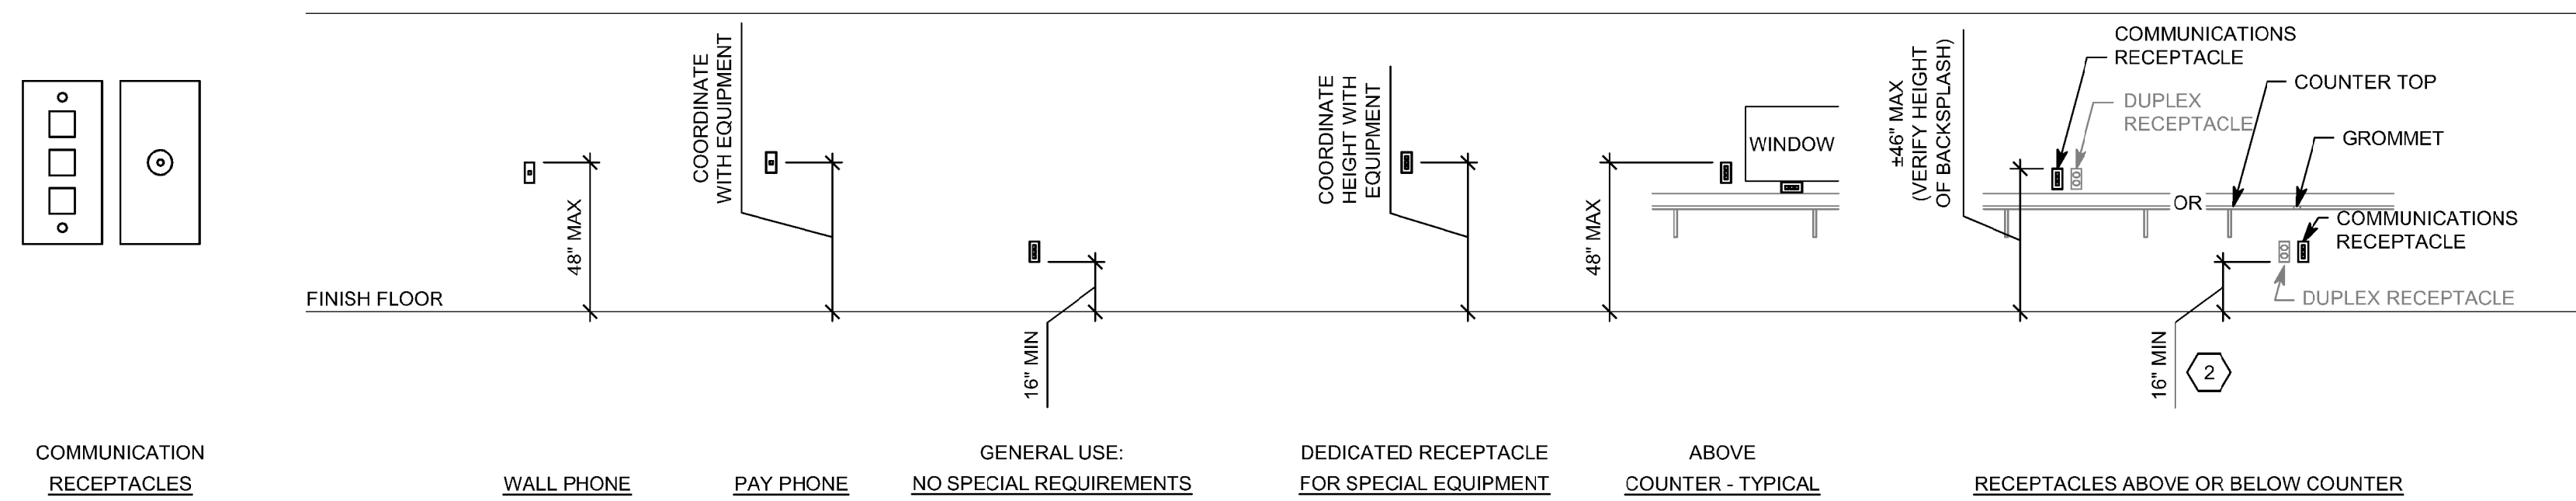

## 3 COMMUNICATION MOUNTING DETAILS

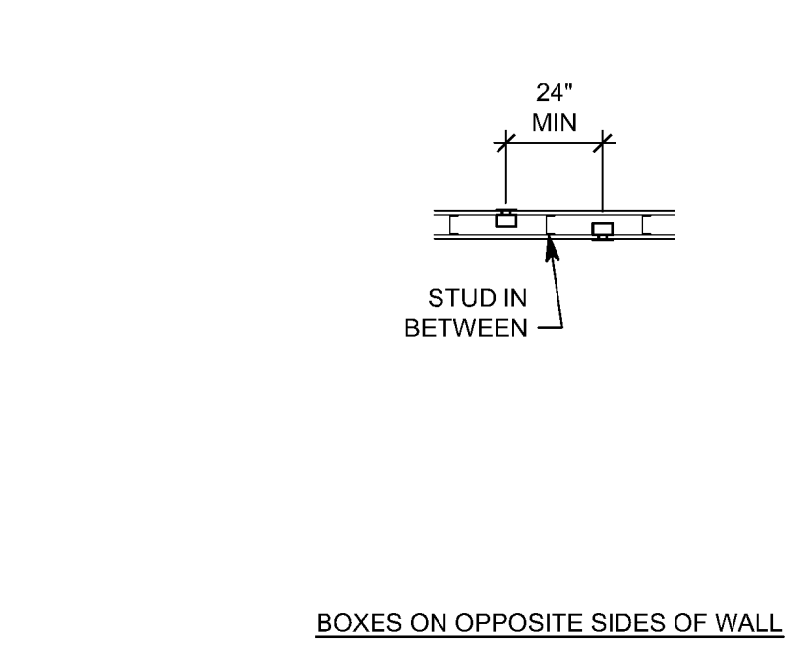

## 4 BOX MOUNTING DETAILS

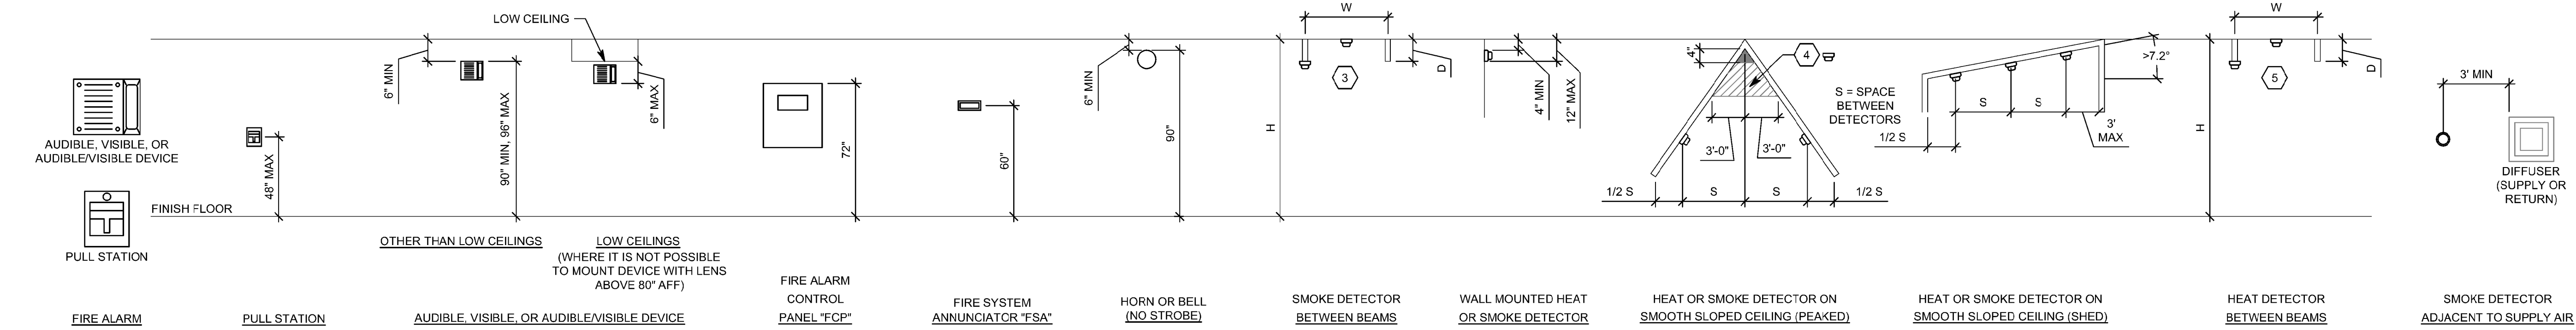

## 1 FIRE ALARM MOUNTING DETAILS

Donald L. Welch  
Architect  
7533 Sandy Land Lane  
Midvale, Utah 84047  
801.346-6381  
dwelch5977@msn.com

THE DESIGNS SHOWN AND DESCRIBED HEREIN INCLUDING ALL TECHNICAL DRAWINGS, GRAPHIC REPRESENTATION & MODELS THEREOF, ARE PROPRIETARY & CAN NOT BE COPIED, DUPLICATED, OR COMMERCIALY EXPLOITED IN WHOLE OR IN PART WITHOUT THE SOLE AND EXPRESS WRITTEN PERMISSION FROM DONALD L. WELCH ARCHITECT

THESE DRAWINGS ARE AVAILABLE FOR LIMITED REVIEW AND EVALUATION BY CLIENTS CONSULTANTS, CONTRACTORS, GOVERNMENT AGENCIES, VENDORS, AND OFFICE PERSONNEL ONLY IN ACCORDANCE WITH THIS NOTICE.

consultant:



project:

Tenant Finish  
for New  
Brighton  
Recovery  
Campus  
4905, 4911, 4915, 4925,  
4931, & 4953 South 900  
East  
Salt Lake County, Utah

date

January 04, 2017

revisions

- PERMIT SET-December 28, 2016
- ADDENDUM #2-January 06, 2017
- ADDENDUM #3-January 11, 2017
- ADDENDUM #4-January 17, 2017
- ADDENDUM #5-January 19, 2017
- ADDENDUM #7-February 24, 2017
- ADDENDUM #8-March 20, 2017

data

project no:

drawn by:

checked by:


title

DETAILS

sheet

EP501

File Name: P:\2016\20160686\Drawings\3Sheet\Building\_F\86EP502.dwg Last Plotted: 2017/03/21 @ 9:01 AM By: jrw

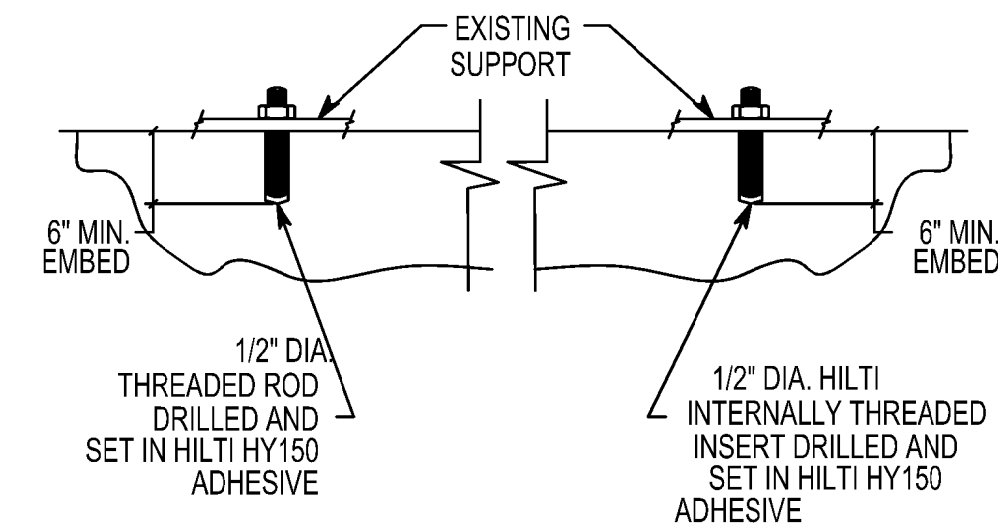


OPTION 1

OPTION 2

NOTE:  
1. BLOW ALL HOLES CLEAN W/OIL FREE COMPRESSED AIR.  
2. FOLLOW ALL MANUFACTURES RECOMMENDATIONS.


## LIGHT WEIGHT CONCRETE ANCHORAGE

4  
NTS

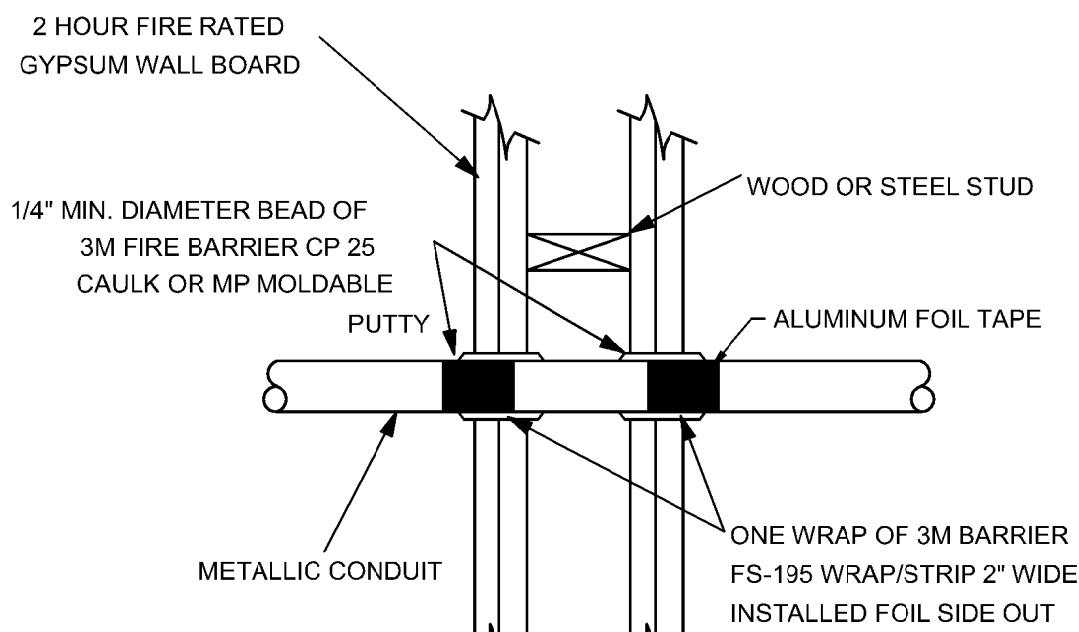


## FIRESTOP FOR METAL CONDUIT THRU GYPSUM WALL BOARD

1  
NTS

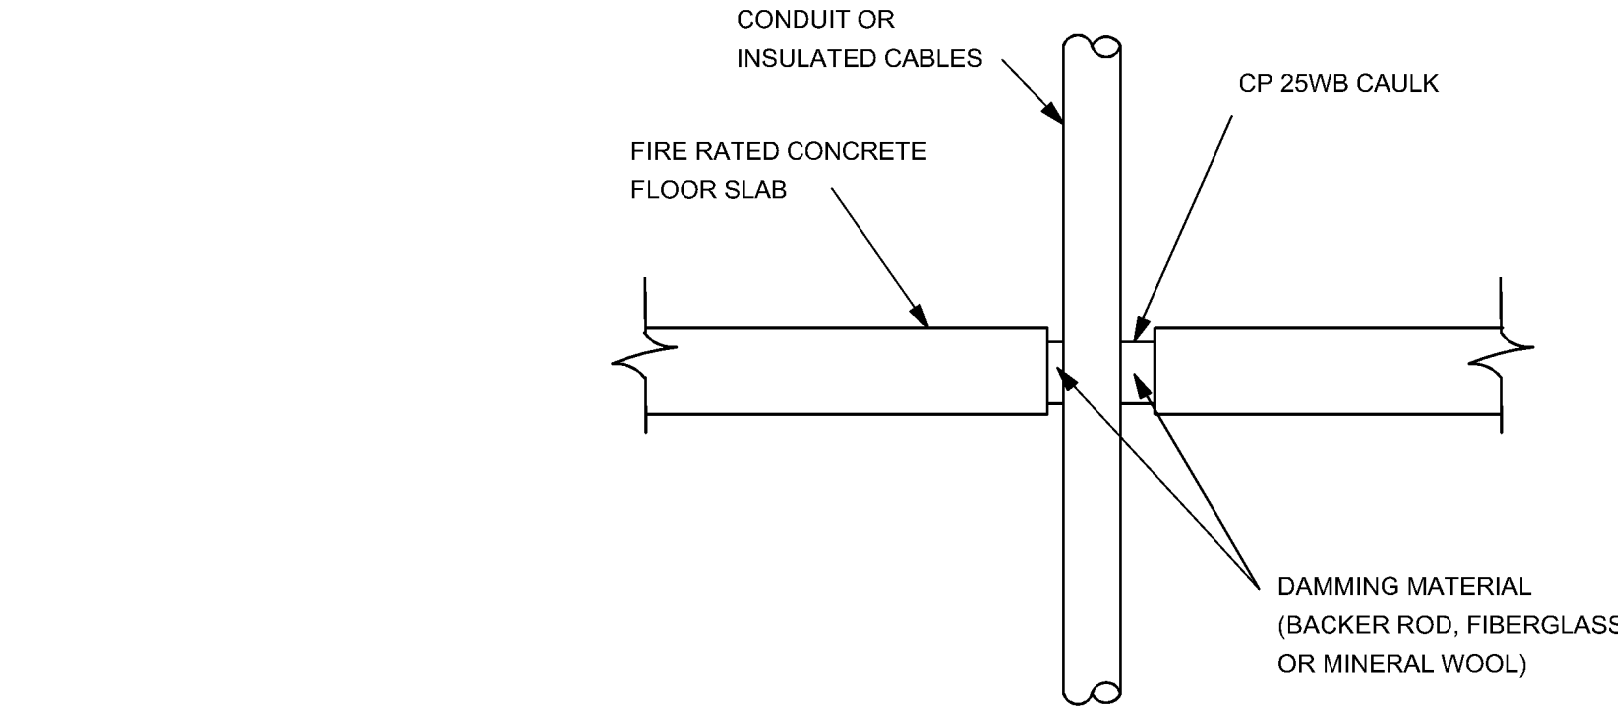


## TYPICAL FIRESTOP FOR CABLES/CONDUIT THROUGH CONCRETE FLOORING

7  
NTS

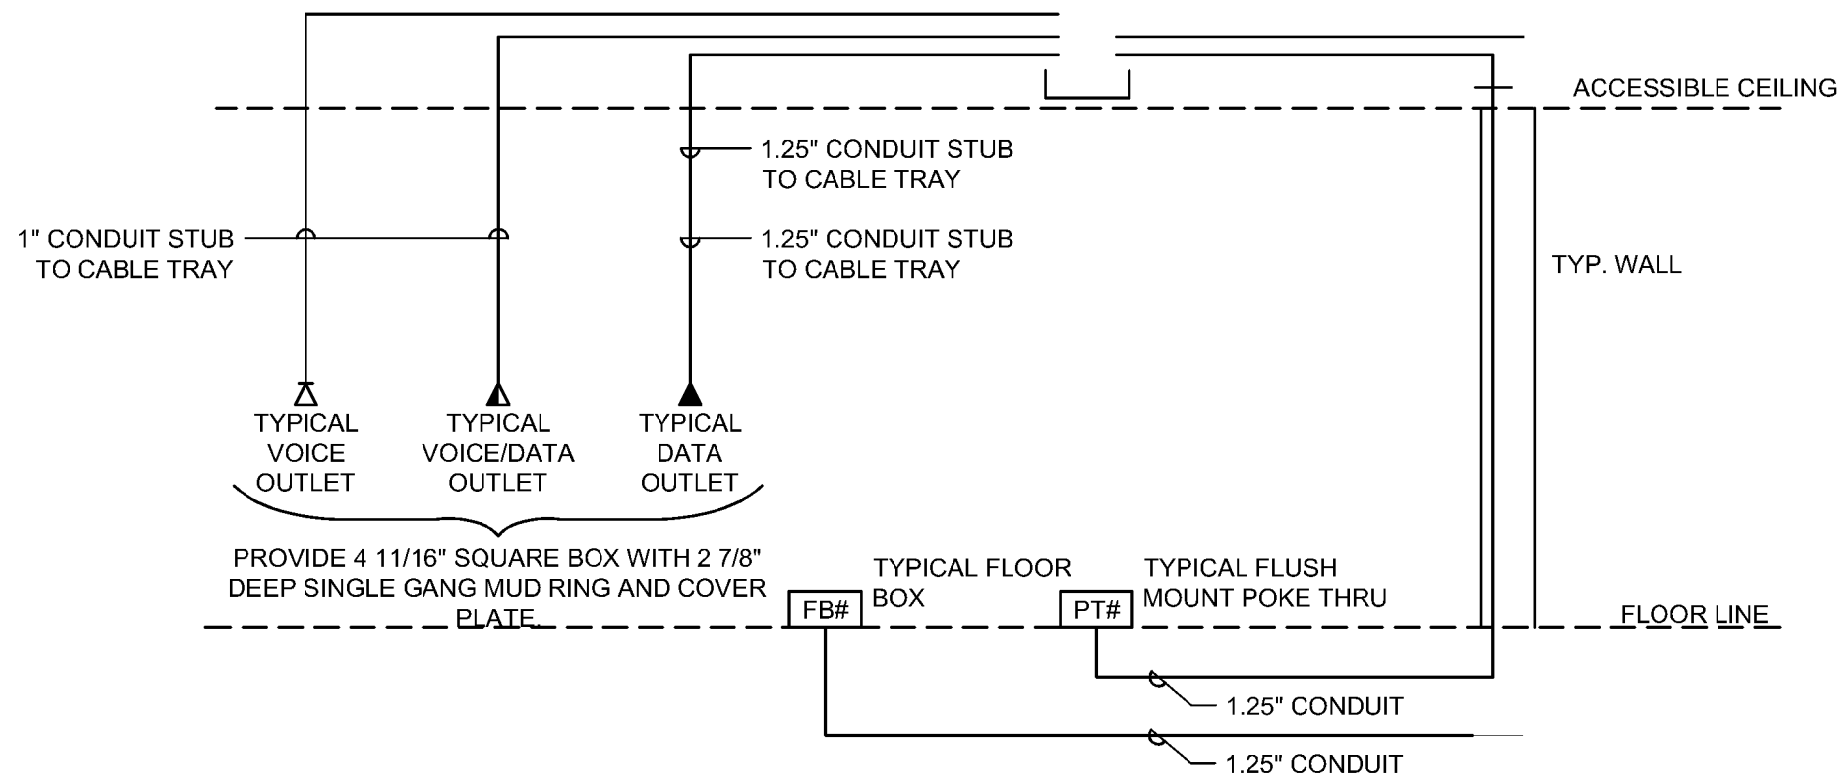

## 5 VOICE/DATA RISER

NTS

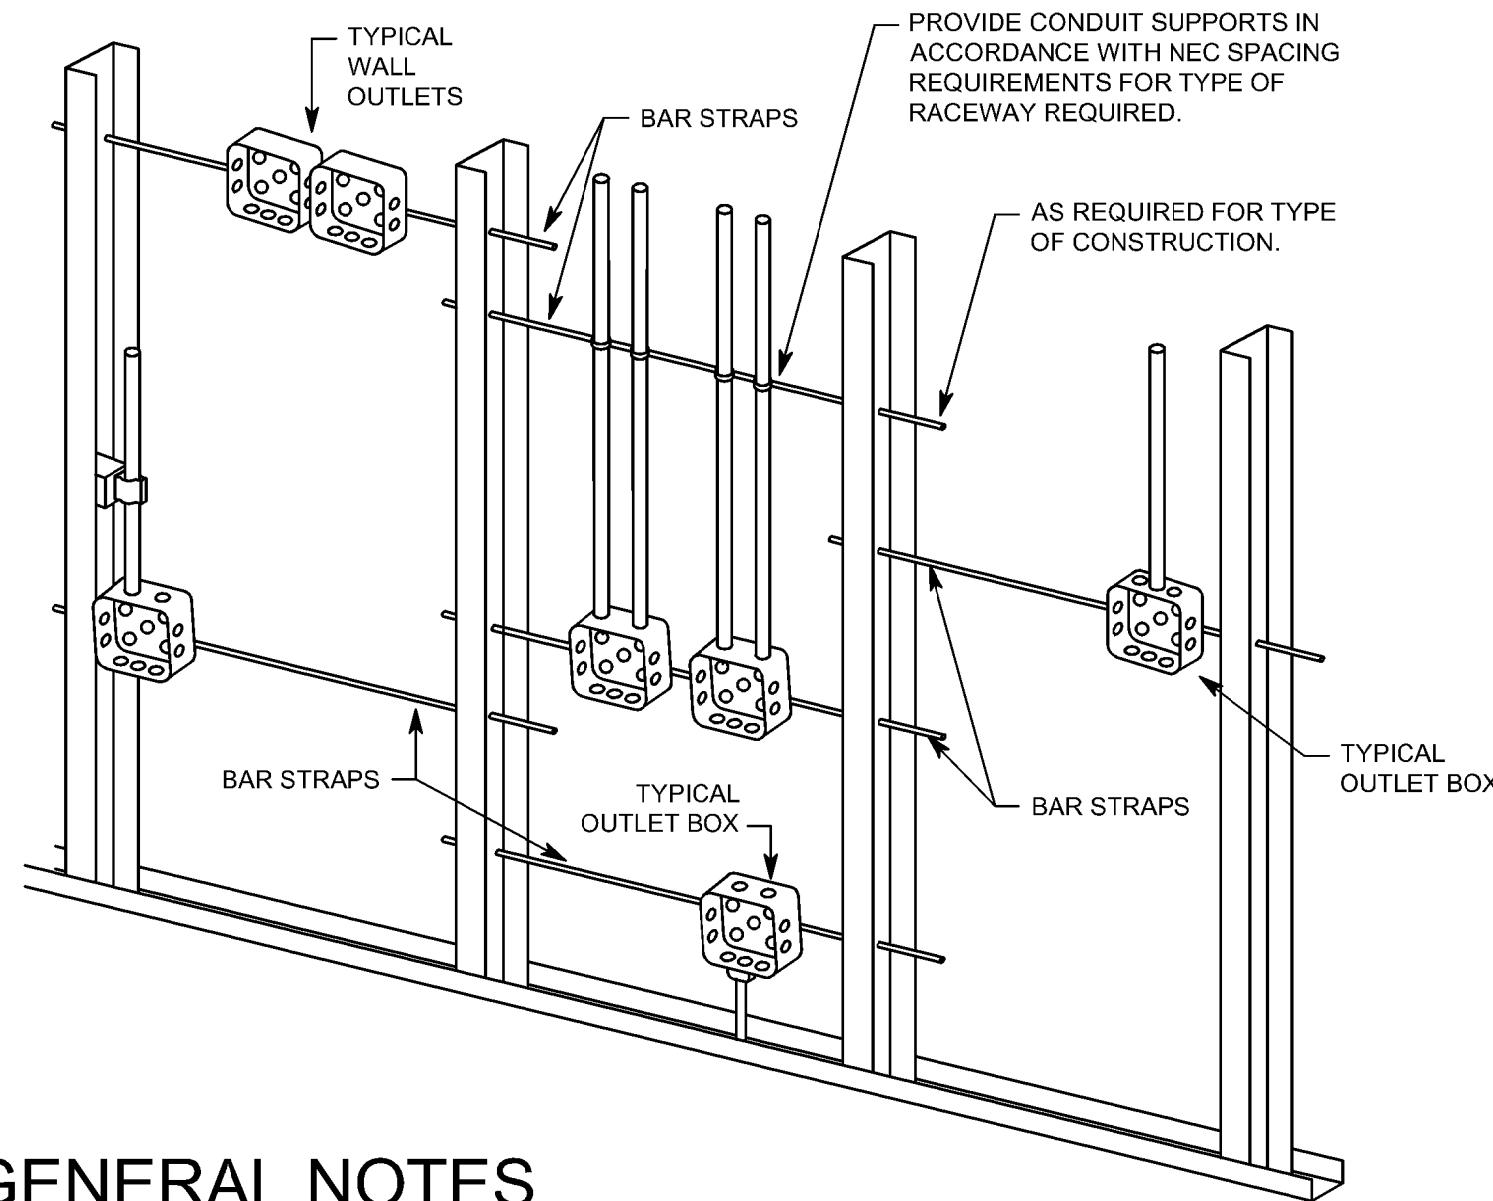


## GENERAL NOTES

1. TYPICAL FOR WOOD AND METAL STUD ROUGH-IN.
2. PLASTER RINGS NOT SHOWN.
3. LOCATE ALL OUTLET BOXES IN ACCORDANCE WITH ARCHITECTURAL AND MECHANICAL DRAWINGS AND WITH ALL APPLICABLE SHOP DRAWINGS.
4. IN ACCORDANCE WITH UBC 709-7 EXCEPTION 1, OUTLETS ON OPPOSITE SIDES OF WALLS OR PARTITIONS IN THE SAME STUD SPACE IN A RATED FIRE SEPARATION WALL MUST BE SEPARATED BY A MINIMUM OF 24" HORIZONTAL DISTANCE.
5. IN NON-RATED WALLS, OUTLETS ON OPPOSITE SIDES OF WALLS OR PARTITIONS MUST BE SEPARATED BY 16" FOR SOUND ATTENUATION.


## 2 TYPICAL ROUGH-IN REQUIREMENTS DETAIL

NTS

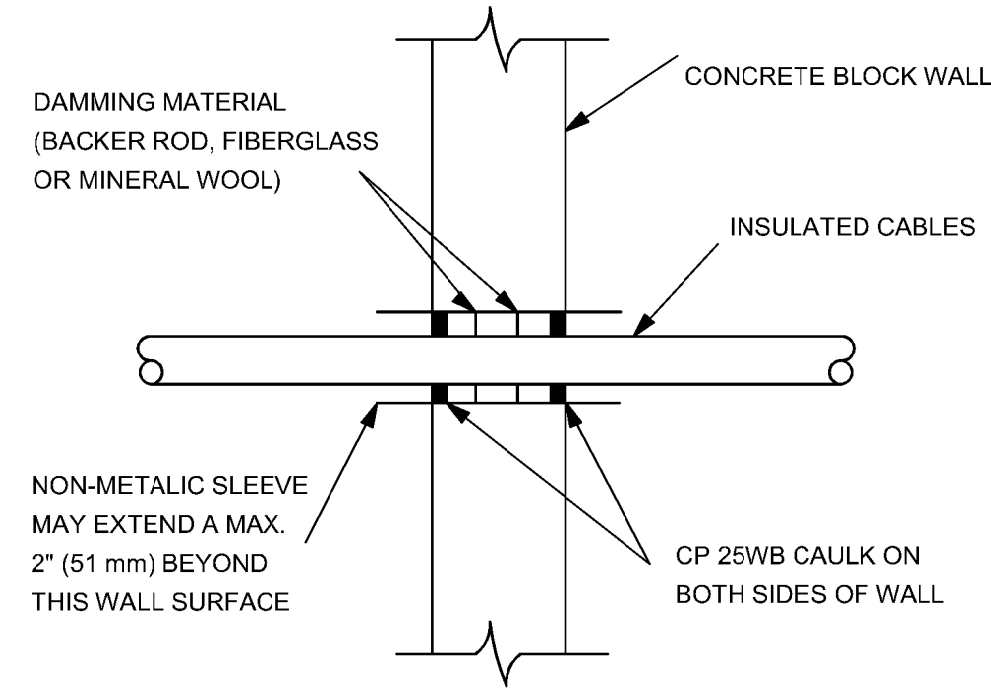


## TYPICAL FIRESTOP FOR CABLES/CONDUIT THROUGH CONCRETE WALLS

8  
NTS

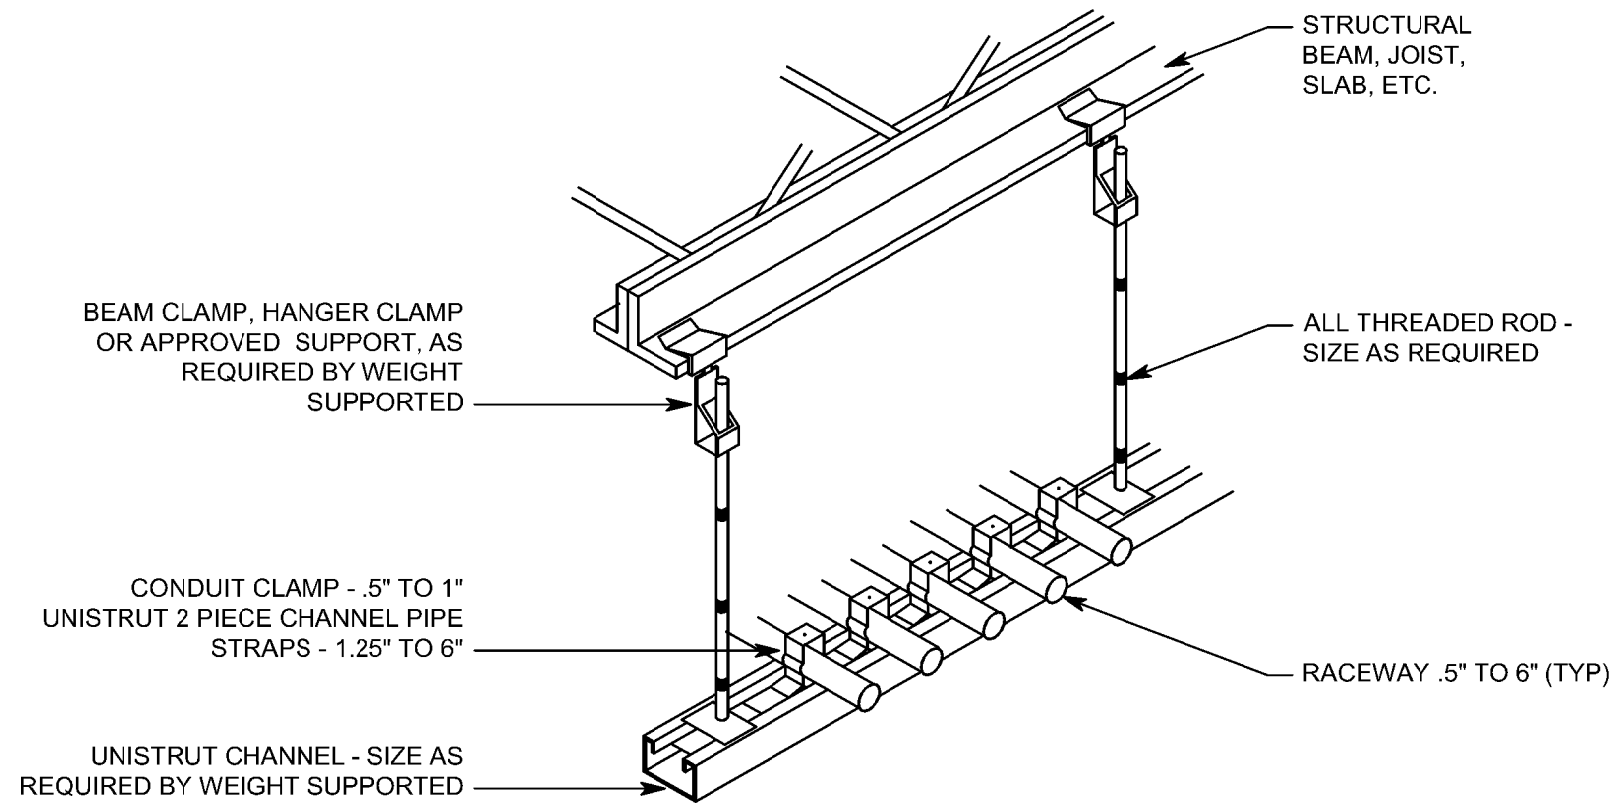

## 6 TYPICAL CONDUIT RACK DETAIL

NTS

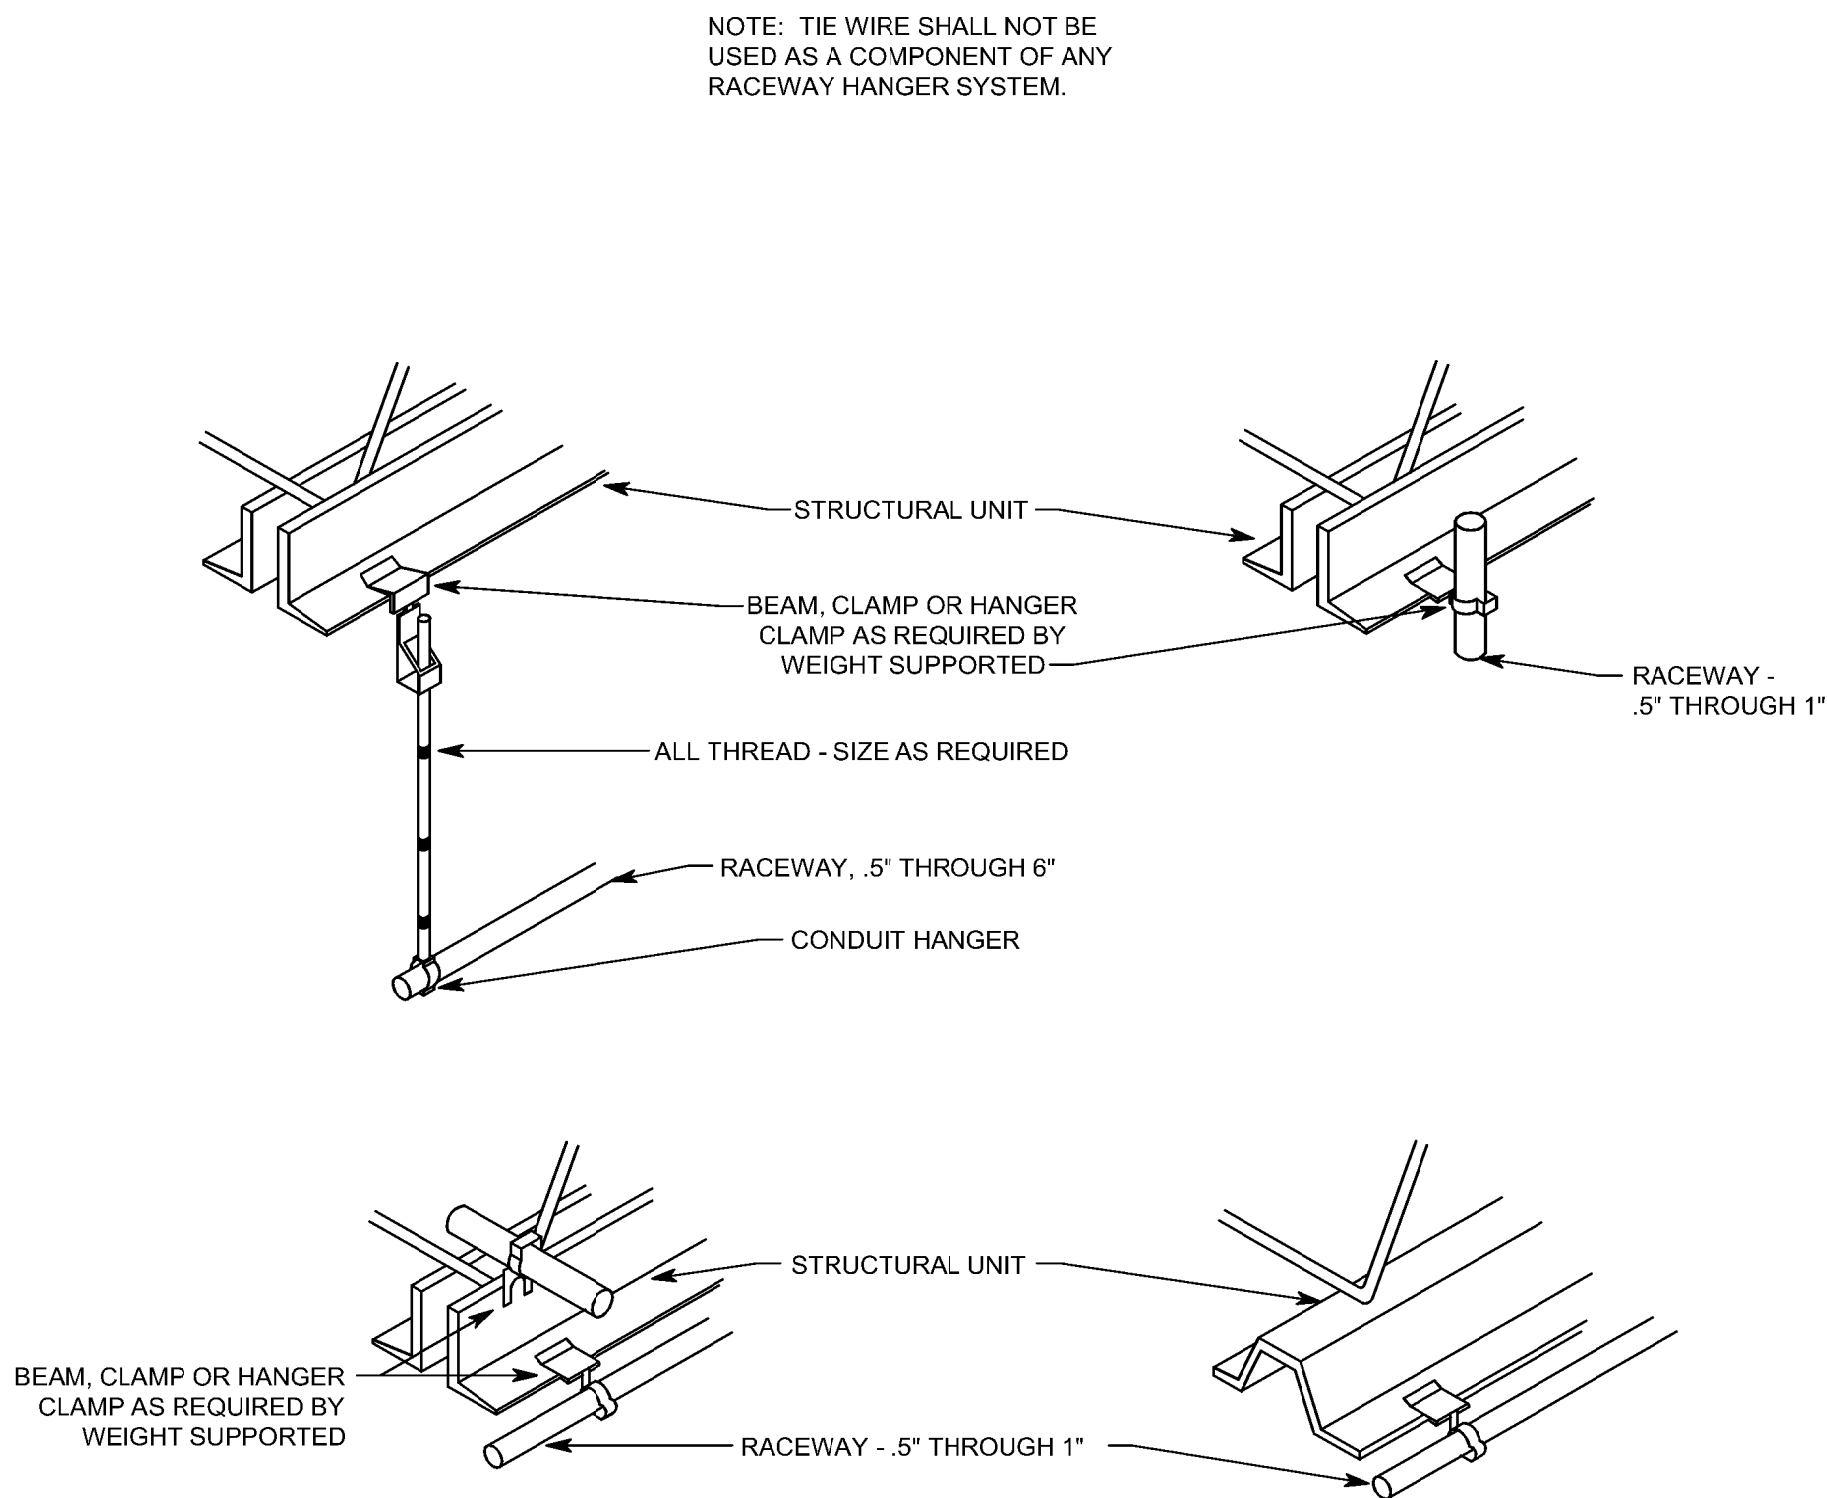

## TYPICAL RACEWAY SUPPORT METHODS DETAIL


3  
NTS

Donald L. Welch  
Architect  
7533 Sandy Land Lane  
Midvale, Utah 84047  
801.346-6391  
dwelch5977@msn.com

THE DESIGNS SHOWN AND DESCRIBED HEREIN INCLUDING ALL TECHNICAL DRAWINGS, GRAPHIC REPRESENTATION & MODELS THEREOF, ARE PROPRIETARY & CAN NOT BE COPIED, DUPLICATED, OR COMMERCIALY EXPLOITED IN WHOLE OR IN PART WITHOUT THE SOLE AND EXPRESS WRITTEN PERMISSION FROM DONALD L. WELCH ARCHITECT

THESE DRAWINGS ARE AVAILABLE FOR LIMITED REVIEW AND EVALUATION BY CLIENTS CONSULTANTS, CONTRACTORS, GOVERNMENT AGENCIES, VENDORS, AND OFFICE PERSONNEL ONLY IN ACCORDANCE WITH THIS NOTICE.

consultant:

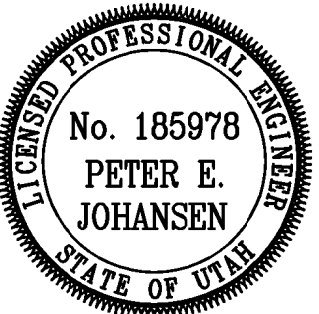

project:

Tenant Finish  
for New  
Brighton  
Recovery  
Campus  
4905, 4911, 4915, 4925,  
4931, & 4953 South 900  
East  
Salt Lake County, Utah

date

January 04, 2017

revisions

- PERMIT SET--December 28, 2016
- ADDENDUM #2--January 06, 2017
- ADDENDUM #3--January 11, 2017
- ADDENDUM #4--January 17, 2017
- ADDENDUM #5--January 19, 2017
- ADDENDUM #7--February 24, 2017
- ADDENDUM #8--March 20, 2017

data

project no:

drawn by:

checked by:

title


DETAILS

sheet


EP5.02




File Name: P:\2016\20160686\Drawings\3Sheet\Building\_F\86EP503.dwg Last Plotted: 2017/03/21 @ 9:01 AM By: jrw

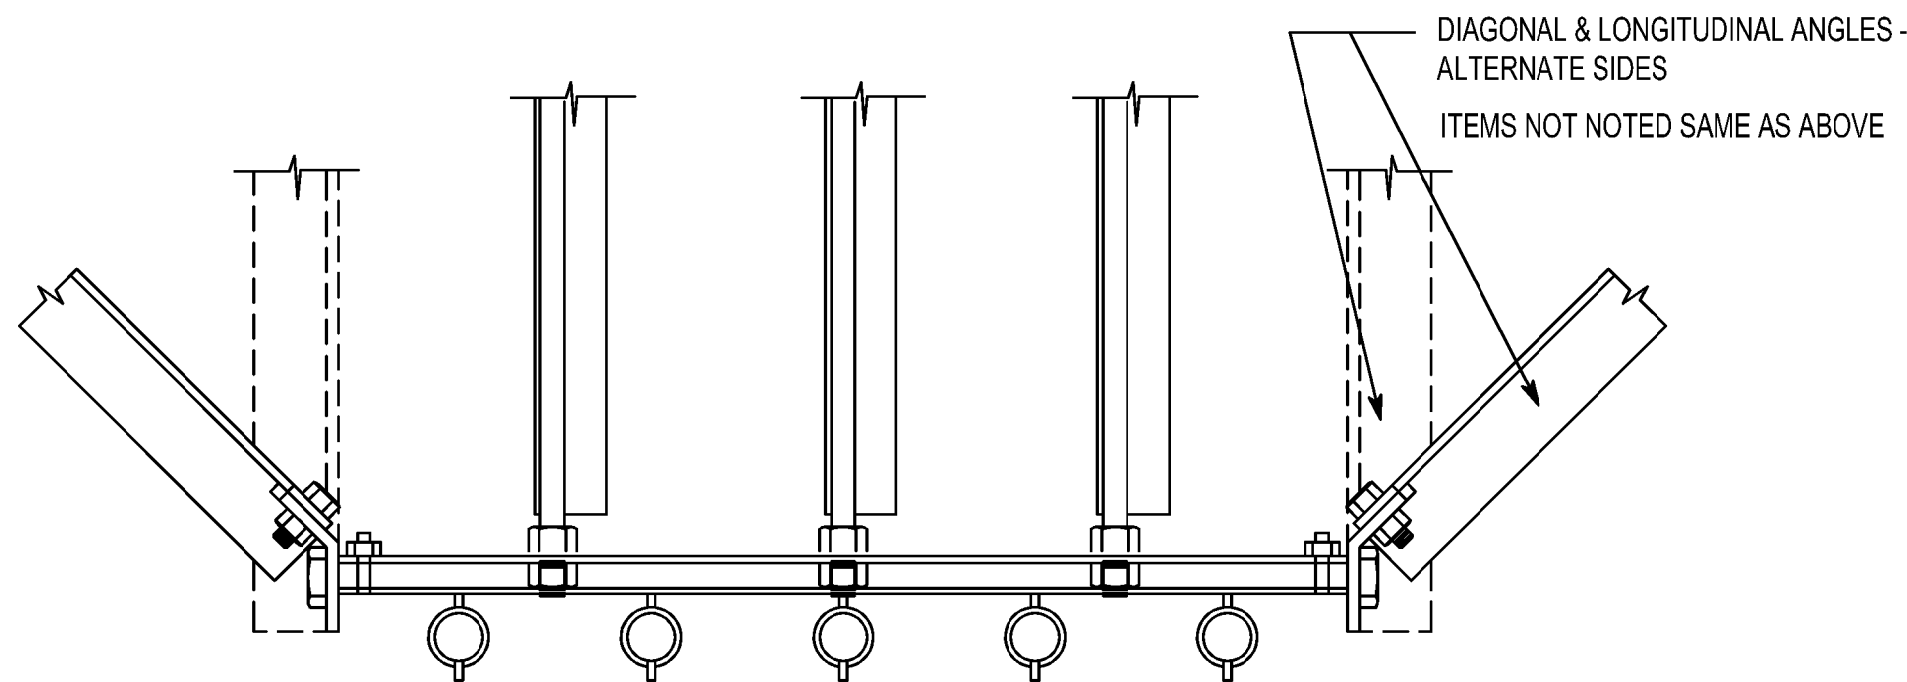

### 5 TYPICAL CONDUIT RACK BRACING

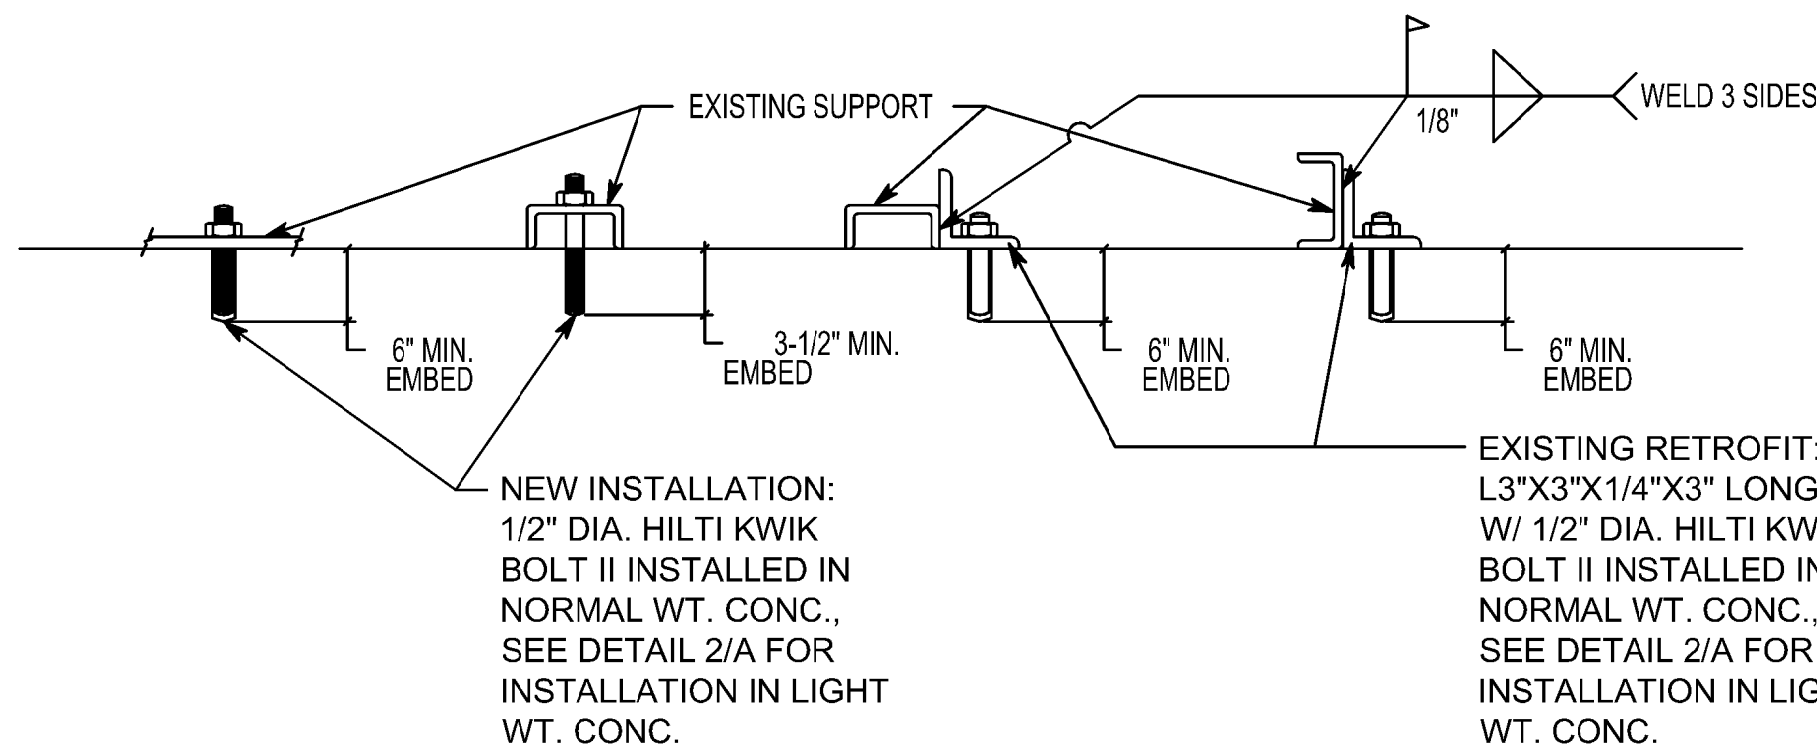


### 3 NORMAL WEIGHT CONCRETE ANCHORAGE

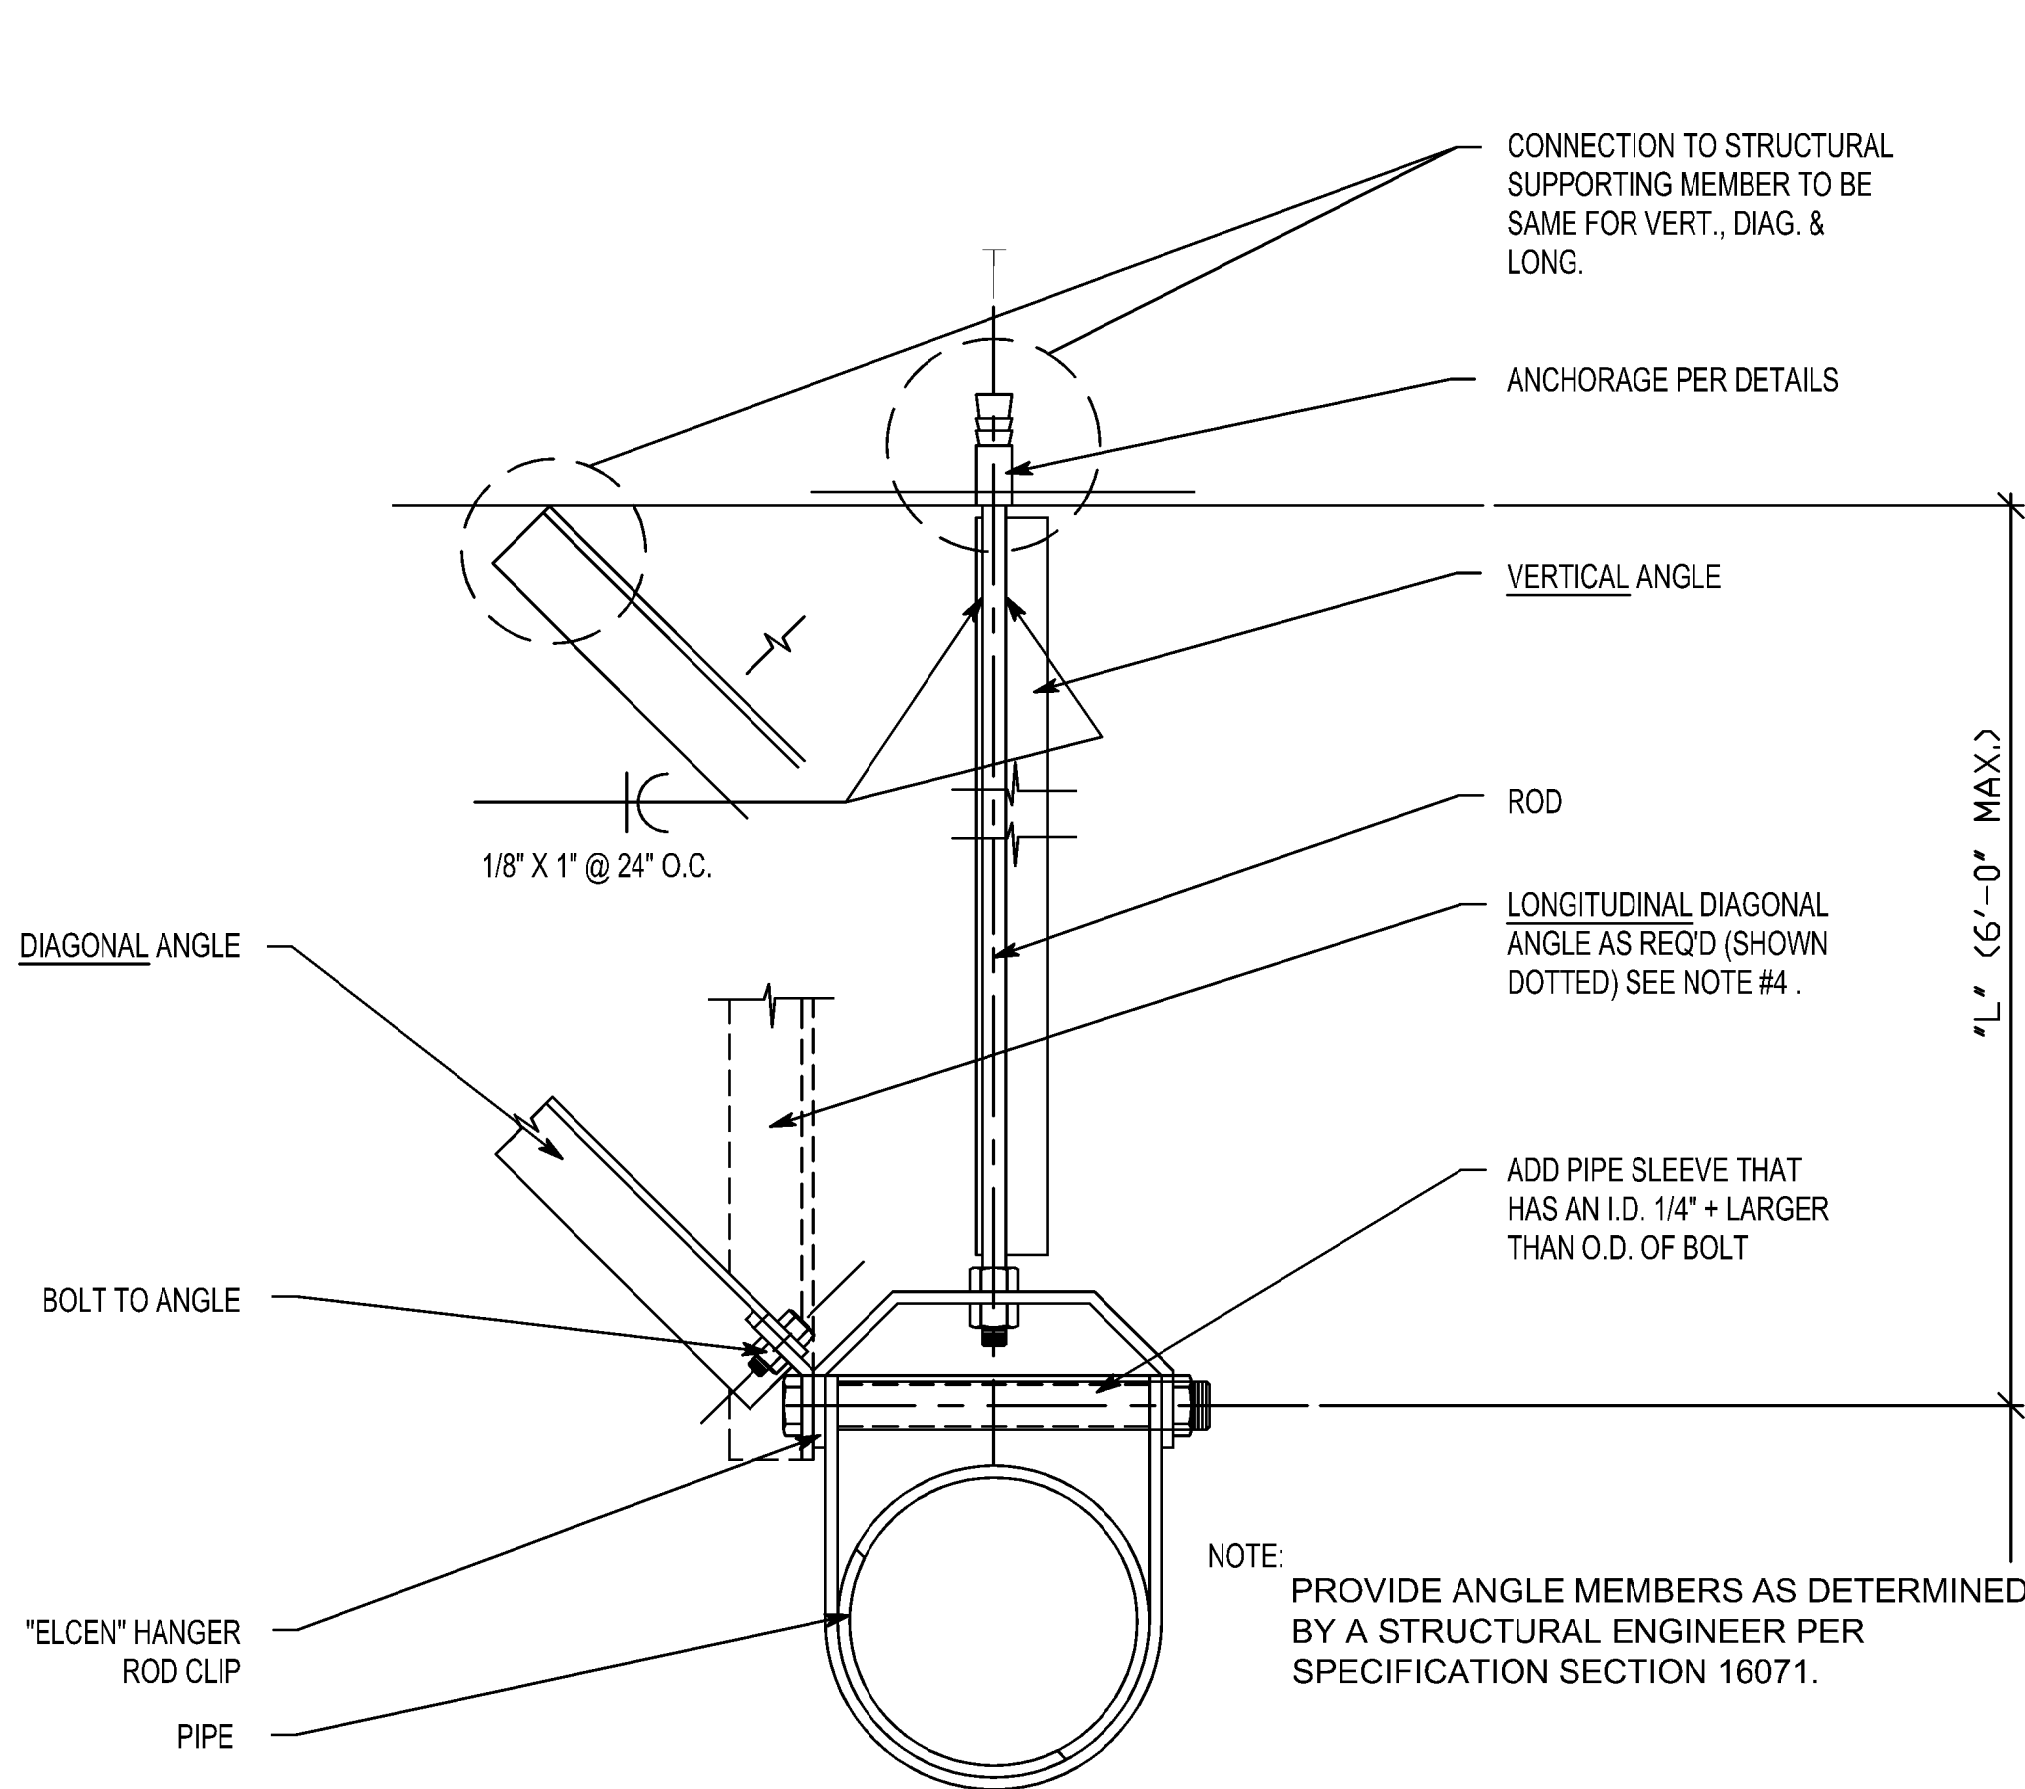


### 4 TYPICAL SINGLE CONDUIT BRACING

### SEISMIC BRACING GENERAL NOTES

1. BRACE ALL CONDUIT WITH 2 1/2" I.D. AND LARGER, AND ALL BUSWAY, CABLE TRAY AND CONDUIT RACKS.
2. DETAILS SHOWN PROVIDE A LATERAL BRACING SYSTEM. A TYPICAL VERTICAL SUPPORT SYSTEM MUST ALSO BE USED. HOWEVER, WHERE BRACE OCCURS THE VERTICAL ANGLE SHOWN MAY REPLACE A TYPICAL VERTICAL SUPPORT.
3. TRANSVERSE BRACING AT 30'-0" O.C. MAX.
4. LONGITUDINAL BRACINGS AT 60'-0" O.C. MAX.
5. TRANSVERSE BRACING FOR ONE CONDUIT OR BUSWAY SECTION MAY ALSO ACT AS LONGITUDINAL BRACING FOR THE CONDUIT OR BUSWAY SECTION CONNECTED PERPENDICULAR TO IT, IF THE BRACING IS INSTALLED WITHIN 24" OF THE ELBOW OR TEE AND SIMILAR SIZE.
6. DO NOT USE BRANCH LINES TO BRACE MAIN LINES.
7. PROVIDE FLEXIBILITY IN JOINTS WHERE PIPES PASS THROUGH BUILDING SEISMIC OR EXPANSION JOINTS, OR WHERE RIGIDLY SUPPORTED PIPES CONNECT TO EQUIPMENT WITH VIBRATION ISOLATORS.
8. AT VERTICAL CONDUIT AND BUSWAY RISERS, WHEREVER POSSIBLE, SUPPORT OF WEIGHT OF THE RISER AT A POINT OR POINTS ABOVE THE CENTER OF GRAVITY OF THE RISER. PROVIDE LATERAL GUIDES AT THE TOP AND BOTTOM OF THE RISER, AND AT INTERMEDIATE POINTS NOT TO EXCEED 30'-0" ON CENTER.
9. PROVIDE LARGE ENOUGH CONDUIT SLEEVES THROUGH WALLS OR FLOORS TO ALLOW FOR ANTICIPATED DIFFERENTIAL MOVEMENTS.
10. DO NOT FASTEN ONE RIGID CONDUIT OR BUSWAY SYSTEM TO TWO DISSIMILAR PARTS OF A BUILDING THAT MAY RESPOND IN A DIFFERENT MODE DURING AN EARTHQUAKE: FOR EXAMPLE, A WALL AND A ROOF.
11. REFER TO SPECIFICATIONS AND MANUFACTURER'S LITERATURE FOR ADDITIONAL REQUIREMENTS.

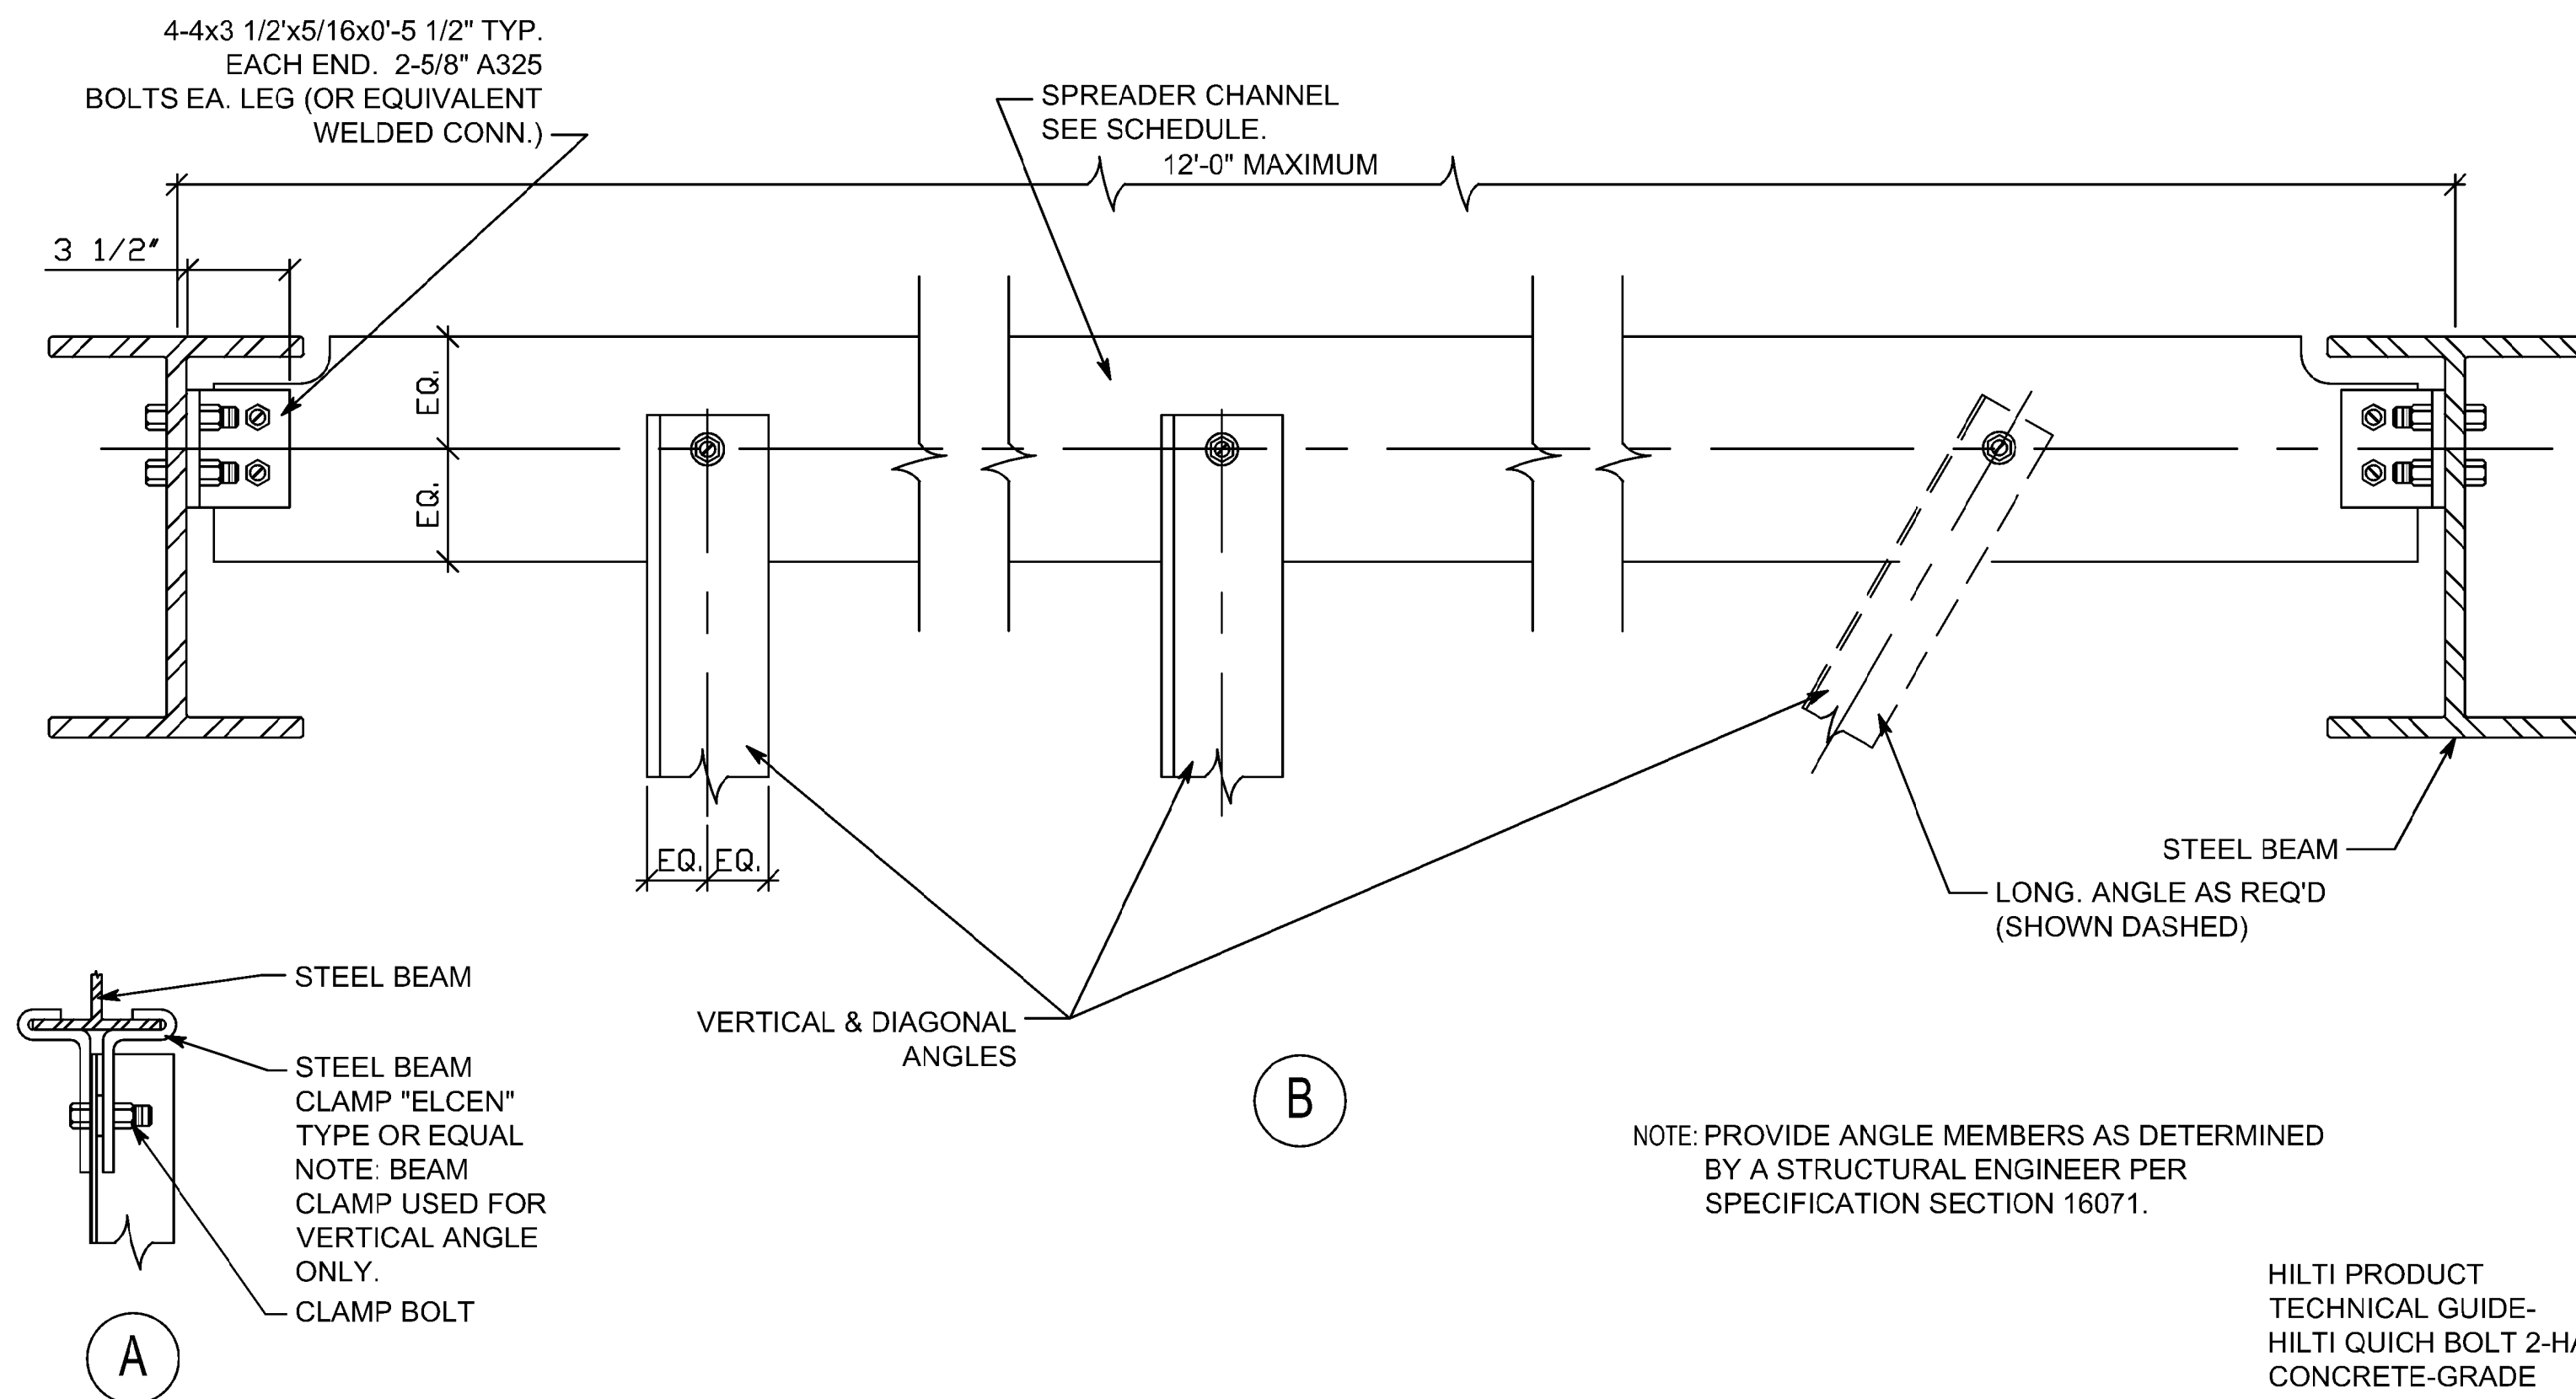

### 1 TYPICAL SINGLE CONDUIT BRACING

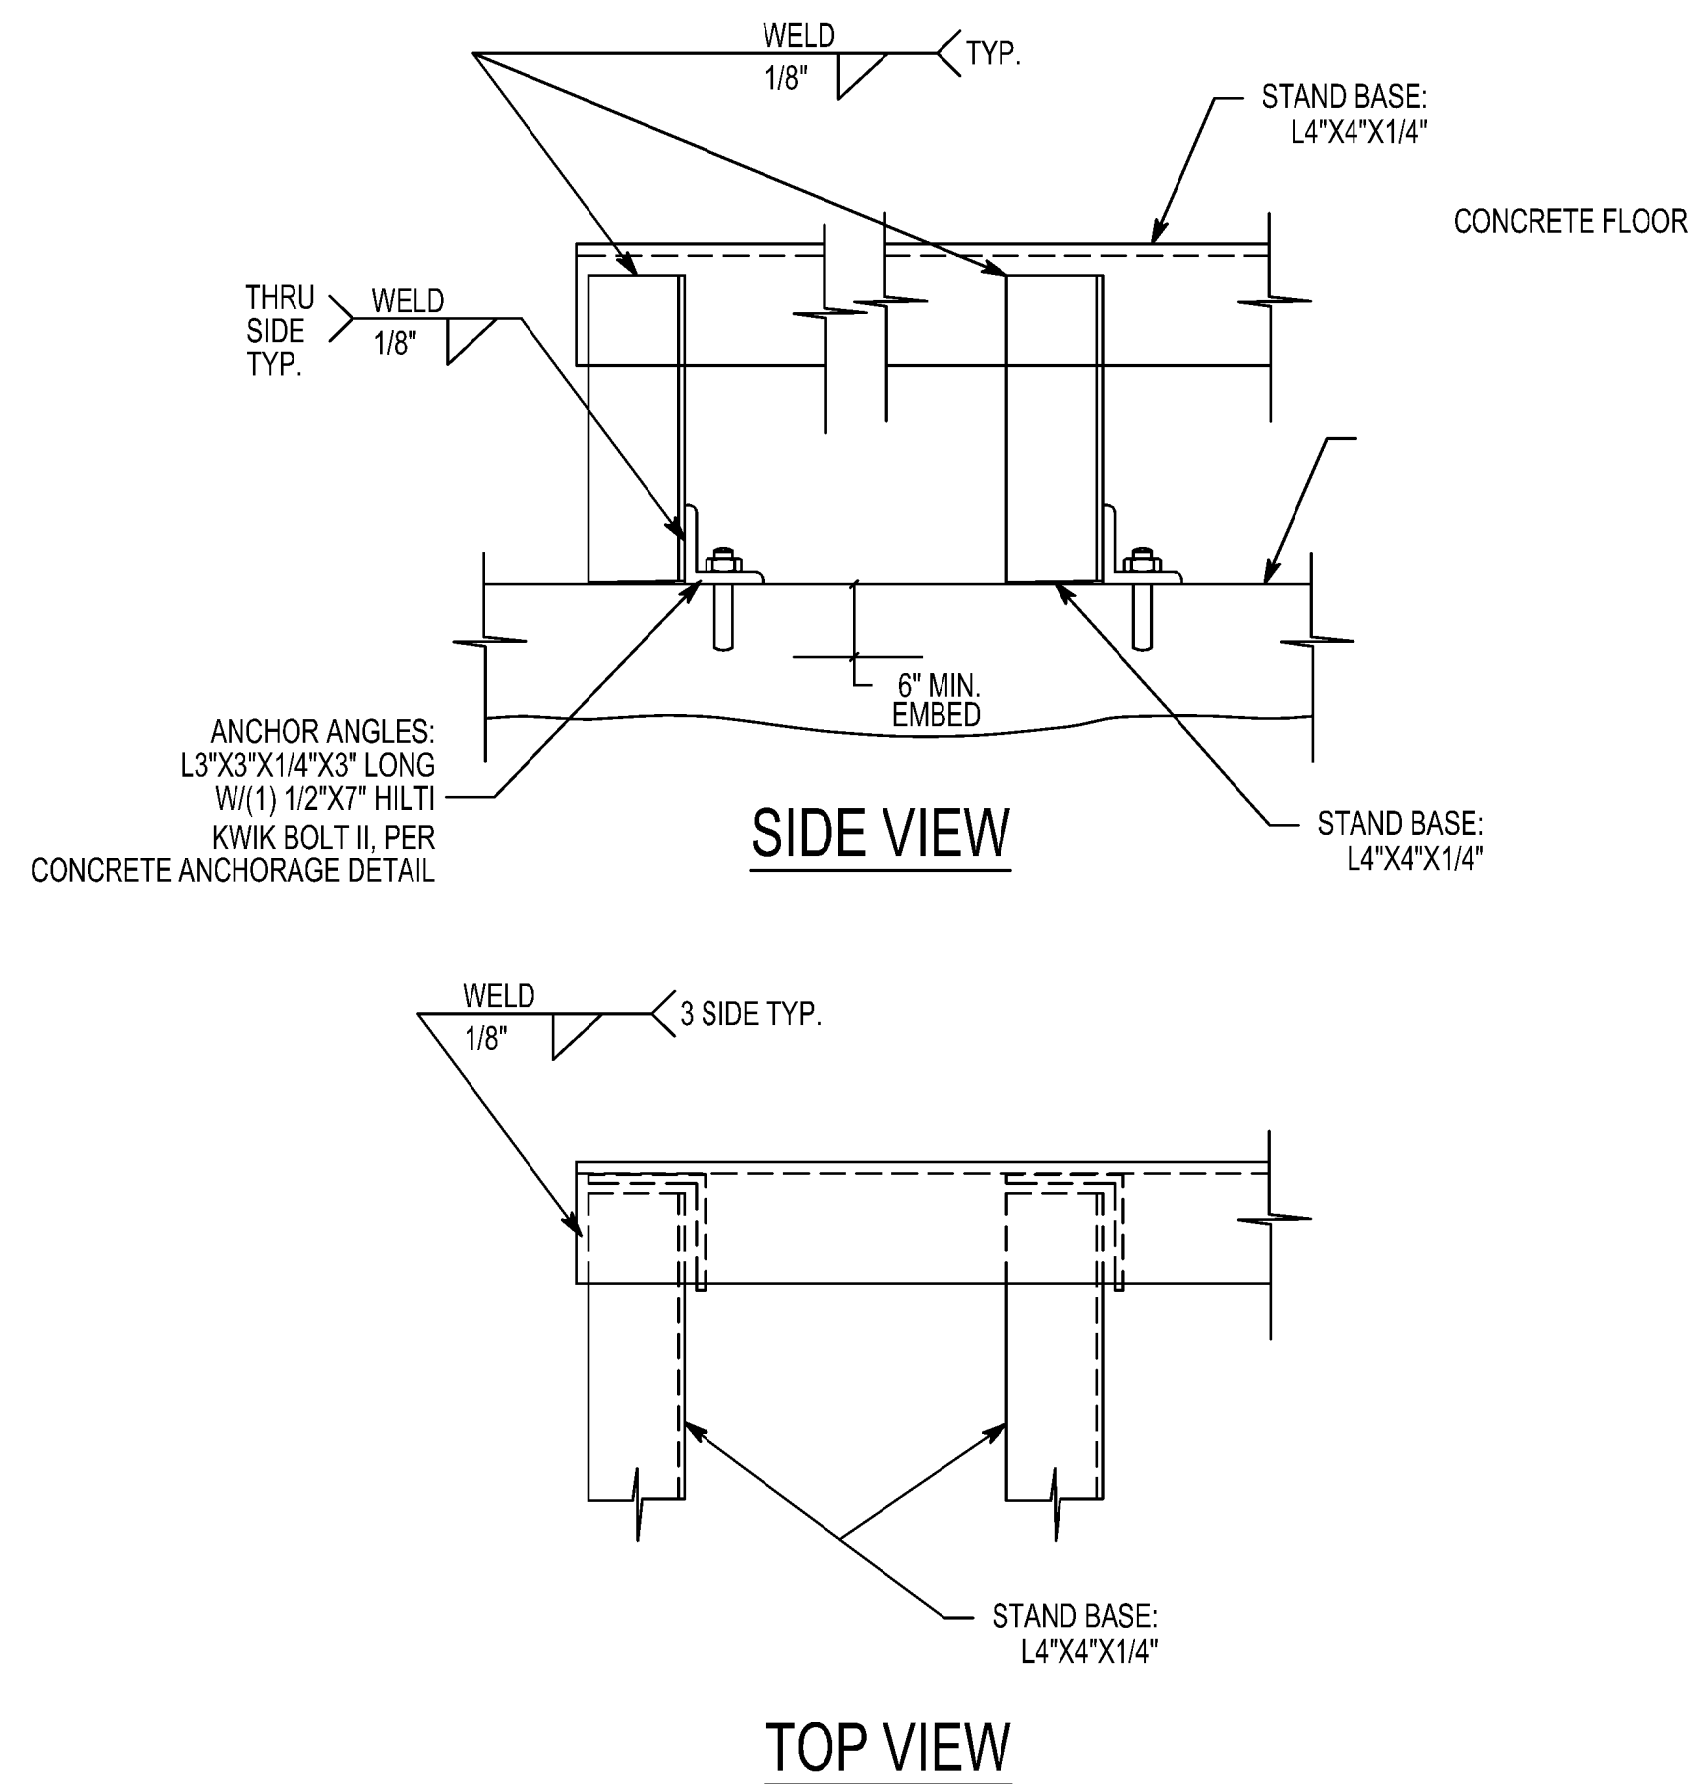


### 2 BASE STAND

Donald L. Welch  
Architect  
7533 Sandy Land Lane  
Midvale, Utah 84047  
801.348-6381  
dwelch5977@msn.com

THE DESIGNS SHOWN AND DESCRIBED HEREIN INCLUDING ALL TECHNICAL DRAWINGS, GRAPHIC REPRESENTATION & MODELS THEREOF, ARE PROPRIETARY & CAN NOT BE COPIED, DUPLICATED, OR COMMERCIALY EXPLOITED IN WHOLE OR IN PART WITHOUT THE SOLE AND EXPRESS WRITTEN PERMISSION FROM DONALD L. WELCH ARCHITECT

THESE DRAWINGS ARE AVAILABLE FOR LIMITED REVIEW AND EVALUATION BY CLIENTS CONSULTANTS, CONTRACTORS, GOVERNMENT AGENCIES, VENDORS, AND OFFICE PERSONNEL ONLY IN ACCORDANCE WITH THIS NOTICE.

consultant:

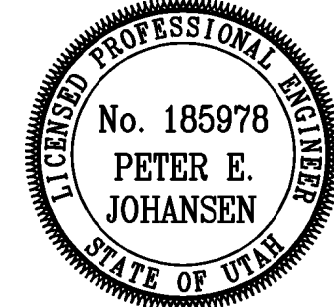

project:

**Tenant Finish  
for New  
Brighton  
Recovery  
Campus**  
4905, 4911, 4915, 4925,  
4931, & 4953 South 900  
East  
Salt Lake County, Utah

date

January 04, 2017

revisions

- PERMIT SET--December 28, 2016
- ADDENDUM #2--January 06, 2017
- ADDENDUM #3--January 11, 2017
- ADDENDUM #4--January 17, 2017
- ADDENDUM #5--January 19, 2017
- ADDENDUM #7--February 24, 2017
- ADDENDUM #8--March 20, 2017

data

project no:

drawn by:

checked by:

title

DETAILS


sheet

EP5.03

BUILDING 'F' 4953 South 900 East PARCEL #22081850130000

# ONE LINE DIAGRAM

SCALE: NTS

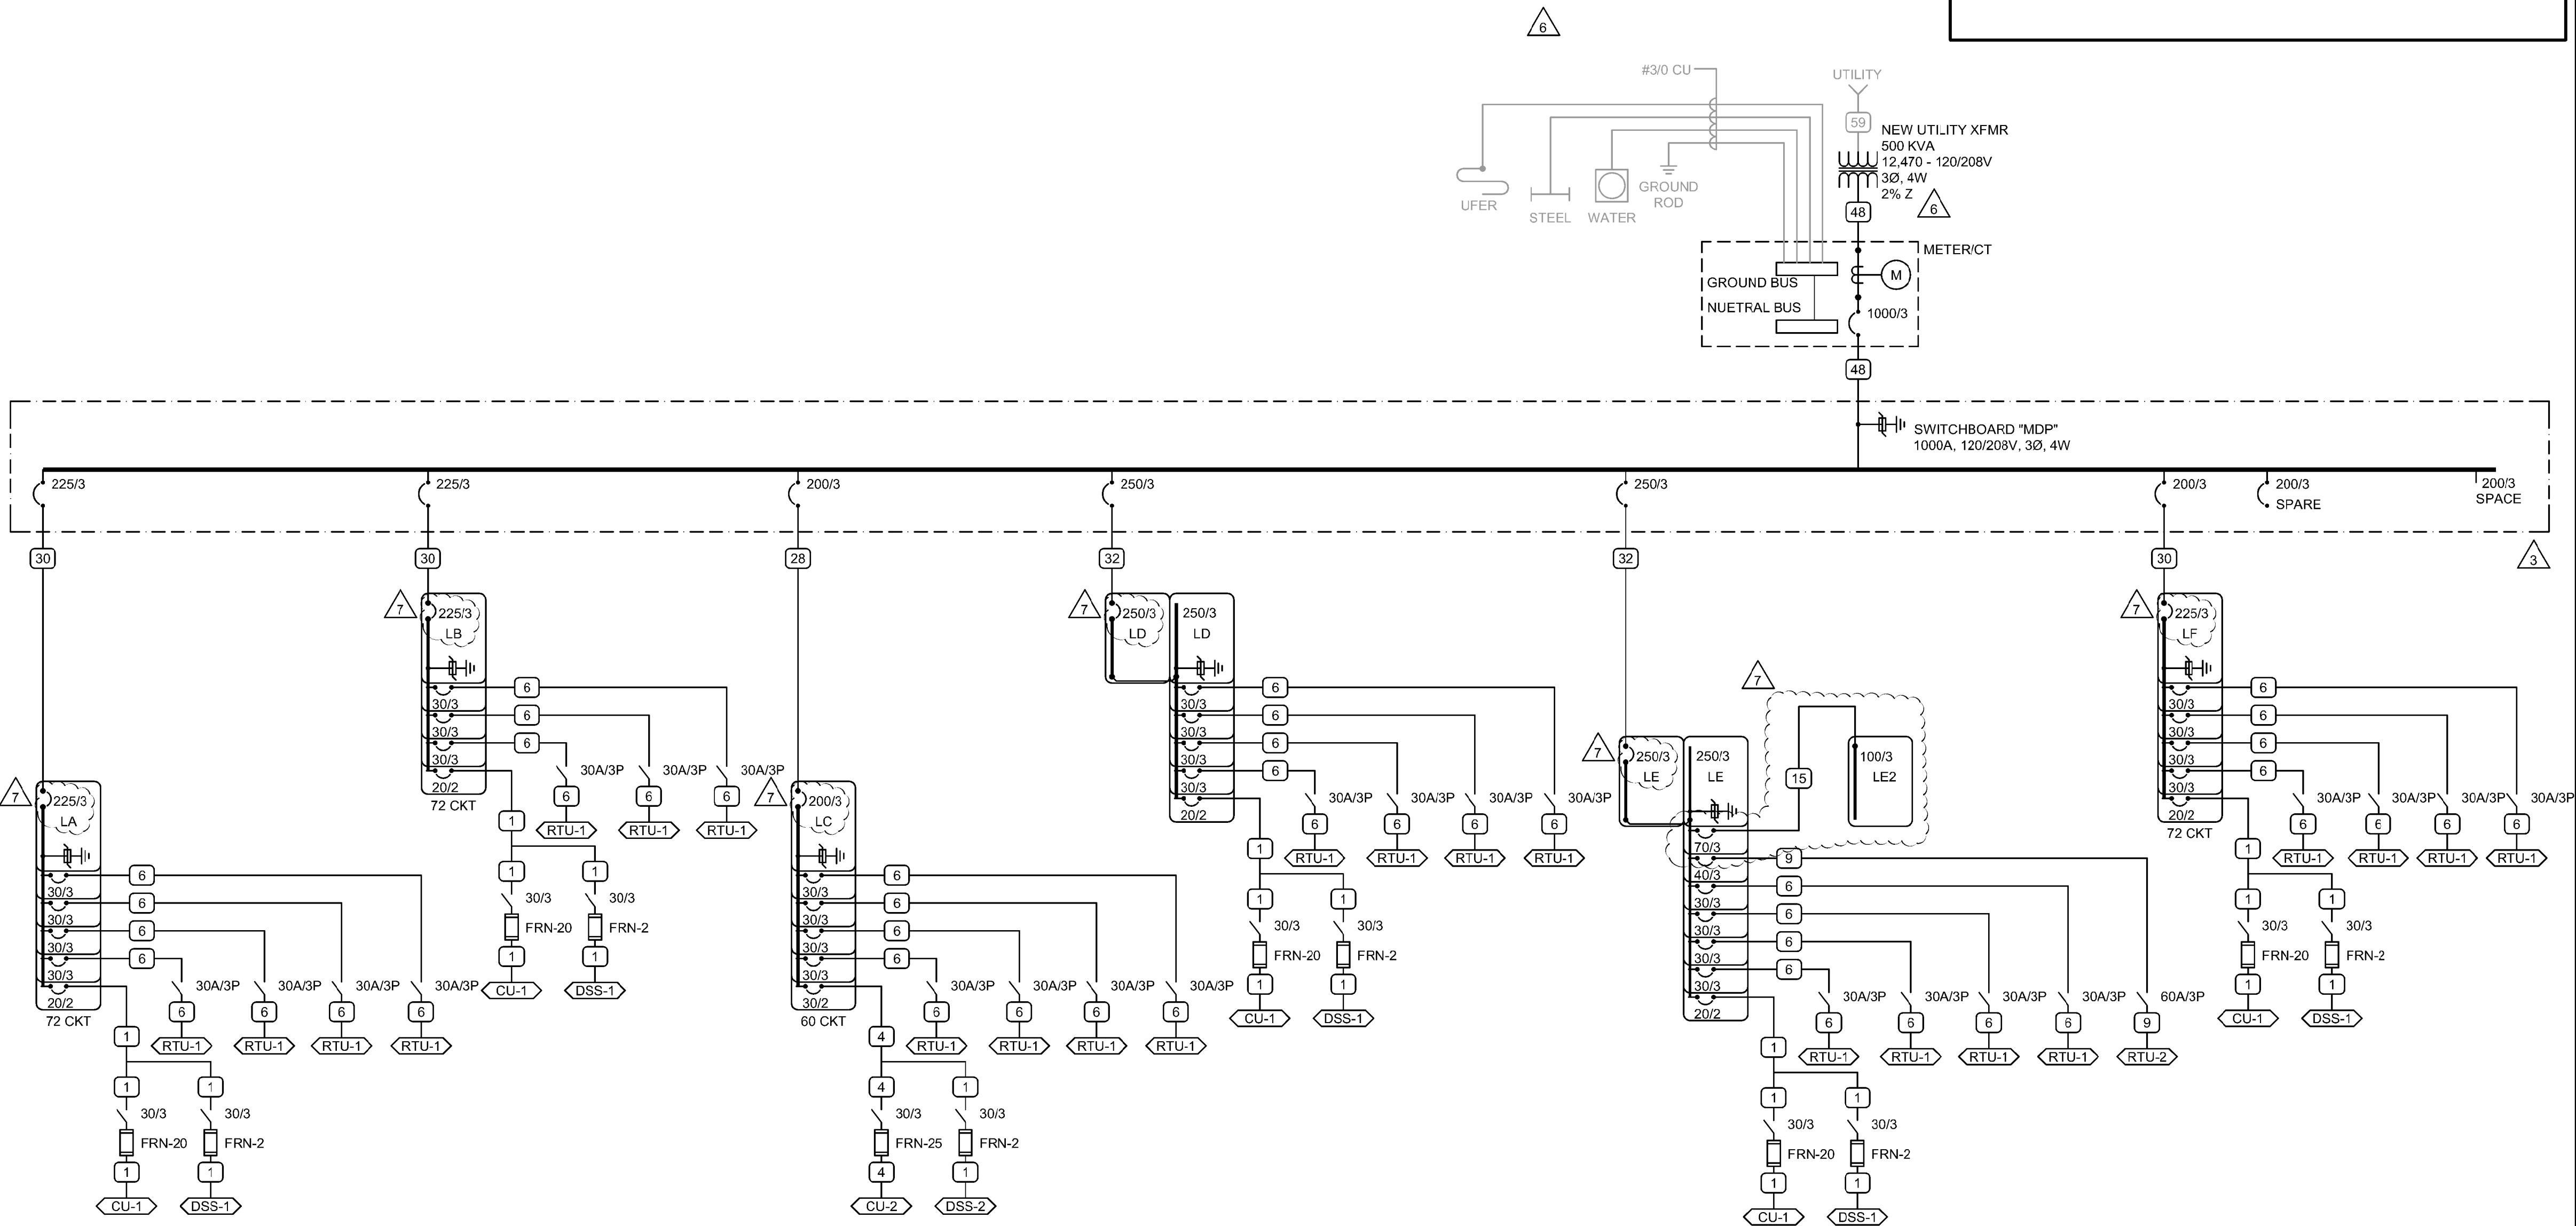

## EQUIPMENT SCHEDULE KEY

E	DIVISION 26
Q	FURNISHED WITH THE EQUIPMENT
*	COORDINATE WITH THE DIVISION 23 TEMPERATURE CONTROL INSTALLER
**	AUTOMATIC CONTROL WIRING BY DIVISION 23

## GENERAL SHEET NOTES

- ALL OVERCURRENT PROTECTIVE DEVICES SHALL HAVE THE SAME AIC RATING AS THE PANEL OR GEAR THEY ARE LOCATED WITHIN.
- ALL ELECTRICAL EQUIPMENT SHALL BE FIELD MARKED WITH THE CALCULATED AVAILABLE FAULT CURRENT PER NEC 110.24(A).

## COPPER CONDUCTOR AND CONDUIT SCHEDULE

SCHEDULE NUMBER  
SUBSCRIPT (NOTE 5)

SYM	AMP	CONDUIT SIZE	CONDUCTOR (NOTE 1)	QTY	SIZE	G	IG/HH	SBJ	NOTES
1	20	.75	2	12	12		12	8	2
2	20	.75	3	12	12		12	8	2,3
3	20	.75	4	12	12		12	8	2,3
4	30	.75	2	10	10		10	8	2
5	30	.75	3	10	10		10	8	2
6	30	.75	4	10	10		10	8	2
7	40	1	2	8	10		8	6	2
8	40	1	3	8	10		8	6	2
9	40	1	4	8	10		8	6	2
10	55	1	2	6	10		8	4	2
11	55	1	3	6	10		8	4	2
12	55	1.25	4	6	10		8	4	2
13	70	1	2	4	8		4	2	2
14	70	1.25	3	4	8		4	2	2
15	70	1.25	4	4	8		4	2	2
16	85	1.25	2	3	8		3	2	2
17	85	1.25	3	3	8		3	2	2
18	85	1.25	4	3	8		3	2	2
19	95	1.25	3	2	8		2	2	2
20	95	1.50	4	2	8		2	2	2
21	130	1.50	3	1	6		2	2	2
22	130	1.50	4	1	6		2	2	2
23	150	2	3	1/0	6		2	1/0	2
24	150	2	4	1/0	6		2	1/0	2
25	175	2	3	2/0	6		2	2/0	2
26	175	2	4	2/0	6		2	2/0	2
27	200	2	3	3/0	6		2	2/0	2
28	200	2.50	4	3/0	6		2	2/0	2
29	230	2.50	3	4/0	4		2	2/0	2
30	230	2.50	4	4/0	4		2	2/0	2
31	255	2.50	3	250	4		1	2/0	2
32	255	2.50	4	250	4		1	2/0	2
33	310	3	3	350	3		1/0	3/0	2
34	310	3	4	350	3		1/0	3/0	2
35	380	3.50	3	500	3		3/0	3/0	2
36	380	4	4	500	3		3/0	3/0	2
37	400	2 EA 2	3	3/0	3		3/0	3/0	2
38	400	2 EA 2.50	4	3/0	3		3/0	3/0	2
39	510	2 EA 2.50	3	250	1		4/0	3/0	2
40	510	2 EA 3	4	250	1		4/0	3/0	2
41	620	2 EA 3	3	350	1/0		4/0	3/0	2,4
42	620	2 EA 3	4	350	1/0		4/0	3/0	2,4
43	760	2 EA 3.50	3	500	1/0		4/0	3/0	2,4
44	760	2 EA 4	4	500	1/0		4/0	3/0	2,4
45	855	3 EA 3	3	300	2/0		4/0	3/0	2,4
46	855	3 EA 3	4	300	2/0		4/0	3/0	2,4
47	1000	3 EA 3.50	3	400	2/0		4/0	3/0	4
48	1000	3 EA 3.50	4	400	2/0		4/0	3/0	4
49	1140	3 EA 4	3	500	3/0		4/0	3/0	4
50	1140	3 EA 4	4	500	3/0		4/0	3/0	4
51	1240	4 EA 3	3	350	3/0		4/0	3/0	4
52	1240	4 EA 3	4	350	3/0		4/0	3/0	4
53	1675	5 EA 4	4	400	4/0		4/0	4/0	4
54	2010	6 EA 4	4	400	250		250	250	4
55	2660	7 EA 4	4	500	350		350	350	4
56	3040	8 EA 4	4	500	500		500	500	4
57	4180	11 EA 4	4	500	500		500	500	4
58		5 EA 4							6
59		5							6
60		10 EA 4							6

### CONDUCTOR AND CONDUIT SCHEDULE NOTES

- CONDUCTORS SHOWN ARE SHOWN FOR EACH CONDUIT WITH MODIFICATIONS AS NOTED IN NOTE 5. ALL CONDUCTORS SHOWN ARE THWN UNLESS OTHERWISE NOTED.
- PROVIDE EQUIPMENT GROUND CONDUCTORS PER TABLE 250-122 WHEN CIRCUIT BREAKERS ARE SIZED GREATER THAN AMPERE RATING SHOWN IN TABLE.
- PROVIDE #10 NEUTRALS FOR MULTIWIRE BRANCH CIRCUITS SERVING COMPUTERS.
- GROUND CONDUCTOR SHALL BE OMITTED BETWEEN THE UTILITY TRANSFORMER AND THE FIRST OVERCURRENT PROTECTIVE DEVICE.
- SYMBOL SUBSCRIPTS:

"2N": INCLUDE TWO NEUTRAL CONDUCTORS, SIZED AS SCHEDULED FOR PHASED AND NEUTRAL CONDUCTORS.

"FG": FULL SIZE GROUND, SIZE EQUIPMENT GROUNDING CONDUCTOR TO BE THE SAME SIZE AS THE PHASE CONDUCTORS.

"HH": NEUTRAL CURRENTS EXIST DUE TO HIGH HARMONIC "NONLINEAR" LOADS. CURRENT CARRYING CONDUCTORS DERATED ACCORDINGLY. PROVIDE THE IG/HH SIZE FOR THE EQUIPMENT GROUNDING CONDUCTOR.

"IG": INCLUDE IG (INSULATED/ISOLATED GROUND CONDUCTOR) SCHEDULED ALONG WITH GROUND OF EQUIPMENT GROUND CONDUCTOR.

"SBJ": SUBSTITUTE "SBJ" CONDUCTOR FOR "G" CONDUCTOR SHOWN, WHICH IS SIZED FOR THE SYSTEM BONDING JUMPER OF THE SEPARATELY DERIVED SYSTEM.


- RACEWAY ONLY. CONDUCTORS PROVIDED BY UTILITY.

Donald L. Welch  
Architect  
7533 Sandy Land Lane  
Midvale, Utah 84047  
801.346.6391  
dwelch5977@msn.com

THE DESIGNS SHOWN AND DESCRIBED HEREIN INCLUDING ALL TECHNICAL DRAWINGS, GRAPHIC REPRESENTATION & MODELS THEREOF, ARE PROPRIETARY & CAN NOT BE COPIED, DUPLICATED, OR COMMERCIALY EXPLOITED IN WHOLE OR IN PART WITHOUT THE SOLE AND EXPRESS WRITTEN PERMISSION FROM DONALD L. WELCH ARCHITECT

THESE DRAWINGS ARE AVAILABLE FOR LIMITED REVIEW AND EVALUATION BY CLIENTS CONSULTANTS, CONTRACTORS, GOVERNMENT AGENCIES, VENDORS, AND OFFICE PERSONNEL ONLY IN ACCORDANCE WITH THIS NOTICE.

### consultant:

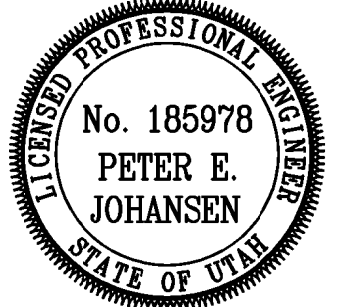

### project:

**Tenant Finish  
for New  
Brighton  
Recovery  
Campus**  
4905, 4911, 4915, 4925,  
4931, & 4953 South 900  
East  
Salt Lake County, Utah

### date

January 04, 2017

### revisions

- PERMIT SET-December 28, 2016
- ADDENDUM #2-January 06, 2017
- ADDENDUM #3-January 11, 2017
- ADDENDUM #4-January 17, 2017
- ADDENDUM #5-January 19, 2017
- ADDENDUM #7-February 24, 2017
- ADDENDUM #8-March 20, 2017

### data

project no:

drawn by:

checked by:

### title

ONE LINE  
DIAGRAM

### sheet

EP601

7 DISTRIBUTION PANELBOARD "MDP"																								
VOLTS/PHASE/WIRE: 120/208 V, 3 PH 4 WIRE						MAIN SIZE & TYPE: 1000 AMP MAIN LUGS						LOCATION: BUILDING A				AIC RATING: 30,000 AIC			NOTES:					
ACCESSORIES:						IDENTIFICATION, GROUNDING BAR, INSULATED GROUND BAR																		
CKT NO	OCB	AMP	POLE	LOAD (kVA)			PANEL / EQUIPMENT	LCL kVA	PHASE LOAD			LCL kVA	PANEL / EQUIPMENT	LOAD (kVA)			OCB	POLE	CKT NO					
				LTG	CO	PWR			A	B	C			LTG	CO	PWR								
1	200	3		1.6	7.7	17.3	LA	27.0	59.6			33.7	LD	2.9	10.9	19.2	200	3	2					
-	-	-		1.5	7.9	18.5	-	28.2		54.4		27.3	-	2.9	10.1	13.6	-	-	-					
-	-	-		0.0	4.8	20.8	-	25.6			58.7	33.9	-	3.0	9.6	20.5	-	-	-					
3	200	3		1.3	5.9	16.9	LB	24.4	57.8			34.1	LE	1.7	9.8	22.2	200	3	4					
-	-	-		1.6	6.2	14.6	-	22.8		60.3		38.3	-	1.5	10.2	26.2	-	-	-					
-	-	-		0.0	6.2	20.6	-	26.8			61.0	34.5	-	1.0	7.9	25.3	-	-	-					
5	200	3		1.5	9.2	10.9	LC	22.0	48.3			27.2	LF	1.8	6.2	18.7	200	3	6					
-	-	-		1.2	6.6	13.4	-	21.5		48.4		27.6	-	1.6	6.5	19.1	-	-	-					
-	-	-		1.4	6.8	11.7	-	20.3			46.3	26.4	-	0.0	7.5	18.9	-	-	-					
7	200	3					SPARE	0.0	0.0				SPACE					-	3	8				
-	-	-					-	0.0		0.0		0.0	-				-	-	-					
-	-	-					-	0.0		0.0	0.0	0.0	-				-	-	-					
TOTALS:								CONNECTED kVA PER PHASE				166	163	166	CONNECTED TOTAL kVA				495					
								CONNECTED AMPS PER PHASE				1381	1360	1383	CONNECTED AVERAGE AMPS PER PHASE				1375					
NEC DIVERSIFIED LOAD CALCULATIONS																								
LIGHTING 27kVA @125% =								33 kVA				ALL OTHER LOADS @100% =				328 kVA				DIVERSIFIED TOTAL kVA = 436				
RECEPTACLES 10kVA @100% =								10 kVA				25% OF LARGEST MOTOR =				0 kVA				AVERAGE AMPS PER PHASE = 1212				
REMAINDER 130kVA @ 50% =								65 kVA																

7 3 PANEL "LA"																								
VOLTS/PHASE/WIRE: 120/208 V, 3 PH 4 WIRE						PANEL SIZE & TYPE: 22" W x 6" D BOLT-ON					MAIN SIZE & TYPE: 225 AMP MAIN CB					LOCATION:			AIC RATING: 42,000 AIC		NOTES:			
ACCESSORIES: PANEL DIRECTORY, IDENTIFICATION, GROUNDING BAR, INSULATED GROUND BAR																								
CKT NO	OCB	LOAD (kVA)			DESCRIPTION					LCL kVA	PHASE LOAD			LCL kVA	DESCRIPTION					LOAD (kVA)			OCB	CKT NO
	AMP	POLE	LTG	CO	PWR						A	B	C					LTG	AMP	POLE				
1	20	1	1.3							1.6	2.3			1.0		WASHER LAUNDRY A127		1.0		20	1	2		
3	20	1	1.5							1.9		1.9		0.4		CO LAUNDRY A127		0.4		20	1	4		
5	30	2				1.3				1.3			2.6	1.3		DRYER LAUNDRY A101				1.3	30	2		
7	-	-				1.3				1.3	2.6			1.3		-				1.3	-	8		
9	20	1				1.0				1.0		2.6		1.6		WASHER LAUNDRY A101		1.4	0.2	20	1	10		
11	20	1	1.4	0.2						1.6			1.9	0.3		ROOMS A103, A104		0.2	0.1	20	1	12		
13	20	1				0.8				0.8	2.0			1.2		CO ROOMS A101, A102		1.1	0.1	20	1	14		
15	20	1				0.6	0.6			1.2			2.4	1.2		WH/PUMP/FIRE COMP.		1.1	0.1	20	1	16		
17	20	1	1.1	0.1						1.2			1.8	0.6		RM A107		0.6		20	1	18		
19	20	1	1.1	0.1						1.2	2.1			0.9		RM A110		0.9		20	1	20		
21	20	1	1.1	0.1						1.2		2.4		1.2		RM A111		1.1	0.1	20	1	22		
23	20	1				0.9				0.9			3.3	2.4		CO RF ACCS, DINING A113		2.4	50	2	24			
25	20	1				0.6				0.6	3.0			2.4		CO FAMILY ROOM/STOR.		2.4	-	-	-	26		
27	50	2				2.4				2.4		3.4		1.0		RANGE KITCHEN A115		1.0		20	1	28		
29	-	-				2.4				2.4			2.6	0.2		-		0.2		20	1	30		
31	20	1				1.0				1.0	2.0			1.0		REFRIGERATOR A115				20	1	32		
33	20	1				0.2				0.2		1.2		1.0		CO KITCHEN A115		1.0	20	1	34			
35	20	1				1.0				1.0			2.9	1.9		DISHWASHER A115		1.9	30	3	36			
37	20	1				1.0				1.0	2.9			1.9		GARBAGE DISP. A115		1.9	-	-	-	38		
39	30	3				1.9				1.9		3.8		1.9		RTU-1		1.9	-	-	-	40		
41	-	-				1.9				1.9			3.8	1.9		-		1.9	30	3	42			
43	-	-				1.9				1.9		3.8		1.9		RTU-1		1.9	-	-	-	44		
45	30	3				1.9				1.9			3.8	1.9		-		1.9	-	-	-	46		
47	-	-				1.9				1.9				2.7	0.8	-		0.8	20	2	48			
49	-	-				1.9				1.9		2.7		0.8		EUH-3		0.8	-	-	-	50		
51	20	1				1.0				1.0		2.0		1.0		-		1.0	20	2	52			
53	20	1				1.0				1.0			2.0	1.0		EUH-2		1.0	-	-	-	54		
55	20	1				1.7				1.7	2.0			0.4		-		0.3		20	1	56		
57	20	1				1.7				1.7		3.4		1.7		EGRESS LIGHTING				20	2	58		
59	20	1				0.4				0.4			2.1	1.7		CU-1/DSS-1		1.7	-	-	-	60		
61	20	1				0.8				0.8	1.2			0.4		RTU CO's		0.4		20	1	62		
63	20	1				1.0				1.0		1.0		0.0		KITCHEN ISLAND CO		0.4		20	1	64		
65	20	1								0.0				0.0		SMOKE DETECTORS				20	1	66		
67	20	1								0.0	0.0			0.0		SPARE				20	1	68		
69	20	1								0.0		0.0		0.0		SPARE				20	1	70		
71	20	1								0.0			0.0	0.0		SPARE				20	1	72		
TOTALS:										CONNECTED kVA PER PHASE					27	28	26	CONNECTED TOTAL kVA					80	
										CONNECTED AMPS PER PHASE					221	232	213	CONNECTED AVERAGE AMPS PER PHASE					222	
NEC DIVERSIFIED LOAD CALCULATIONS																								
LIGHTING 3kVA @125% =					4 kVA					ALL OTHER LOADS @100% =					57 kVA					DIVERSIFIED TOTAL kVA = 77				
RECEPTACLES 10kVA @100% =					10 kVA					25% OF LARGEST MOTOR =					2 kVA					AVERAGE AMPS PER PHASE = 215				
REMAINDER 10kVA @ 50% =					5 kVA																			

VOLTS/PH-ASE/WIRE: 120/208 V, 3 PH 4 WIRE										PANEL SIZE & TYPE: 22" W x 6" D, BOLT-ON				MAIN SIZE & TYPE: 225 AMP MAIN CB				LOCATION:				AIC RATING: 22,000 AIC				NOTES:			
ACCESSORIES:										PANEL DIRECTORY, IDENTIFICATION, GROUNDING BAR, INSULATED GROUND BAR, SUBFEED LUGS																			
CKT NO	OCP	LOAD (kVA)				DESCRIPTION	LCL kVA	PHASE LOAD			LCL kVA	DESCRIPTION	LOAD (kVA)				OCP				CKT NO								
		AMP	POLE	LTG	CO			PWR	A	B			C	LTG	CO	PWR	AMP	POLE											
1	20	1	1.3			LIGHTING	1.6	2.6			1.3	DRYER LAUNDRY B125				1.3	30	2	2	4									
3	20	1	1.3			LIGHTING	1.6		2.6		1.3	-				1.3	-	-	4										
5	30	2				1.3	DRYER LAUNDRY B101	1.3			1.7	0.4	CO LAUNDRY B125			0.4	20	1	6	8									
7	-	-				1.3	-	1.3	2.3		1.0	WASHER B125				1.0	20	1	8										
9	20	1		1.4	0.2		ROOMS B104, B105	1.6		3.2	1.6	ROOMS B12, B123			1.4	0.2	20	1	10	10									
11	20	1		1.0			WASHER LAUNDRY B101	1.0			2.3	1.3	WH/PUMP/FIRE COMP			1.3	20	1	12										
13	20	1		0.8			CO ROOMS B101, B102	0.8	2.0			1.2	ROOM B119			1.1	0.1	20	1	14									
15	20	1		0.2	0.1		CO & EF-1 CUST B106	0.3		1.5		1.2	ROOM B117			1.1	0.1	20	1	16									
17	20	1		1.1	0.1		ROOM B108	1.2			2.2	1.0	REFRIGERATOR B129			1.0	20	1	18										
19	20	1		1.1	0.1		ROOM B111	1.2	1.7			0.5	CO DINING B127			0.5	20	1	20										
21	20	1		0.5			CO FAMILY RM B114	0.5		1.3		0.8	CO FAMILY/STOR. B128,B121			0.8	20	1	22										
23	20	1		0.8			CO DINING RM B113	0.8			3.2	2.4	RANGE B129				2.4	50	2	24									
25	20	1		1.0			REFRIGERATOR B115	1.0	3.4			2.4	-				2.4	-	-	26									
27	50	2			2.4		RANGE B115	2.4		3.4		1.0	GARBAGE DISP.				1.0	20	1	28									
29	-	-			2.4		-	2.4			3.4	1.0	DISHWASHER B129				1.0	20	1	30									
31	20	1		0.2			CO KITCHEN B115	0.2	0.4			0.2	CO KITCHEN B129			0.2		20	1	32									
33	20	1			1.0		DISHWASHER B115	1.0		2.9		1.9	RTU-1				1.9	30	3	34									
35	20	1			1.0		GARBAGE DISP. B115	1.0			2.9	1.9	-				1.9	-	-	36									
37	30	3			1.9		RTU-1	1.9	3.8			1.9	-				1.9	-	-	38									
39	-	-			1.9		-	1.9		2.9		1.0	EUH-2				1.0	20	2	40									
41	-	-			1.9		-	1.9			2.9	1.0	-				1.0	-	-	42									
43	30	3			1.9		RTU-1	1.9	2.7			0.8	EUH-3				0.8	20	2	44									
45	-	-			1.9		-	1.9		2.7		0.8	-				0.8	-	-	46									
47	-	-			1.9		-	1.9			3.6	1.7	EUH-1				1.7	20	-	48									
49	20	2			0.8		EUH-3	0.8	2.5			1.7	-				1.7	-	-	50									
51	-	-			0.8		-	0.8		1.1		0.4	EGRESS LIGHTING			0.3		20	1	52									
53	20	2			1.0		EUH-2	1.0			2.7	1.7	CU-1/DSS-1				1.7	20	-	54									
55	-	-			1.0		-	1.0	2.7			1.7	-				1.7	-	-	56									
57	20	1		0.4			KITCHEN ISLAND CO	0.4		0.8		0.4	KITCHEN ISLAND CO			0.4		20	1	58									
59	20	1		0.6			RTU CO'S	0.6			1.6	1.0	SMOKE DETECTORS				1.0	20	1	60									
61	20	1					SPARE	0.0	0.0			0.0	SPARE					20	1	62									
63	20	1					SPARE	0.0		0.0		0.0	SPARE					20	1	64									
65	20	1					SPARE	0.0			0.0	0.0	SPARE					20	1	66									
67	20	1					SPARE	0.0	0.0			0.0	SPARE					20	1	68									
69	20	1					SPARE	0.0		0.0		0.0	SPARE					20	1	70									
71	20	1					SPARE	0.0			0.0	0.0	SPARE					20	1	72									
TOTALS:								CONNECTED KVA PER PHASE				24	21	26	CONNECTED TOTAL KVA								73						
								CONNECTED AMPS PER PHASE				201	187	221	CONNECTED AVERAGE AMPS PER PHASE								203						
NEC DIVERSIFIED LOAD CALCULATIONS																													
LIGHTING 10kVA @125% =								4 kVA				ALL OTHER LOADS @100% =								52 kVA				DIVERSIFIED TOTAL KVA =		71			
RECEPTACLES 3kVA @100% =								10 kVA				25% OF LARGEST MOTOR =								2 kVA				AVERAGE AMPS PER PHASE =		198			
REMAINDER 8kVA @ 50% =								4 kVA																					



7

PANEL "LD"

3

VOLTS/PHASE/WIRE:					PANEL SIZE & TYPE:					MAIN SIZE & TYPE:					LOCATION:					AIC RATING:			NOTES:																	
120/208 V, 3 PH 4 WIRE					22" W x 6" D, BOLT-ON					250 AMP MAIN CB										10,000 AIC																				
ACCESSORIES:										PANEL DIRECTORY, IDENTIFICATION, GROUNDING BAR, INSULATED GROUND BAR, SUBFEED LUGS																														
CKT NO	OCF	LOAD (KVA)			DESCRIPTION			PHASE LOAD			LCL KVA	DESCRIPTION			LOAD (KVA)			OCF	CKT																					
NO	AMP	POLE	LTG	CO	PWR			A	B	C					LTG	CO	PWR	AMP	POLE	NO																				
1	20	1	1.4				LIGHTING	1.8	2.8		1.4		CO DINING D103		1.4			20	1	2																				
3	20	1	1.2				LIGHTING	1.5		2.4	1.2		CO COMMON AREA D112		1.2			20	1	4																				
5	20	1	0.6				LIGHTING	0.8			1.6	1.0	FB WORKOUT RM D113		1.0			20	1	6																				
7	20	1			0.9		CO RECEPTION D109	0.9	1.9		1.0		FB WORKOUT RM D113		1.0			20	1	8																				
9	20	1			0.7		WH/PUMP	0.7		1.7	1.0		FB WORKOUT RM D113		1.0			20	1	10																				
11	20	1		0.9	0.3		CO D108A, D108, D107, D106	1.2			2.2	1.0	CO WORKOUT RM D113		1.0			20	1	12																				
13	20	1	0.6				CO PNTRY/SERV. D104,105	0.6	1.6			1.0	CO WORKOUT RM D113		1.0			20	1	14																				
15	20	1	1.0				REFRIGERATOR D105	1.0		2.0	1.0		CO WORKOUT RM D113		1.0			20	1	16																				
17	20	1	1.3				FREEZER D105	1.3			2.3	1.0	CO WORKOUT RM D113		1.0			20	1	18																				
19	20	1			1.5		KITCHEN HOOD	1.5	2.5		1.0		CO WORKOUT RM D113		1.0			20	1	20																				
21	30	2			1.7		SOFT SERVE MACHINE	1.7		2.3	0.6		CO WORKOUT RM D113		0.6			20	1	22																				
23	-	-			1.7		-	1.7			2.5	0.8	FIRE CO/FIRE COMP D114A		0.2	0.6		20	1	24																				
25	20	1	0.6				CO KITCHEN D101	0.6	1.4		0.8		CO OFFICE/STOR D115		0.8			20	1	26																				
27	20	1	1.0				CO KITCHEN D101	1.0		1.8	0.8		CO YOGA STUDIO D114		0.8			20	1	28																				
29	50	2			4.0		DISHWASHER	4.0			5.0	1.0	CO OFFICE D118		1.0			20	1	30																				
31	-	-			4.0		-	4.0	4.8		0.8		CO MUSIC ROOM D117		0.8			20	1	32																				
33	20	1	0.6				SANDWICH/SALAD FRIDGE.	0.6		1.4	0.8		CO ART ROOM D116		0.8			20	1	34																				
35	20	1	1.0				CO KITCHEN D101	1.0			1.4	0.4	CO COMPUTER LAB D119		0.4			20	1	36																				
37	20	1	1.8				ESPRESSO MACHINE	1.8	2.2		0.4		CO COMPUTER LAB D119		0.4			20	1	38																				
39	20	1	1.0				CO KITCHEN D101	1.0		1.4	0.4		CO COMPUTER LAB D119		0.4			20	1	40																				
41	20	3			0.5		GEF-1	0.5			2.4	1.9	RTU-1			1.9	30	3	42																					
43	-	-			0.5		-	0.5	2.4		1.9		-			1.9	-	-	44																					
45	-	-			0.5		-	0.5		2.4	1.9		-			1.9	-	-	46																					
47	20	3	0.4				MAU-1	0.4			2.3	1.9	RTU-1			1.9	30	3	48																					
49	-	-			0.4		-	0.4	2.3		1.9		-			1.9	-	-	50																					
51	-	-			0.4		-	0.4	2.3		1.9		-			1.9	-	-	52																					
53	30	3	1.9				RTU-1	1.9			2.9	1.0	EUH-2			1.0	20	2	54																					
55	-	-	1.9				-	1.9	2.9		1.0		-			1.0	-	-	56																					
57	-	-	1.9				-	1.9		3.8	1.9		RTU-1			1.9	30	3	58																					
59	20	1	1.8				ICE MAKER	1.8			3.7	1.9	-			1.9	-	-	60																					
61	20	1			1.5		ANSUL FIRE PANEL	1.5	3.4		1.9		-			1.9	-	-	62																					
63	20	1	0.2				EGRESS LIGHTING	0.3		1.9	1.7		EUH-1			1.7	20	2	64																					
65	20	1	1.5				BLDG A & B CANOPY LTG	1.9			3.2	1.7	-			1.7	-	-	66																					
67	20	1	1.5				BLDG E & F CANOPY LTG	1.9	2.5			1.0	EUH-2			1.0	20	2	68																					
69	20	1	1.5				BLDG C & D CANOPY LTG	1.9		2.5	1.0		-			1.0	-	-	70																					
71	20	1	0.9				PARKING LOT LTG	1.1			2.6	1.7	CU-1/DSS-1			1.7	20	2	72																					
73	20	1	0.6				RTU CO'S	0.6	2.3		1.7		-			1.7	-	-	74																					
75	20	1					SPARE	0.0		1.0	1.0		EUH-2			1.0	20	1	76																					
77	20	1					SPARE	0.0			1.0	1.0	-				20	1	78																					
79	20	1					SPARE	0.0	0.0		0.0		SPARE				20	1	80																					
81	20	1					SPARE	0.0			0.0		SPARE				20	1	82																					
83	20	1					SPARE	0.0			0.0	0.0	SPARE				20	1	84																					
TOTALS:																					CONNECTED KVA PER PHASE					33	27	33	CONNECTED TOTAL KVA					93						
																					CONNECTED AMPS PER PHASE					275	224	276	CONNECTED AVERAGE AMPS PER PHASE					258						
NEC DIVERSIFIED LOAD CALCULATIONS																																								
LIGHTING 9KVA @125% =																					11 KVA					ALL OTHER LOADS @100% =					54 KVA					DIVERSIFIED TOTAL KVA = 85				
RECEPTANCES 10KVA @100% =																					10 KVA					25% OF LARGEST MOTOR =					0 KVA					AVERAGE AMPS PER PHASE = 236				
REMAINDER 21KVA @ 50% =																					10 KVA																			

<div><div><div></div></div><div>PANEL "LE2"</div></div>																								
VOLTS/PHASE/WIRE: 120/208 V, 3 PH 4 WIRE					PANEL SIZE & TYPE: 22" W x 6" D BOLT-ON				MAIN SIZE & TYPE: 100 AMP MAIN LUGS				LOCATION:			AIC RATING: 10,000 AIC		NOTES:						
ACCESSORIES:					PANEL DIRECTORY, IDENTIFICATION, GROUNDING BAR, INSULATED GROUND BAR, SUBFEED LUGS																			
CKT NO	OCP AMP	POLE	LOAD (kVA)		DESCRIPTION	LCL kVA	PHASE LOAD			LCL kVA	DESCRIPTION	LOAD (kVA)		OCP AMP	POLE	CKT NO								
			LTG	CO			PWR	A	B			C	LTG				CO	PWR						
1	20	2			0.8		EUH-3	0.8	1.0		0.2		CO SERVING E140	0.2		20	1	2						
3	-	-			0.8		-	0.8		1.0	0.2		CO SERVING E140	0.2		20	1	4						
5	20	2			1.0		EUH-2	1.0			2.0	1.0	REFRIGERATOR E140	1.0		20	1	6						
7	-	-			1.0		-	1.0	2.1		1.1		GATHERING/LEARN E136	1.1		20	1	8						
9	20	2			0.8		EUH-3	0.8		1.6		0.8	CO A/V E139	0.8		20	1	10						
11	-	-			0.8		-	0.8			0.8	0.0	SPARE			20	1	12						
13	20	2			0.8		EUH-3	0.8	0.8			0.0	SPARE			20	1	14						
15	-	-			0.8		-	0.8		0.8		0.0	SPARE			20	1	16						
17	20	2			1.7		EUH-1	1.7			1.7	0.0	SPARE			20	1	18						
19	-	-			1.7		-	1.7	1.7			0.0	SPARE			20	1	20						
21	20	2			1.0		EUH-2	1.0		1.0		0.0	SPARE			20	1	22						
23	-	-			1.0		-	1.0			1.0	0.0	SPARE			20	1	24						
25	20	1		0.2	0.6		CO FIRE E135/FIRE COMP.	0.8	0.8			0.0	SPARE			20	1	26						
27	20	1		1.0			DRINKING FOUNTAIN	1.0		1.0		0.0	SPARE			20	1	28						
29	20	1					SPARE	0.0			0.0	0.0	SPARE			20	1	30						
31	20	1					SPARE	0.0	0.0			0.0	SPARE			20	1	32						
33	20	1					SPARE	0.0		0.0		0.0	SPARE			20	1	34						
35	20	1					SPARE	0.0			0.0	0.0	SPARE			20	1	36						
TOTALS:					CONNECTED kVA PER PHASE						CONNECTED TOTAL kVA													
					6 5 6						17													
					CONNECTED AMPS PER PHASE						CONNECTED AVERAGE AMPS PER PHASE													
					53 45 46						48													
NEC DIVERSIFIED LOAD CALCULATIONS																								
LIGHTING 0kVA @125% =					0 kVA					ALL OTHER LOADS @100% =					13 kVA					DIVERSIFIED TOTAL kVA = 17				
RECEPTACLES 5kVA @100% =					5 kVA					25% OF LARGEST MOTOR =					0 kVA					AVERAGE AMPS PER PHASE = 48				
REMAINDER 0kVA @50% =					0 kVA																			

LIGHTING CONTROL PANEL SCHEDULE										
LX			AUTOMATIC CONTROL				OVERRIDE CONTROL		OTHER	
RELAY	CIRCUIT	VOLTS	LOAD DESCRIPTION	ON	OFF	SCHEDULE	ON	OFF	CONTROLS	REMARKS
1	LD	120	BLDG A & B CANOPY LTG	EPC	EPC				EPC	
2	LD	120	BLDG E & F CANOPY LTG	EPC	EPC				EPC	
3	LD	120	BLDG C & D CANOPY LTG	EPC	EPC				EPC	
4	LD	120	PARKING LOT LIGHTING	EPC	EPC				EPC	
5		120	SPARE							
6		120	SPARE							
BH = BUSINESS HOURS PER SCHEDULE (EXAMPLE SCHEDULE 1: ON AT 6:00 AM / OFF AT 8:00 PM) - UP TO 6 SCHEDULES PER PANEL AVAILABLE AS SELECTED BY OWNER SCHEDULE BH-1: LIGHTS ON 7:00 AM / LIGHTS OFF 9:00 PM/MONDAY - FRIDAY EXCLUDING HOLIDAYS SCHEDULE BH-2: LIGHTS ON 7:00 AM / LIGHTS OFF 10:00 PM / MONDAY - FRIDAY EXCLUDING HOLIDAYS SCHEDULE BH-3: LIGHTS ON 7:00 AM/LIGHTS OFF 11:PM / 7 DAYS/WEEK SCHEDULE BH-4: ON CONTROL BY EPC / OFF 11:00 PM SCHEDULE BH-5: LIGHT ON 7:00 AM CONTROLLED BY IPC OFF 7:00 PM SCHEDULE BH-6: NOT USED EPC = EXTERIOR PHOTO CELL IPC(XXX) = INTERIOR PHOTO CELL. PROVIDE DIMMING CONTROL LC - OVERRIDE CONTROL WALL SWITCH CONTROL; PUSH ON TURNS CIRCUIT ON FOR AUTO OFF AFTER 30 MINUTES										

⚠ <b>PANEL "LE"</b> ⚠																				
VOLTS/PH-ASE/WIRE: 120/208 V, 3 PH 4 WIRE				PANEL SIZE & TYPE: 22" W x 6" D, BOLT-ON				MAIN SIZE & TYPE: 250 AMP MAIN CB				LOCATION:		AIRC RATING: 10,000 AIC		NOTES:				
ACCESSORIES: PANEL DIRECTORY, IDENTIFICATION, GROUNDING BAR, INSULATED GROUND BAR, SUBFEED LUGS																				
CKT NO	OCP AMP	LOAD (kVA)			DESCRIPTION	LCL kVA	PHASE LOAD			LCL kVA	DESCRIPTION	LOAD (kVA)			OCP AMP	CKT NO				
		CO	POLE	PWR			A	B	C			LTG	CO	PWR			POLE			
1	20	1	1.2		LIGHTING	1.5	2.2			1.0	WASHER LAUNDRY E127	1.0		20	1	2				
3	20	1	1.5		LIGHTING	1.9		2.8		1.3	DRYER LAUNDRY E127		1.3	30	2	4				
5	20	1	1.0		LIGHTING	1.3			2.3	1.3	-		1.3	-	-	6				
7	30	2		1.3	DRYER LAUNDRY E101	1.3	2.0			0.7	CO E134, E127	0.6	0.1	20	1	8				
9	-	-		1.3	-	1.3		2.9		1.6	ROOMS E125,E126	1.4	0.2	20	1	10				
11	20	1	1.4	0.2	ROOMS E103, E104	1.6			2.8	1.2	ROOM E119	1.1	0.1	20	1	12				
13	20	1	1.0		WASHER LAUNDRY E101	1.0	2.2			1.2	ROOM E122	1.1	0.1	20	1	14				
15	20	1	0.6		CO ROOMS E101,E102	0.6		0.9		0.3	CO/EF-1 CUSTODIAN E124	0.2	0.1	20	1	16				
17	20	1	0.2	0.8	WH/PUMP/CO STORAGE	1.0			2.2	1.2	ROOM E118	1.1	0.1	20	1	18				
19	20	1	1.1	0.1	ROOM E107	1.2	2.1			0.9	CO FAMILY ROOM E131	0.9		20	1	20				
21	20	1	1.1	0.1	ROOM E110	1.2		1.8		0.6	CO DINING ROOM E130	0.6		20	1	22				
23	20	1	1.1	0.1	ROOM E111	1.2			2.2	1.0	REFRIGERATOR E132	1.0		20	1	24				
25	20	1	1.0		CO DINING E113	1.0	1.2			0.2	CO KITCHEN E132	0.2		20	1	26				
27	20	1	0.6		CO FAMILY E114	0.6		3.0		2.4	RANGE E132	2.4	50	2	28					
29	20	1	1.0		REFRIGERATOR E115	1.0			3.4	2.4	-	2.4	-	-	30					
31	50	2		2.4	RANGE E115	2.4	3.4			1.0	DISHWASHER E132	1.0	20	1	32					
33	-	-		2.4	-	2.4		3.4		1.0	GARBAGE DISP E132	1.0	20	1	34					
35	20	1		1.0	GARBAGE DISPOSAL	1.0			2.9	1.9	RTU-1	1.9	30	3	36					
37	20	1		1.0	DISWASHER E115	1.0	2.9			1.9	-	1.9	-	-	38					
39	20	1		0.2	CO KITCHEN E115	0.2		2.1		1.9	-	1.9	-	-	40					
41	30	3		1.9	RTU-1	1.9			3.8	1.9	RTU-1	1.9	30	3	42					
43	-	-		1.9	-	1.9	3.8			1.9	-	1.9	-	-	44					
45	-	-		1.9	-	1.9		3.8		1.9	-	1.9	-	-	46					
47	30	3		1.9	RTU-1	1.9			3.8	1.9	RTU-2	1.9	40	3	48					
49	-	-		1.9	-	1.9	3.8			1.9	-	1.9	-	-	50					
51	-	-		1.9	-	1.9		3.8		1.9	-	1.9	-	-	52					
53	20	2		0.8	EUH-3	0.8			1.8	1.0	EUH-2	1.0	20	2	54					
55	-	-		0.8	-	0.8	1.8			1.0	-	1.0	-	-	56					
57	20	2		1.0	EUH-2	1.0		1.8			EUH-3	0.8	20	2	58					
59	-	-		1.0	-	1.0			1.8	0.8	-	0.8	-	-	60					
61	20	1	0.5		EGRESS LIGHTS	0.6	0.9			0.4	KITCHEN ISLAND CO	0.4		20	1	62				
63	20	2		1.7	CU-1/DSS-1	1.7		2.7		1.0	SMOKE DETECTORS	1.0	20	1	64					
65	-	-		1.7	-	1.7				1.7	0.0	SPARE		20	1	66				
67	20	1		1.0	RTU CO'S	1.0	1.0			0.0	SPARE		20	1	68					
69	20	1	0.4		KITCHEN ISLAND CO	0.4		0.4		0.0	SPARE		20	1	70					
71	20	1			SPARE	0.0			0.0	0.0	SPARE		20	1	72					
73	20	1			SPARE	0.0	0.0			0.0	SPARE		20	1	74					
75	20	1			SPARE	1.7		0.0		0.0	SPARE		20	1	76					
77	20	1			SPARE	1.7			0.0	0.0	SPARE		20	1	78					
79	20	1			SPARE	0.0	6.4			6.4	LE2	1.5	4.9	70	3	80				
81	20	1			SPARE	0.0				8.5	-	5.1	3.4	-	-	82				
83	20	1			SPARE	0.0			5.5	5.5	-	1	4.5	-	-	84				
TOTALS:						CONNECTED 4kVA PER PHASE			34	38	34	CONNECTED TOTAL kVA						106		
						CONNECTED AMPS PER PHASE			281	316	285	CONNECTED AVERAGE AMPS PER PHASE						294		
NEC DIVERSIFIED LOAD CALCULATIONS																				
LIGHTING 4kVA @125% =						5 kVA		ALL OTHER LOADS @100% =						74 kVA		DIVERSIFIED TOTAL kVA =		98		
RECEPTACLES 10kVA @100% =						10 kVA		25% OF LARGEST MOTOR =						0 kVA		AVERAGE AMPS PER PHASE =		272		
REMAINDER 18kVA @ 50% =						9 kVA														

PANEL "LF"

VOLTS/PH-ASE/WIRE: 120/208 V, 3 PH 4 WIRE				PANEL SIZE & TYPE: 22" W x 6" D, BOLT-ON				MAIN SIZE & TYPE: 225 AMP MAIN CB				LOCATION: <div><div></div><div>6</div></div>		AIC RATING: 10,000 AIC	NOTES:								
ACCESSORIES: PANEL DIRECTORY, IDENTIFICATION, GROUNDING BAR, INSULATED GROUND BAR																							
CKT NO	OCF	LOAD (kVA)			DESCRIPTION			LCL kVA	PHASE LOAD			LCL kVA	DESCRIPTION			LOAD (kVA)			OCF	AMP	POLE	CKT NO	
		NOM	AMP	POLE	LTG	CO	PWR		A	B	C						CO	PWR					
1	20	1	1.5						1.9	2.8		1.3		DRYER LAUNDRY F127				1.3	30	2			2
3	20	1	1.6						2.0		2.9	1.3		-				1.3	-				4
5	30	2					1.3		1.3			2.9	1.6	ROOMS F125,F126			1.4	0.2	20	1			6
7	-	-					1.3		1.3	2.3		1.0		WASHER LAUNDRY F127			1.0		20	1			8
9	20	1			1.4	0.2			1.6		2.0	0.4		ROOMS F103,F104			0.4		20	1			10
11	20	1			1.0				1.0			2.2	1.2	WASHER LAUNDRY F101			1.1	0.1	20	1			12
13	20	1			0.6				0.6	1.8		1.2		CO ROOMS F101-F102			1.1	0.1	20	1			14
15	20	1			1.1	0.1			1.2		1.5	0.3		ROOM F110			0.2	0.1	20	1			16
17	20	1			1.1	0.1			1.2			2.1	0.9	ROOM F107			0.9		20	1			18
19	20	1			0.6	0.6			1.2	1.8		0.6		WH/PUMP/FIRE COMP.			0.6		20	1			20
21	20	1			1.1	0.1			1.2		2.4	1.2		ROOM F111			1.1	0.1	20	1			22
23	20	1			0.6				0.6			1.6	1.0	CO DINING F113									24
25	20	1			0.9				0.9	3.3		2.4		CO FAMILY F114									26
27	20	1			1.0				1.0		3.4	2.4		REFRIGERATOR F115			1.0		20	1			28
29	50	2				2.4			2.4			3.4	1.0	RANGE F115									30
31	-	-				2.4			2.4	3.4		1.0		GARBAGE DISP. F132									32
33	20	1			1.0				1.0		1.2	0.2		DISHWASHER F132			0.2		20	1			34
35	20	1			1.0				1.0			2.9	1.9	KITCHEN CO F132									36
37	20	1			0.2				0.2	2.1		1.9		RTU-1				1.9	30	3			38
39	30	3				1.9			1.9		3.8	1.9		CO KITCHEN F115				1.9	-	-			40
41	-	-				1.9			1.9			3.8	1.9	RTU-1				1.9	30	3			42
43	-	-				1.9			1.9	3.8		1.9		-				1.9	-	-			44
45	30	3				1.9			1.9		3.8	1.9		-				1.9	-	-			46
47	-	-				1.9			1.9			2.9	1.0	EUH-2				1.0	20	2			48
49	-	-				1.9			1.9	2.9		1.0		-				1.0	-	-			50
51	20	2				1.7			1.7		2.5	0.8		EUH-3				0.8	20	2			52
53	-	-				1.7			1.7			2.5	0.8	-				0.8	-	-			54
55	20	2				1.0			1.0	1.3		0.4		EGRESS LIGHTS			0.3		20	1			56
57	-	-				1.0			1.0			1.7		CU-1/DSS-1				1.7	20	2			58
59	20	1			0.4				0.4			2.1	1.7					1.7	-	-			60
61	20	1			0.6				0.6	1.2		0.4		KITCHEN ISLAND CO			0.4		20	1			62
63	20	1							0.0		1.0	1.0		SMOKE DETECTORS				1.0	20	1			64
65	20	1							0.0			0.0	0.0	SPARE					20	1			66
67	20	1							0.0	0.0		0.0	0.0	SPARE					20	1			68
69	20	1							0.0		0.0	0.0	0.0	SPARE					20	1			70
71	20	1							0.0			0.0	0.0	SPARE					20	1			72
TOTALS:				CONNECTED KVA PER PHASE				27	27	26	CONNECTED TOTAL KVA				80								
				CONNECTED AMPS PER PHASE				223	226	220	CONNECTED AVERAGE AMPS PER PHASE				220								
NEC DIVERSIFIED LOAD CALCULATIONS																							
LIGHTING 3kVA @125% =				4 kVA				ALL OTHER LOADS @100% =				57 kVA				DIVERSIFIED TOTAL KVA = 76							
RECEPTACLES 10kVA @100% =				10 kVA				25% OF LARGEST MOTOR =				0 kVA				AVERAGE AMPS PER PHASE = 211							
REMAINDER 10kVA @50% =				5 kVA																			

Donald L. Welch  
Architect  
7533 Sandy Land Lane  
Midvale, Utah 84047  
801.548-6391  
dwelch5977@msn.com

THE DESIGNS SHOWN AND DESCRIBED HEREIN INCLUDING ALL TECHNICAL DRAWINGS, GRAPHIC REPRESENTATION & MODELS THEREOF, ARE PROPRIETARY & CAN NOT BE COPIED, DUPLICATED, OR COMMERCIALY EXPLOITED IN WHOLE OR IN PART WITHOUT THE SOLE AND EXPRESS WRITTEN PERMISSION FROM DONALD L. WELCH ARCHITECT

THESE DRAWINGS ARE AVAILABLE FOR LIMITED REVIEW AND EVALUATION BY CLIENTS, CONSULTANTS, CONTRACTORS, GOVERNMENT AGENCIES, VENDORS, AND OFFICE PERSONNEL ONLY IN ACCORDANCE WITH THIS NOTICE.

**consultant:**

## project:

**Tenant Finish  
for New  
Brighton  
Recovery  
Campus**  
4905, 4911, 4915, 4925,  
4931, & 4953 South 900  
East  
Salt Lake County, Utah

date

January 04, 2017

## revisions

PERMIT SET-December 28, 2016  
ADDENDUM #2-January 06, 2017  
ADDENDUM #3-January 11, 2017  
ADDENDUM #4-January 17, 2017  
ADDENDUM #5-January 19, 2017  
ADDENDUM #7-February 24, 2017  
ADDENDUM #8-March 20, 2017

data


project no:

checked by:

title
PANEL SCHEDULES

sheet

EP6 | 03

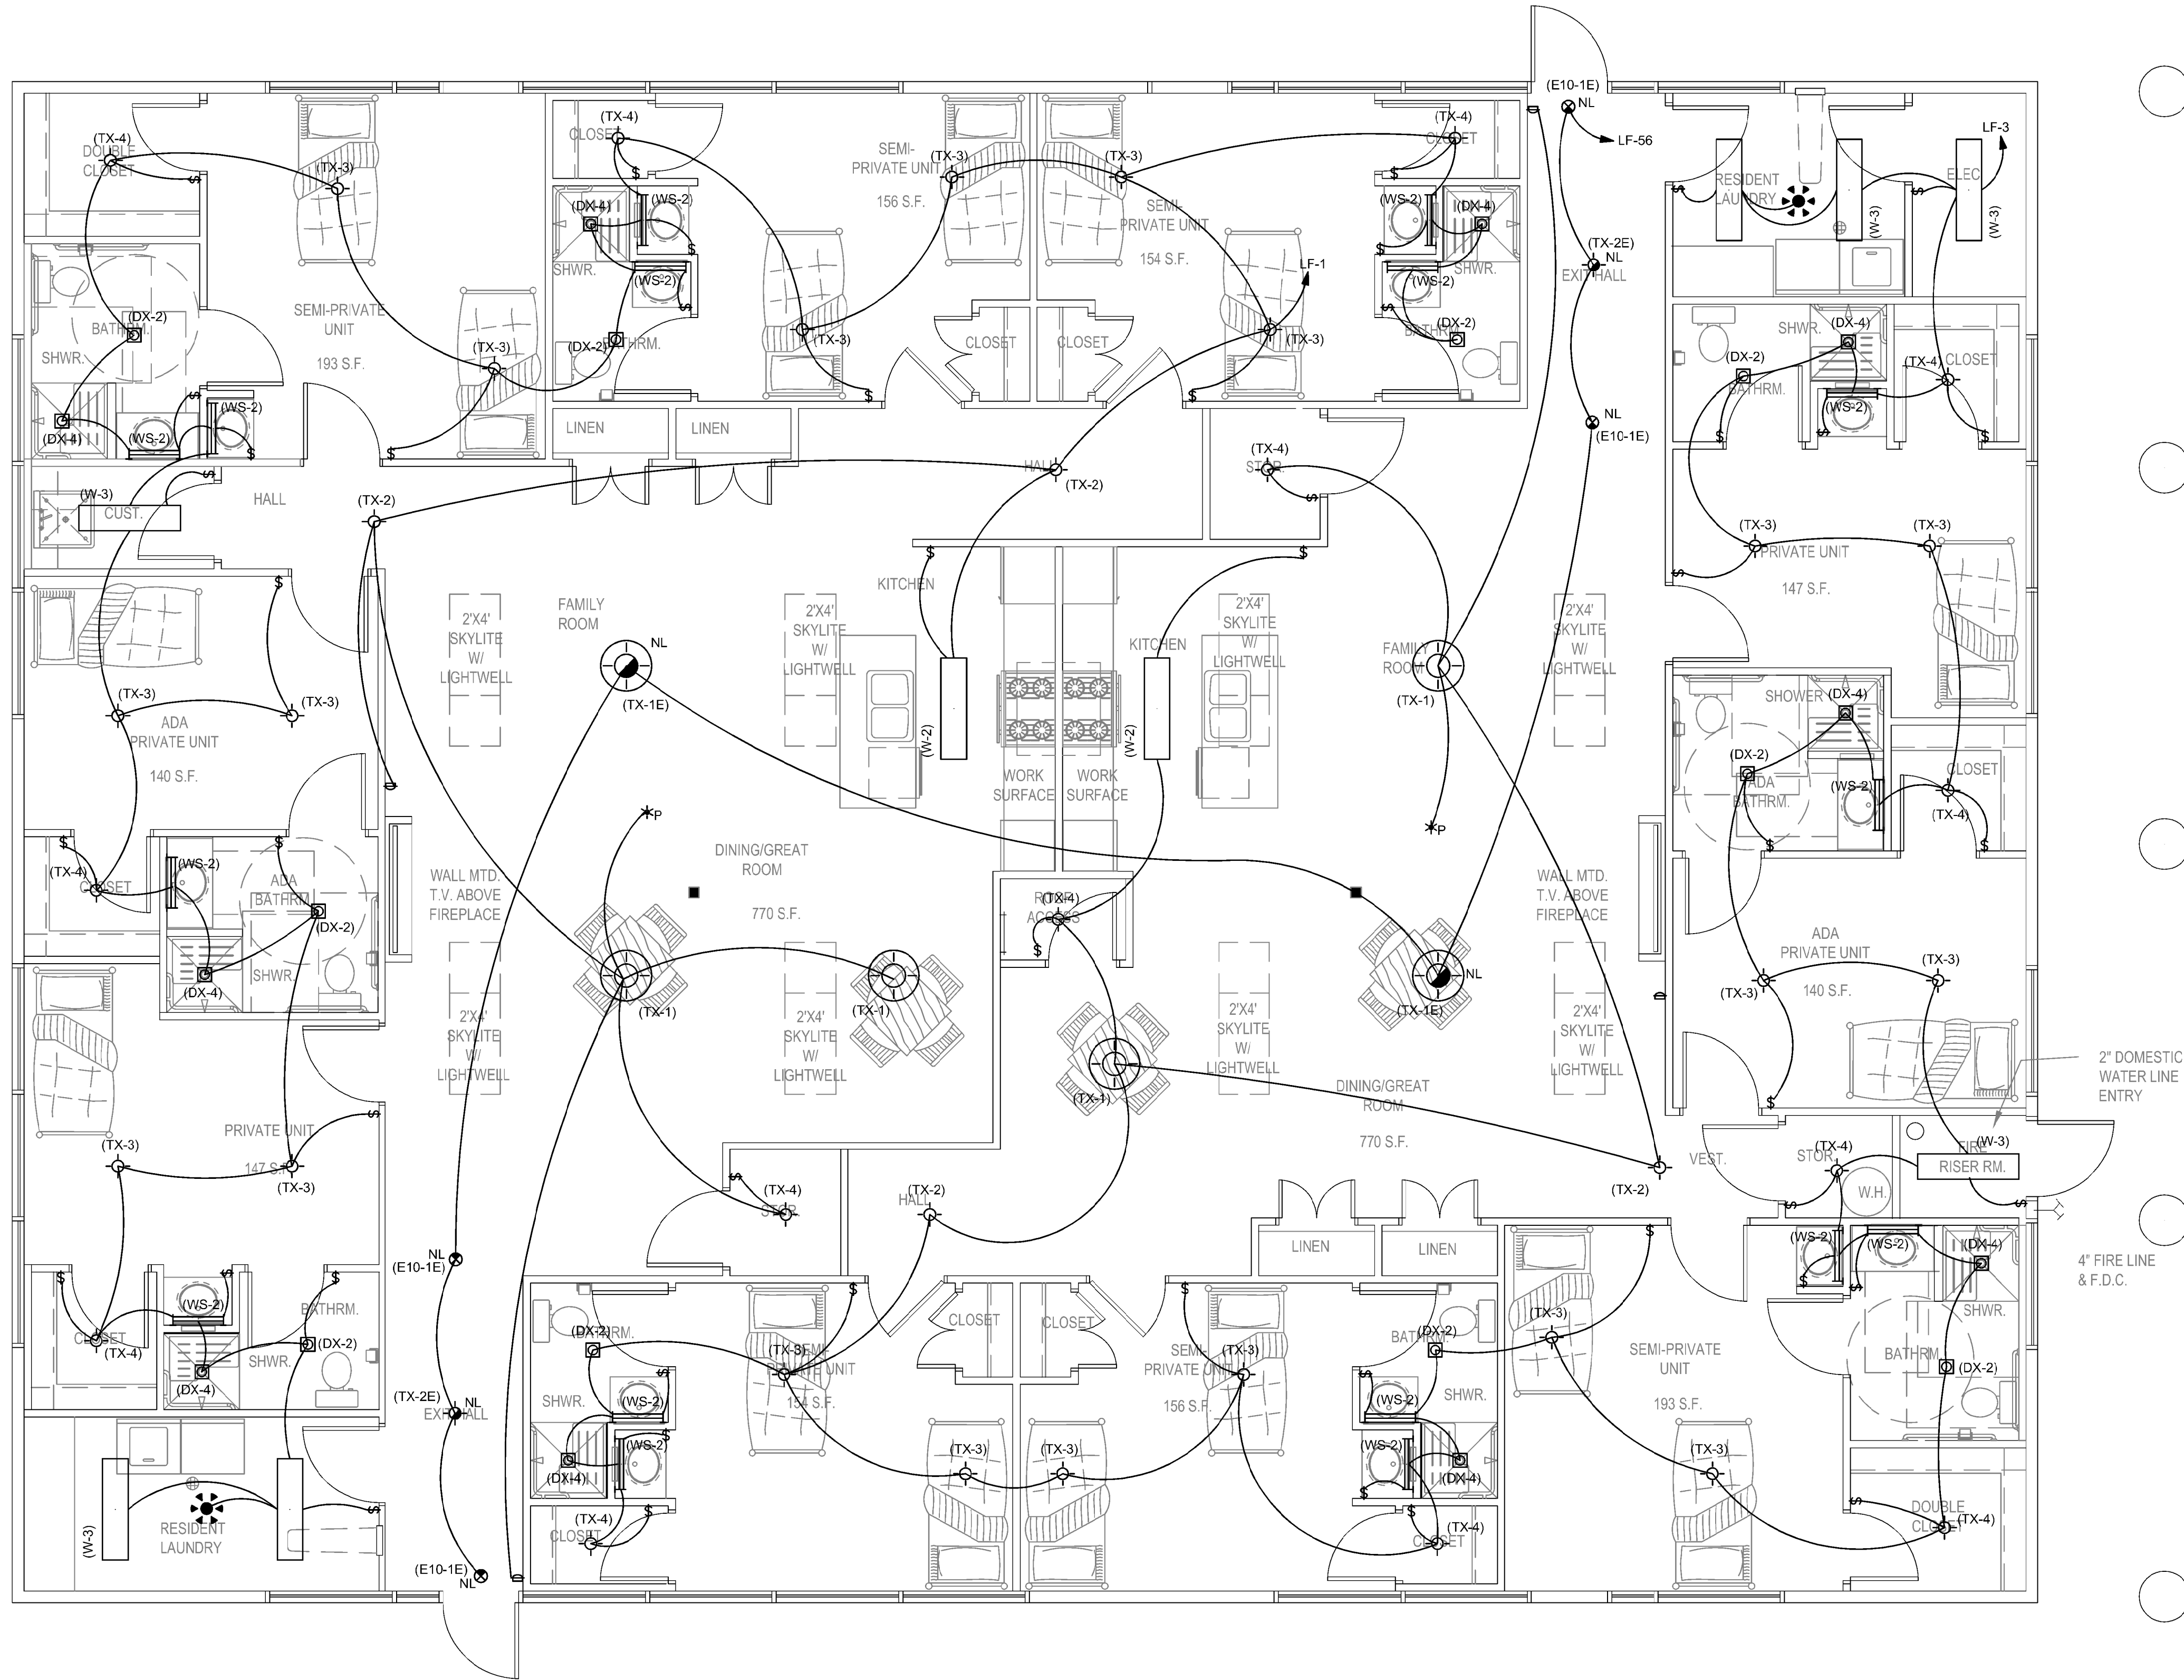

## GENERAL SHEET NOTES

1. PHOTOCELLS SHALL BE SET TO 30FC.

## SHEET KEYNOTES


- 1.

Donald L. Welch  
Architect  
7533 Sandy Land Lane  
Midvale, Utah 84047  
801.548-6391  
dweleh5977@msn.com

THE DESIGNS SHOWN AND DESCRIBED HEREIN INCLUDING ALL TECHNICAL DRAWINGS, GRAPHIC REPRESENTATION & MODELS THEREOF, ARE PROPRIETARY & CAN NOT BE COPIED, DUPLICATED, OR COMMERCIALY EXPLOITED IN WHOLE OR IN PART WITHOUT THE SOLE AND EXPRESS WRITTEN PERMISSION FROM DONALD L. WELCH ARCHITECT

THESE DRAWINGS ARE AVAILABLE FOR  
LIMITED REVIEW AND EVALUATION BY CLIENTS,  
CONSULTANTS, CONTRACTORS, GOVERNMENT  
AGENCIES, VENDORS, AND OFFICE PERSONNEL  
ONLY IN ACCORDANCE WITH THIS NOTICE.

**consultant:**

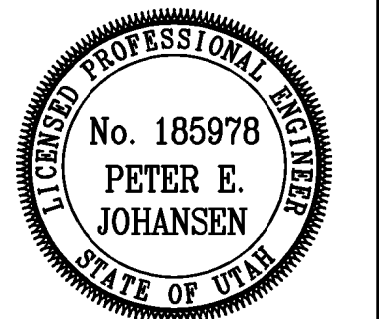

**project:**

**Tenant Finish  
for New  
Brighton  
Recovery  
Campus**  
4905, 4911, 4915, 4925,  
4931, & 4953 South 900  
East  
Salt Lake County, Utah

**date**

January 04, 2017

## revisions

- PERMIT SET-December 28, 2016  
ADDENDUM #2-January 06, 2017  
ADDENDUM #3-January 11, 2017  
ADDENDUM #4-January 17, 2017  
ADDENDUM #5-January 19, 2017  
ADDENDUM #7-February 24, 2017  
ADDENDUM #8-March 20, 2017

data

project no:

drawn by:

title	author	year	score
1984	George Orwell	1984	8.6
Animal Farm	George Orwell	1945	8.9
Brave New World	Aldous Huxley	1932	8.7
1984	George Orwell	1984	8.6
Animal Farm	George Orwell	1945	8.9
Brave New World	Aldous Huxley	1932	8.7

## FIGHTING PLAN - BUILDING 'F'

sheet

EL1 | 1F

## 1 LIGHTING PLAN - BUILDING 'F'

SCALE: 1/4"=1'-0"

LIGHTING FIXTURE SCHEDULE

NOTE TO BIDDERS: COMPLY WITH THE SPECIFICATIONS. REFER TO SPECIFICATIONS FOR IMPORTANT TECHNICAL REQUIREMENTS FOR LIGHTING FIXTURES, BALLASTS, AND LAMPS. THE CATALOG NUMBERS LISTED BELOW HAVE BEEN CAREFULLY PREPARED TO ASSIST BIDDERS IN SELECTING PRODUCTS TO ACHIEVE THE DESIGN CONCEPT, HOWEVER, PRIOR TO BIDDING, EACH MANUFACTURER SHALL COMPARE THE CATALOG NUMBERS SHOWN WITH THE DESCRIPTION AND REQUIREMENTS ON THE DRAWINGS, AND SHALL NOTIFY THE ARCHITECT/ENGINEER OF ANY DISCREPANCIES. SPECIFICALLY INCLUDED IN THIS EVALUATION SHALL BE THE VERIFYING OF PROPER MOUNTING KITS OR ACCESSORIES TO FACILITATE INSTALLATION AS SHOWN AT EACH LOCATION ON THE DRAWINGS. NO ALLOWANCE OR REDRESS WILL BE ALLOWED FOR DISCREPANCIES THAT WERE NOT REPORTED TO THE ARCHITECT/ENGINEER IN TIME FOR CORRECTION OR CLARIFICATION BEFORE THE BID. THE REPORTING OF ANY AMBIGUITY IS THE RESPONSIBILITY OF THE BIDDER. PROVIDE UNIT PRICES AND FIXTURE BRAND SELECTED FOR ADD/DELETE CHANGES FOR EACH FIXTURE TYPES SHOWN WITHIN 48 BUSINESS HOURS OF THE BID DATE. FAILURE TO COMPLY WITH THIS REQUIREMENT MAY DISQUALIFY THE PRODUCTS AND EMPOWER THE ENGINEER TO DETERMINE FAIR VALUE FOR FIXTURE AND INSTALLATION CHANGES, WITHOUT FURTHER INPUT FROM THE CONTRACTOR OR INSTALLER. SUBMITTAL PACKAGE SHALL INCLUDE LAMP MANUFACTURER AND CATALOG NUMBER ON EACH FIXTURE SHEET. ON ALL PENDANT MOUNTED FIXTURES, PROVIDE A SECOND SET OF PENDANTS, OF A DIFFERENT LENGTH, AS DIRECTED BY THE ARCHITECT/ENGINEER, PROVIDED AND INSTALLED AT NO ADDITIONAL CHARGE. ALL FIXTURES SHALL BE APPROVED BY UL OR ANOTHER ACCEPTABLE TESTING LAB FOR THE PURPOSE INTENDED AND WITH THE LAMP AND BALLAST PROPOSED. CONTRACTOR ALLOWANCE PRICES ARE ACCURATE WHEN THIS JOB WAS SPECIFIED. CONTRACTOR AND ELECTRICAL DISTRIBUTOR SHALL VERIFY THIS ALLOWANCE AND REPORT ANY PROBLEMS TO THE ENGINEER BEFORE THE BID. ALLOWANCE PRICE MAY OR MAY NOT INCLUDE LAMP(S) OR FREIGHT AS NOTED, AND DO NOT INCLUDE ANY TAXES. UNIVERSAL VOLTAGE (120/277) BALLASTS REQUIRED UNLESS NOTED OTHERWISE. DIMENSION SEQUENCE = (LENGTH X WIDTH X DEPTH) IN INCHES.								
SYMBOL	MARK	FIXTURE CHARACTERISTICS BODY / AIR / MOUNTING / DOOR LENS/LOUVER/REFLECTOR/OTHER	LAMP	WATTS	VOLTS	MANUFACTURER	CATALOG NUMBER	NOTES
DX		LED DOWNLIGHT, THERMALLY PROTECTED HOUSING; TO ACCOMMODATE MULTIPLE TRIMS AND REFLECTOR ASSEMBLIES FOR LAMPS AS LISTED BELOW; ELECTRONIC BALLASTS; LOW IRIDESCENT REFLECTOR FINISH (EVEN IF NOT SHOWN IN CATALOG #); SELF FLANGING TRIM UNLESS NOTED.						
DX-1		RECESSED DOWNLIGHT; VERTICAL, FULL ON AT 0 VOLTS CONTROL INPUT 6" 3500 K DIMMABLE 0-10V	1500 LU 3500k	27W	120/277V	PEACHTREE	6BLRD-IC-18-35K-80-SH-TRW-120 OR EQUIVALENT	
DX-2		RECESSED DOWNLIGHT; VERTICAL, FULL ON AT 0 VOLTS CONTROL INPUT 6" 3500K, 90 CRI 2000 LUMENS DIMMABLE 0-10V DAMP LOCATION	2000 LI 3500k	54W	120/277V	PEACHTREE	6BLRD-IC-20-35K-80-SH-RCA-120 OR EQUIVALENT	
DX-4		RECESSED DOWNLIGHT; LED 6" SHOWER LIGHT 4000k	1250 L 3500k	27W	120/277V	PEACHTREE EATON	6BLRD-IC-13-35K-80-SH-RCA-WL-120 SLD612-80-35-WH WITH H7/CAT HOUSING OR EQUIVALENT	
E		E SUFFIX INDICATES THAT FIXTURE IS PROVIDED WITH AN EMERGENCY BATTERY PACK TO PROVIDE POWER LED LAMPS, TO PROVIDE 90 MINUTES OF EMERGENCY POWER TO FIXTURE. MINIMUM LIGHT OUTPUT FOR TYPICAL 4' LAMP SHALL BE 1100 LUMENS OR HIGHER;UNIVERSAL TRANSFORMER FOR 120 OR 277 VOLTS; LOW VOLTAGE PROTECTION, COMBINATION TEST SWITCH AND AC "ON" INDICATOR; 10 YEAR PRO-RATA WARRANTY; INSTALL TEST SWITCH IN A MANNER THAT REQUIRES NO DISASSEMBLY FOR TESTING.						
E		EMERGENCY BATTERY PACK. self testing ballasts		3W	120/277V	DUAL-LITE BODINE LITHONIA EMERGI LITE EVENLINT	UFO 6WI REDITEST PS1400QD SD FPDLU BAL1400	
E10		EXIT SIGN: METAL HOUSING; CEILING MOUNT. SEE DRAWINGS; ARROWS PER PLANS; LED LAMPS; EDGE LIGHTED CLEAR LENS; GREEN LETTERS ON CLEAR BACKGROUND. MUST MEET NFPA ILLUMINATION STANDARDS. UNITS SHOWN ARE CEILING MOUNT MODELS. CONTRACTOR TO PROVIDE MATCHING LOW LEVEL WALL MOUNTED UNITS WHERE REQUIRED.						
E10-1E		SINGLE FACE: WITH EMERGENCY BATTERY PACK	LED	2W	120/277V	DUAL-LITE MCPHILBEN EELP LITHONIA EVENLITE ISOLITE CHLORIDE LIGHTOLIER	LECSGWA 45VL-1-GC-XX EDG 1 GC W EM LRP W 1 GC XX 120/277 SOV-AC-G-1M WH XX UC EDGL-S-S-G-BK (BLACK HOUSING) STDLX-X-1-GC-X LEAC1GCX	
E10-2E		DUAL FACE: WITH EMERGENCY BATTERY PACK	LED	2W	120/277V	DUAL-LITE MCPHILBEN EELP LITHONIA EVENLITE ISOLITE CHLORIDE LIGHTOLIER	LECDGWA 45VL-2-GM-XX EDG 2 GC W EM LRP W 2 GMR XX 120/277 SOV AC G 2M WH XX UC EDGL-D-S-G-BK (BLACK HOUSING) STDLX-X-2-GC-X LEAC2GC7	
HG		EXTERIOR CANOPY FIXTURES						
HG-1		RECESSED SQUARE LED CANOPY LIGHT, BRONZE FINISH, WIDE DISTRIBUTION	LED 3000K	50W 3800 LU	120/277V	MCGRAW EDISON	LRC-B16-1-LED-E1-WST	
OC		WALL MOUNTED TRAPEZOIDAL WALL PACK, WET LOCATION						
OC-32		LED WALL PACK, TYPE IV OPTICS BRONZE FINISH	LED 3500K	24W 1600 LU	120/277V	LITHONIA	WST-LED-1-10A700-35K-SR4-MVOLT	
TX		SPECIAL FIXTURES AS INDICATED. MEET ALL REQUIREMENTS OF SPECIFICATIONS AND FIXTURE SCHEDULE. VISUAL AND FINISH APPROVAL REQUIRED.						
TX-1		Surface Mounted Drum 36" Diameter	LED 3500K	100W	120/277V	SHAPER SPI	122-36-L7-UNV-SN AIC11866-L100.4W/DML-PT04-120-277V-3500K-FB01	
TX-2		Surface Mounted Drum 24" Diameter	LED 3500K	37W	120/277V	SHAPER SPI	122-24-L5-UNV-SN AIC11865-L46.6W/DML-PT04-120-277V-3500K-FB01	
TX-3		Surface Mounted Bedroom Light	LED 3500K	24W	120/277V	BETACALCO	FIERO-60 1200-3500K-PC-SN	
TX-4		Surface Mounted Closet Light	LED 3000K	22W	120/277v	METALUX	FM-15-W-R-30-R	
TX-5		PENDANT	LED 3500K	21W	120/277V	SPI	SIP11783-2F21-120-F-AC1	

W	LOW PROFILE WRAPAROUND: SURFACE MOUNTED SUITABLE FOR MOUNTING ON LOW DENSITY CEILINGS WRAPAROUND ACRYLIC PRISMATIC DIFFUSER; WHITE ENAMEL ENDPLATES; MINIMUM CU OF 70 @ 80/50/20 AND RCR=1;					
W-2	NARROW BODY WRAPAROUND; APPROX; 3' X 12" X 48" X 48"; 5500 LUMENS	LED 3500K	57W	277/120V	EATON	DSI-WD-3-L35-1-D-UNV-SU-JB-4-STD-FC-W
W-3	NARROW BODY WRAPAROUND; APPROX; 3' X 10" X 48" X 48"; 4800 LUMENS	LED 3500K	48W	277/120V	LITHONIA COLUMBIA METALUX DAYBRITE	LBL4 LP840 LWC4 40 ML EU WNLED LD1 41 ' UNV L835 CD1 U OWL450L835UNV
WS	WALL MOUNTED LED LOCATED ABOVE WALL ELEMENT (MIRROR/WHITEBOARD, ETC.); AS INDICATED ON DRAWINGS;					
WS-2	36" LED VANITY LIGHT SATIN CHROM FINISH 2.25" WIDE	LED 3500K	19W	120/277V	EDGE LIGHT EUREKA LBL	TW12 S11 1RE 36" 30K CH 3541 35 LED 17.40 120/277 SC WH LW496 OP XX LED 277
ZX	OUTDOOR AREA LIGHT. SINGLE HEAD PER POLE AS SHOWN ON DRAWINGS. WET LABEL. LED LIGHT ENGINE, OPTICS AND DRIVERS ACCESSIBLE FROM BELOW; RATED 100 MPH WITH 1.3 GUST FACTOR					
ZX-2	LED POLE MOUNTED AREA LIGHT, TYPE II OPTICS, BRONZE FINISH HOUSE SIDE SHIELD 9' SSS POLE, FINISH TO MATCH FIXTURE	LED 3500K	72W 3500 LU	120/277V	LITHONIA	DSX0-LED-20C-1000-35K-T2M-MVOLT-HS
ZX-4	LED POLE MOUNTED AREA LIGHT, TYPE IV OPTICS, BRONZE FINISH HOUSE SIDE SHIELD 9' SSS POLE, FINISH TO MATCH FIXTURE	LED 3500K	72W 3500 LU	120/277V	LITHONIA	DSX0-LED-20C-1000-35K-T4M-MVOLT-HS




Donald L. Welch  
Architect  
7533 Sandy Land Lane  
Midvale, Utah 84047  
801.346-6391  
dwelch5977@msn.com

THE DESIGNS SHOWN AND DESCRIBED HEREIN INCLUDING ALL TECHNICAL DRAWINGS, GRAPHIC REPRESENTATION & MODELS THEREOF, ARE PROPRIETARY & CAN NOT BE COPIED, DUPLICATED, OR COMMERCIALY EXPLOITED IN WHOLE OR IN PART WITHOUT THE SOLE AND EXPRESS WRITTEN PERMISSION FROM DONALD L. WELCH ARCHITECT

THESE DRAWINGS ARE AVAILABLE FOR LIMITED REVIEW AND EVALUATION BY CLIENTS CONSULTANTS, CONTRACTORS, GOVERNMENT AGENCIES, VENDORS, AND OFFICE PERSONNEL ONLY IN ACCORDANCE WITH THIS NOTICE.

consultant:

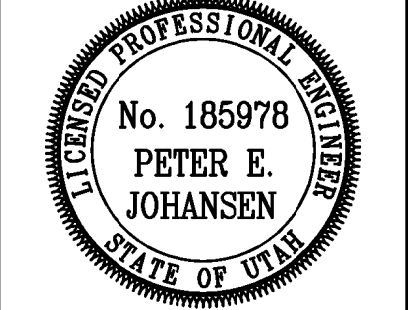

project:

Tenant Finish  
for New  
Brighton  
Recovery  
Campus  
4905, 4911, 4915, 4925,  
4931, & 4953 South 900  
East  
Salt Lake County, Utah

date

January 04, 2017

revisions

- PERMIT SET--December 28, 2016
- ADDENDUM #2--January 06, 2017
- ADDENDUM #3--January 11, 2017
- ADDENDUM #4--January 17, 2017
- ADDENDUM #5--January 19, 2017
- ADDENDUM #7--February 24, 2017
- ADDENDUM #8--March 20, 2017

data

project no:

drawn by:

checked by:

title

LIGHTING  
FIXTURE  
SCHEDULE  
sheet

EL601


BUILDING 'F' 4953 South 900 East PARCEL #22081850130000



File Name: P:\2016\20160686\Drawings\3Sheet\Building\_F\86EY11F.dwg Last Plotted: 2017/03/21 @ 8:59 AM By: jrw

1 AUXILIARY PLAN - BUILDING 'F'

SCALE: 1/4"=1'-0"

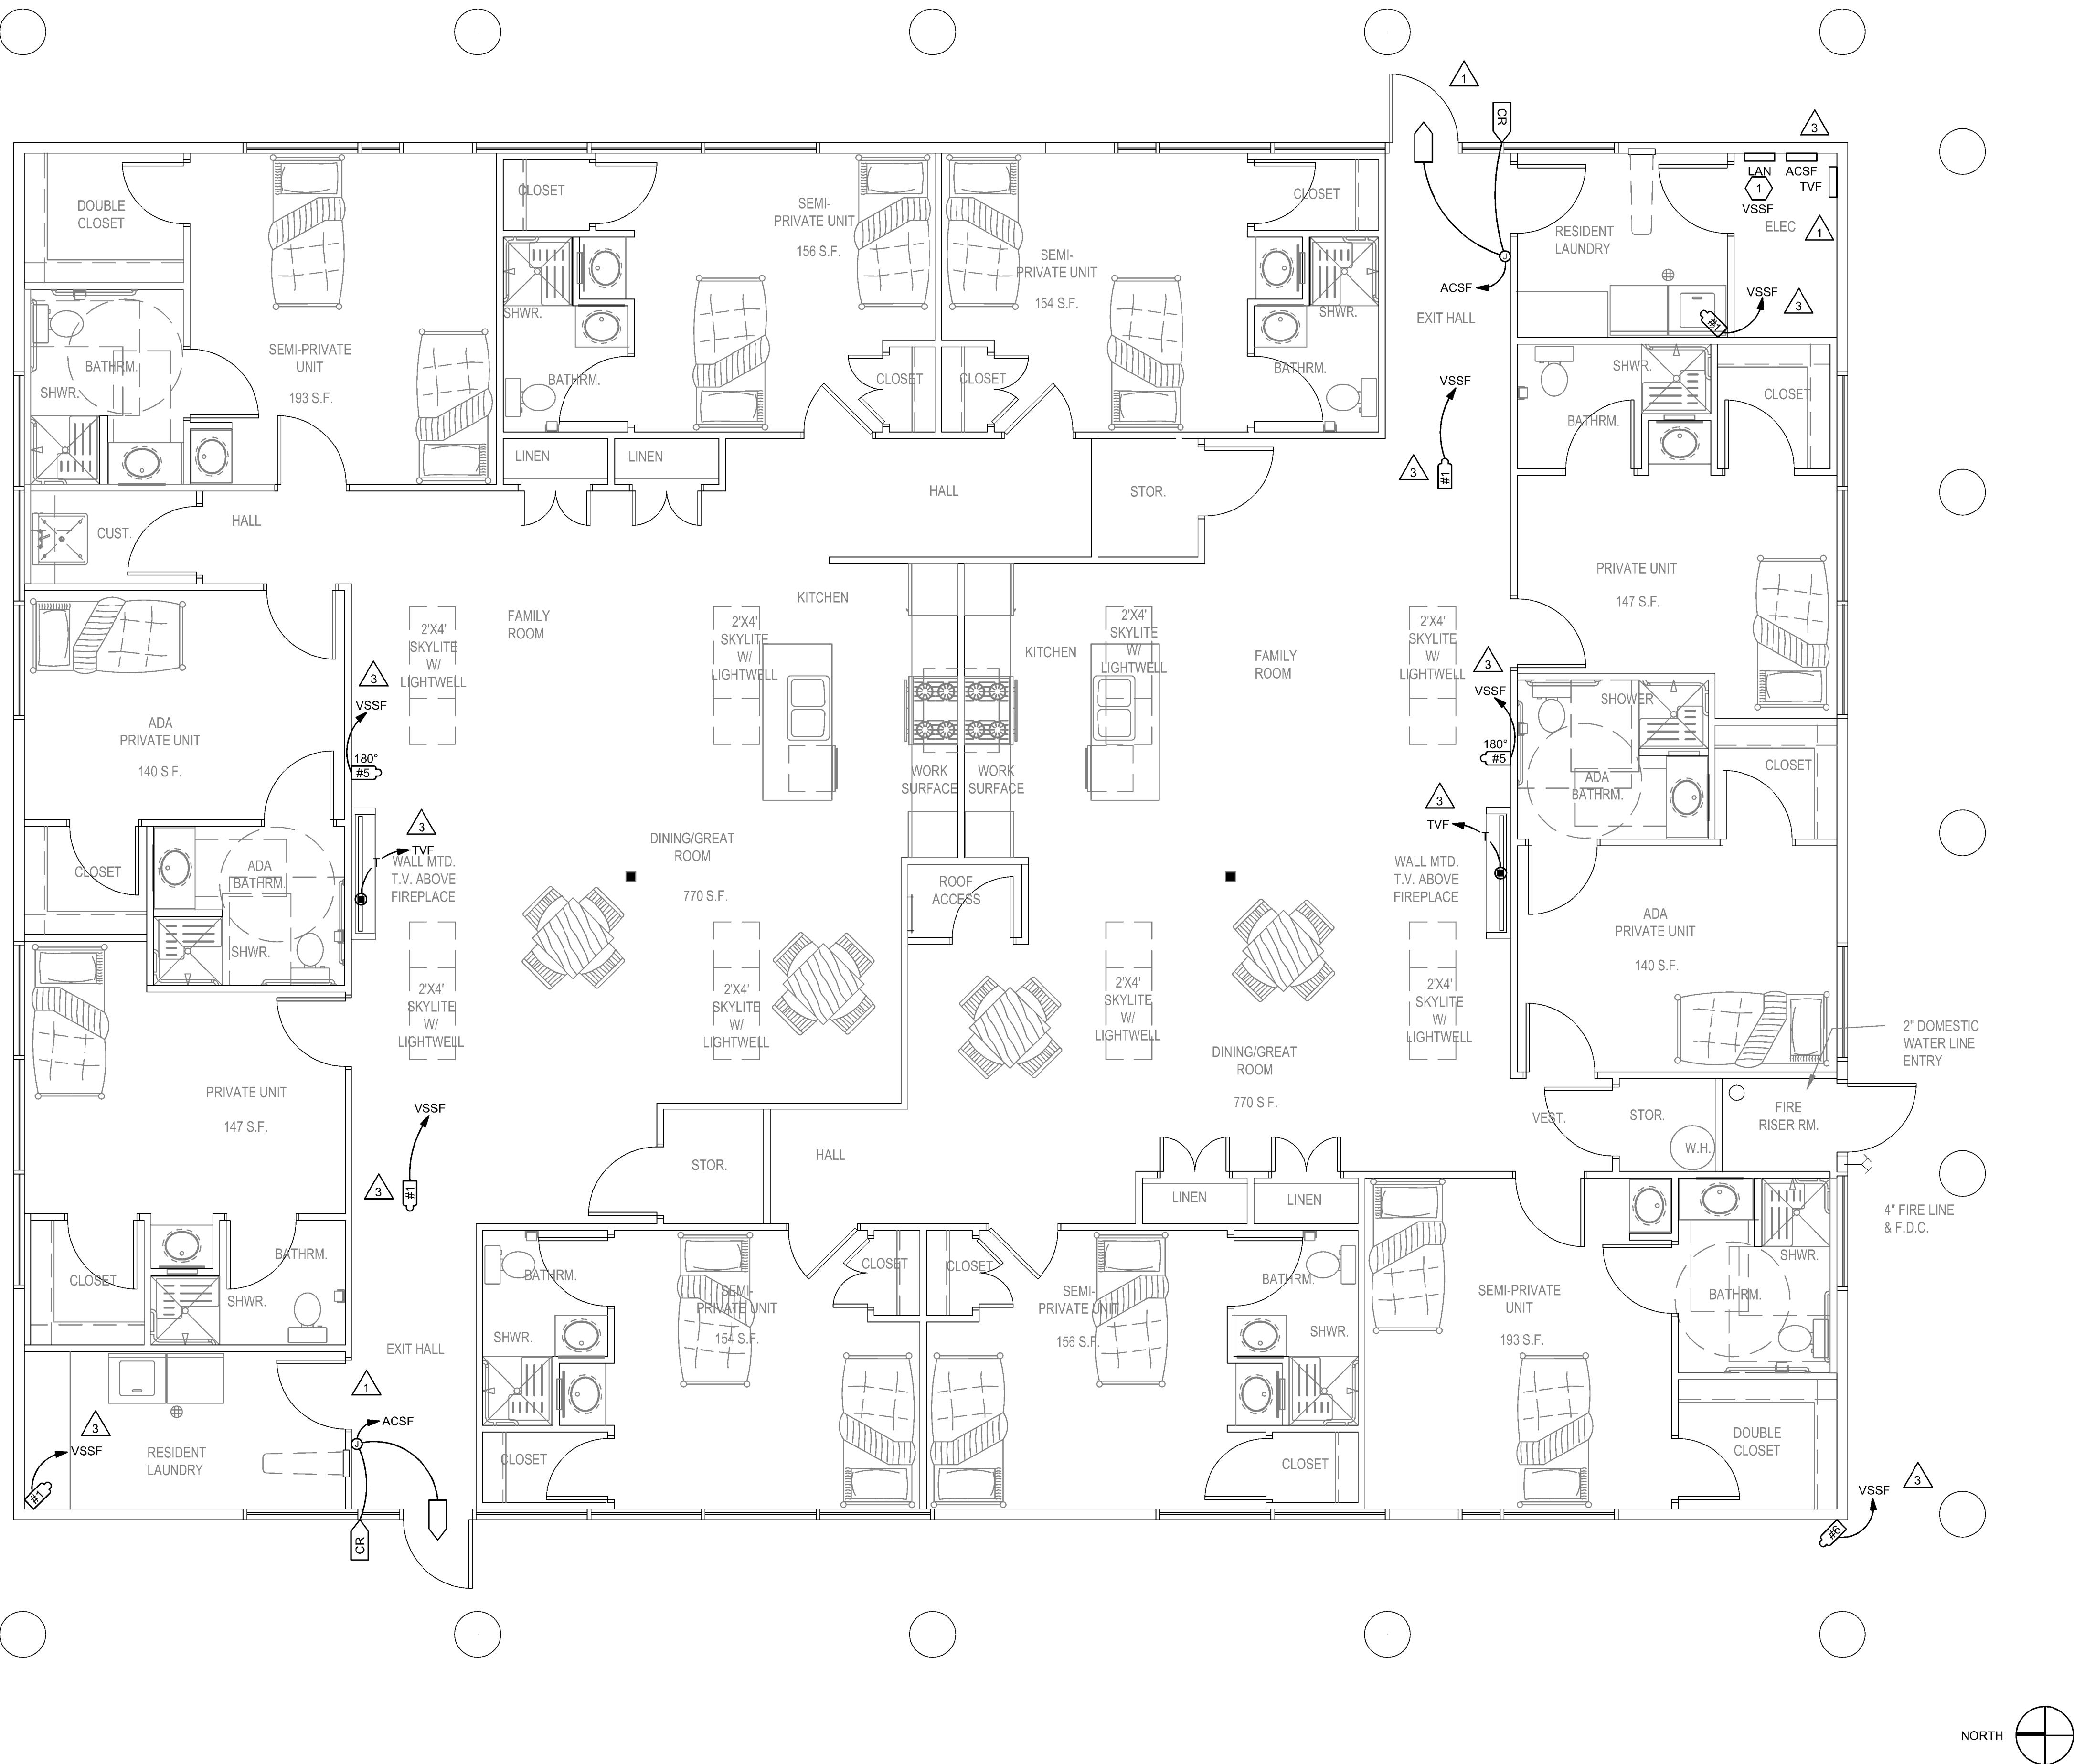

GENERAL SHEET NOTES

1.

SHEET KEYNOTES


1. ALL VIDEO SURVEILLANCE CAMERA CABLING SHALL BE PULLED BACK AND TERMINATED ON A CAT 6 COMPLIANT PATCH PANEL.

Donald L. Welch  
Architect  
7533 Sandy Land Lane  
Midvale, Utah 84047  
801.346-6391  
dwelch5977@msn.com

THE DESIGNS SHOWN AND DESCRIBED HEREIN INCLUDING ALL TECHNICAL DRAWINGS, GRAPHIC REPRESENTATION & MODELS THEREOF, ARE PROPRIETARY & CAN NOT BE COPIED, DUPLICATED, OR COMMERCIALY EXPLOITED IN WHOLE OR IN PART WITHOUT THE SOLE AND EXPRESS WRITTEN PERMISSION FROM DONALD L. WELCH ARCHITECT

THESE DRAWINGS ARE AVAILABLE FOR LIMITED REVIEW AND EVALUATION BY CLIENTS CONSULTANTS, CONTRACTORS, GOVERNMENT AGENCIES, VENDORS, AND OFFICE PERSONNEL ONLY IN ACCORDANCE WITH THIS NOTICE.

consultant:

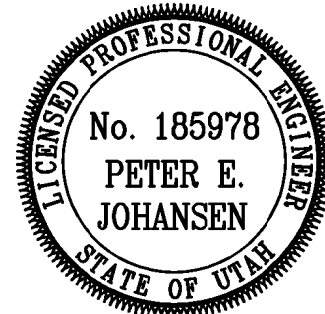

project:

**Tenant Finish  
for New  
Brighton  
Recovery  
Campus**  
4905, 4911, 4915, 4925,  
4931, & 4953 South 900  
East  
Salt Lake County, Utah

date

January 04, 2017

revisions

- PERMIT SET-December 28, 2016  
ADDENDUM #2-January 06, 2017  
ADDENDUM #3-January 11, 2017  
ADDENDUM #4-January 17, 2017  
ADDENDUM #5-January 19, 2017  
ADDENDUM #7-February 24, 2017  
ADDENDUM #8-March 20, 2017

data

project no:

drawn by:

checked by:


title

AUXILIARY PLAN -  
BUILDING 'F'

sheet

EY11F


File Name: P:\2016\20160686\Drawings\3Sheet\Building F\86'EY601F.dwg Last Plotted: 2017/03/21 @ 8:58 AM By: jrw

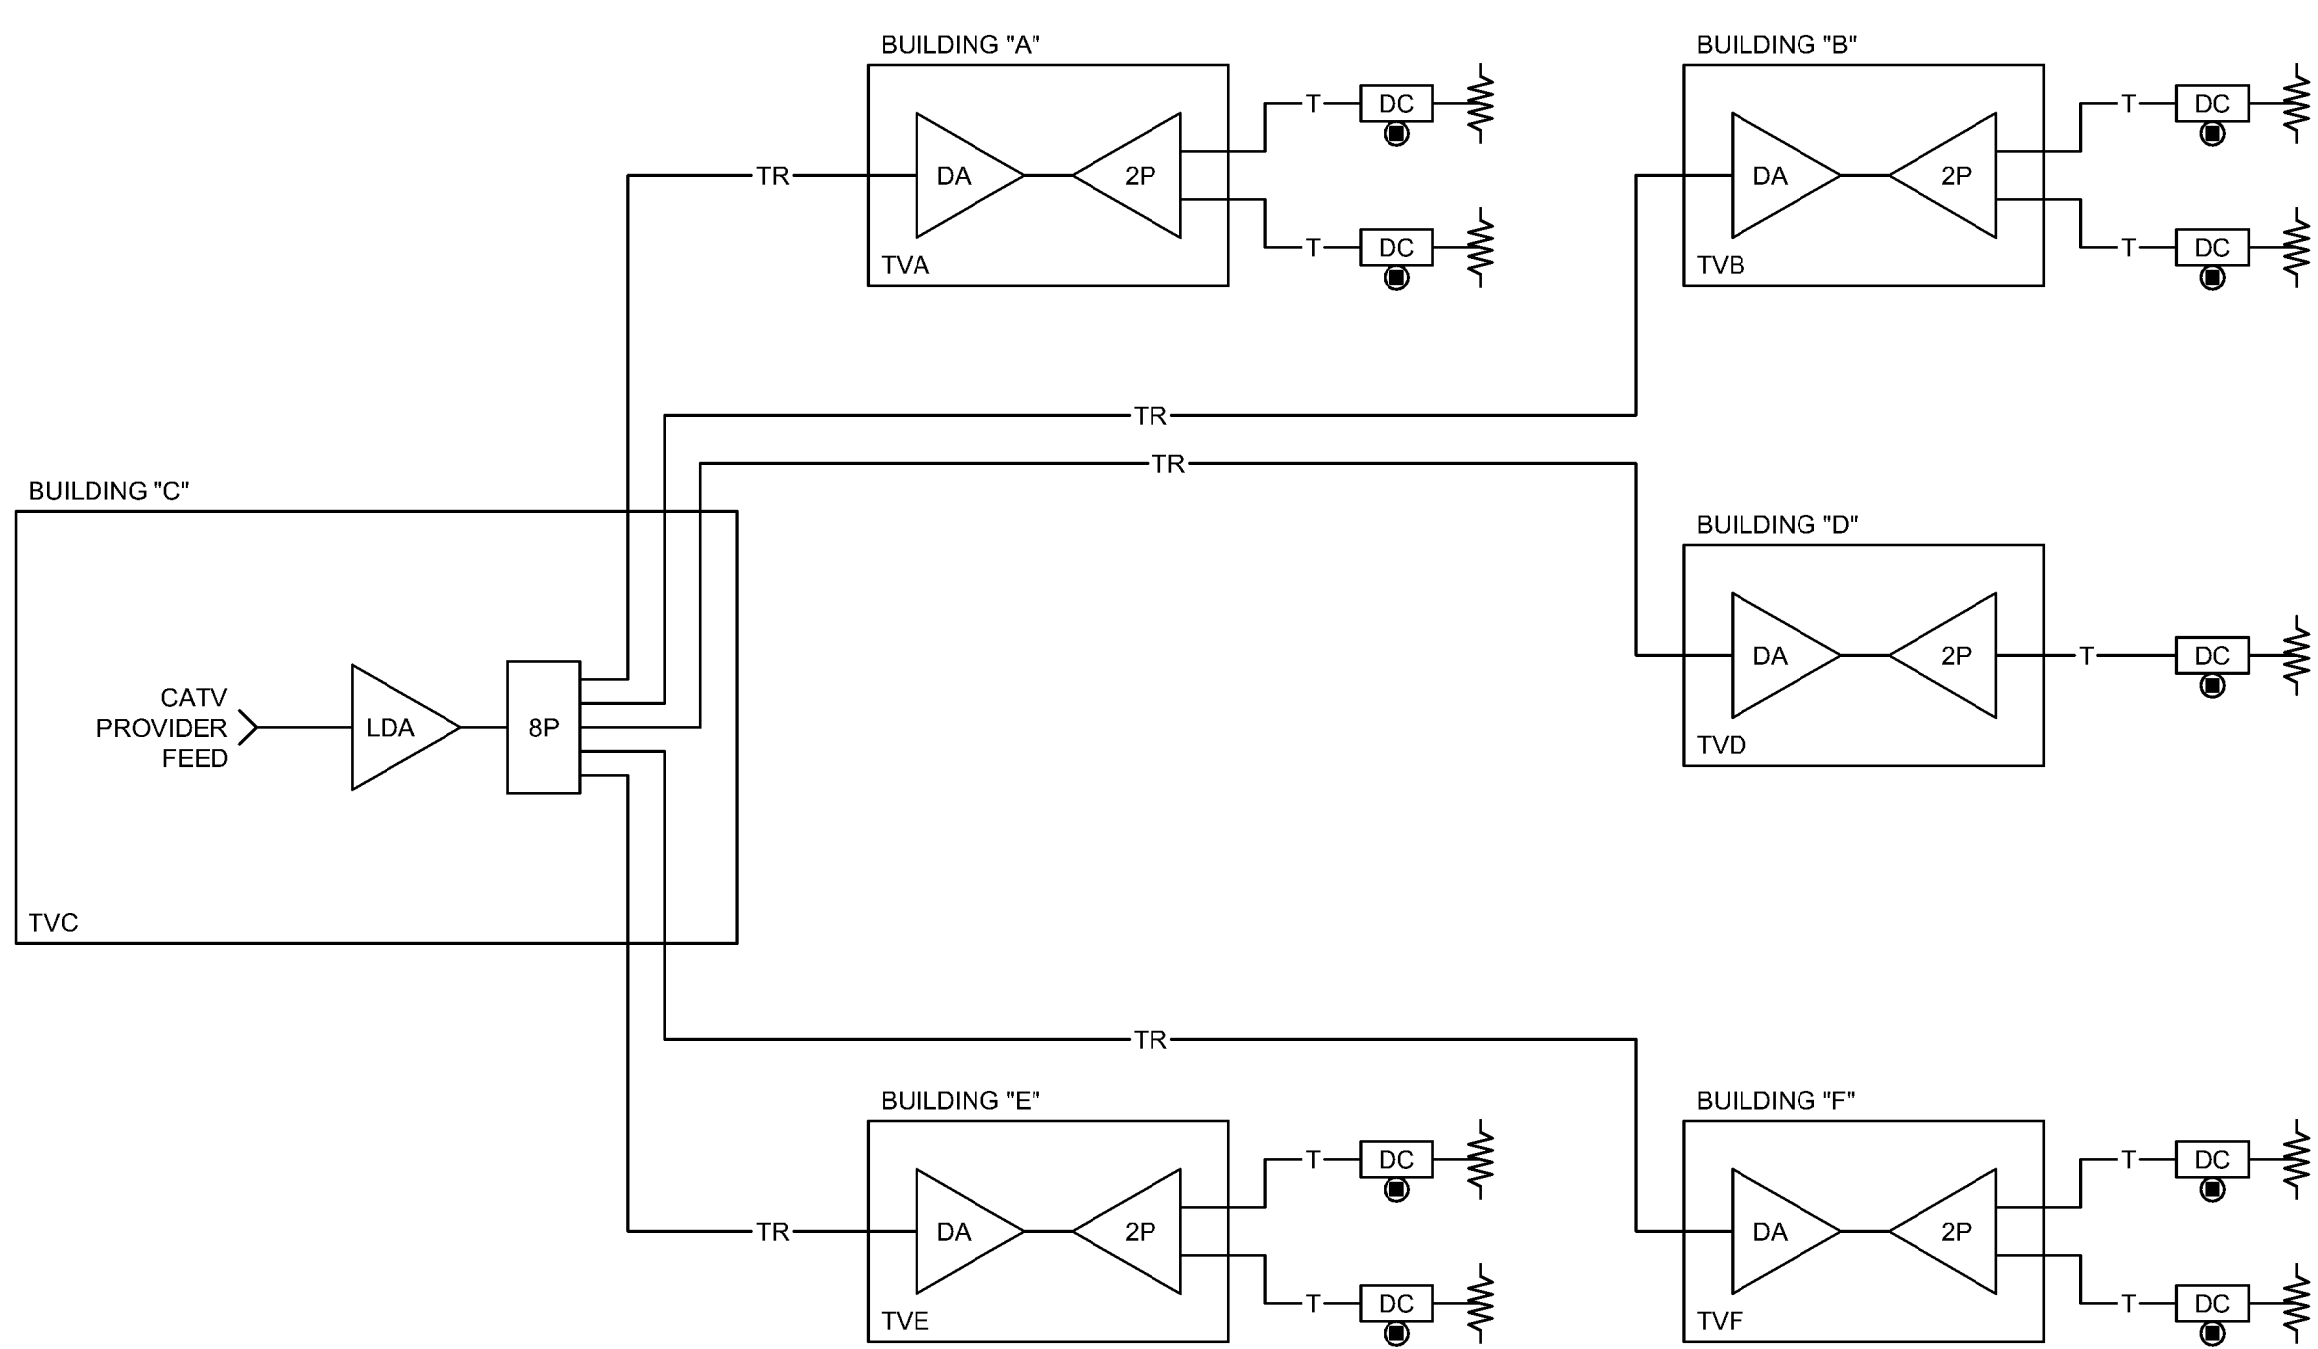

3 TV DISTRIBUTION SYSTEM DIAGRAM  
NO SCALE

### STRUCTURED CABLING SYSTEM NOTES

- REFER TO EP SERIES SHEETS FOR VOICE/DATA OUTLET QUANTITIES AND LOCATIONS.
- PROVIDE PLENUM RATED CABLE IN ALL AIR PLENUMS. IF A PLENUM RATED CABLE IS NOT SPECIFIED, PROVIDE THE PLENUM RATED EQUIVALENT TO THE SPECIFIED CABLE.
- ALL CABLE, REGARDLESS OF LENGTH, INSTALLED UNDER THIS CONTRACT ARE TO BE LABELED.
- UNLESS OTHERWISE NOTED, INSTALL ALL CABLE INSIDE RACEWAY SYSTEMS. WHERE RACEWAY SYSTEMS HAVE NOT BEEN PROVIDED OR SPECIFIED, INSTALL CABLE THROUGH THE SPECIFIED "CADDIE" CLIPS INSTALLED ABOVE ACCESSIBLE CEILINGS AT THE MINIMUM INTERVALS IDENTIFIED IN THE SPECIFICATIONS. SUPPORT "CADDIE" CLIPS DIRECTLY FROM THE BUILDING STRUCTURE, NOT FROM OTHER BUILDING SYSTEM SUPPORT WIRES OR CABLE.
- GROUND ALL EQUIPMENT AS DETAILED. COORDINATE GROUNDING WITH ELECTRICAL CONTRACTOR.
- ALL CABLE, FIBER, AND UTP TO BE TERMINATED ON BOTH ENDS.
- ALL VOICE/DATA SYSTEMS CABLE IS TO BE INSTALLED INSIDE MINIMUM 1" CONDUIT. STUB CONDUIT FROM JUNCTION BOX LOCATION TO CABLE MANAGEMENT SYSTEM SPECIFIED FOR ACCESSIBLE CEILING.
- INSTALL ALL ELECTRONIC SYSTEMS EQUIPMENT IN COMPLIANCE WITH THE MANUFACTURER'S WRITTEN INSTRUCTIONS, SEISMIC CODES, AND INDUSTRY WIDE ACCEPTED PRACTICES. SUPPORT EQUIPMENT WEIGHT FROM BUILDING STRUCTURE. DURING THE SUBMITTAL PROCESS, PROVIDE SHOP DRAWINGS WHICH DETAIL PROPOSED MOUNTING FOR ALL SUCH EQUIPMENT.

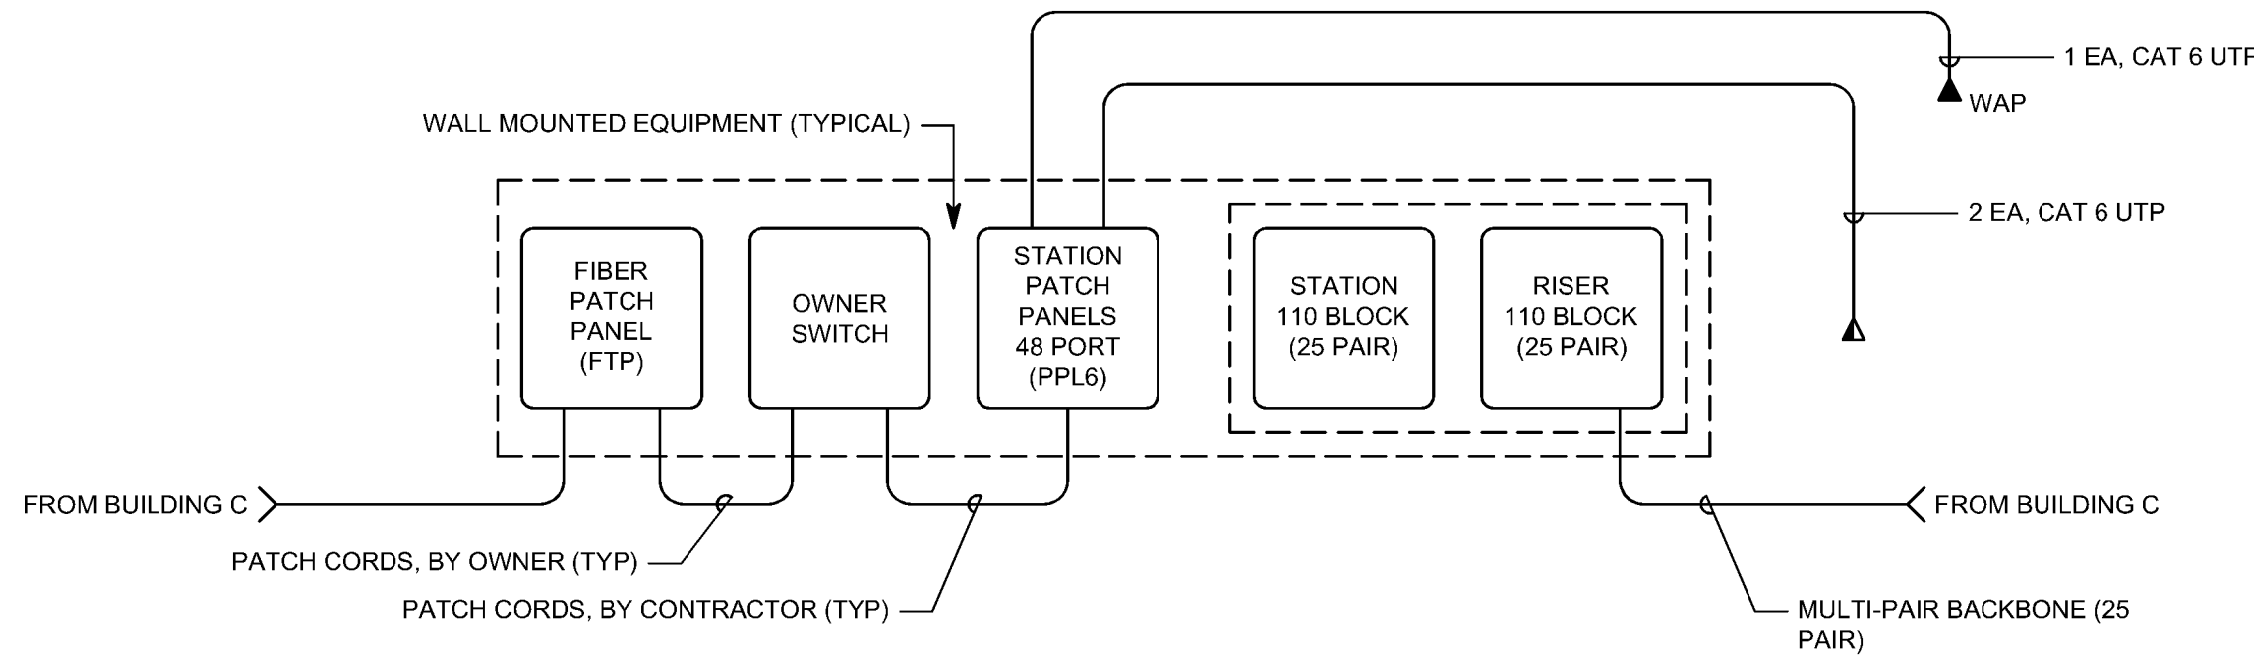

2 HORIZONTAL WALL MOUNT DIAGRAM (TYP. FOR BUILDINGS A, B, D, E, & F)  
NO SCALE


### TV DISTRIBUTION EQUIPMENT LIST

SYMBOL	DESCRIPTION	QTY	ACCEPTABLE TYPES
#P	MULTI-PORT SPLITTER	OFF	2-PORT BLONDER TONGUE SXRS-2 4-PORT BLONDER TONGUE SXRS-4
LDA	BROADBAND AMPLIFIER (LAUNCH)	OFF	BLONDER TONGUE RMDA 750-30
DA	BROADBAND AMPLIFIER	OFF	BLONDER TONGUE ZCM-201
DC	DIRECTIONAL COUPLER/WALL TAP PLATE	OFF	BLONDER TONGUE VERSATAP SERIES MODEL V-3889 SERIES
75	RF TERMINATOR	A/R	75 OHM TERMINATOR
T	COAXIAL CABLE, HORIZONTAL DROP	A/R	RG-6 (SEE SPECIFICATIONS)
TR	COAXIAL CABLE, TRUNK	A/R	RG-11 (SEE SPECIFICATIONS)

### SECURITY EQUIPMENT SCHEDULE

SYMBOL	DESCRIPTION	MOUNTING *	ROUGH-IN	QTY	ACCEPTABLE TYPES
CR	CARD READER	40"	4SQ W/ 1G RING	OFF	SEE SECTION 281300
#1	CARD ACCESS DOOR TYPE, TYPICAL. REFER TO CARD ACCESS DOOR TYPE SCHEDULE.	SEE SCHEDULE	SEE SCHEDULE	OFF	REFER TO CARD ACCESS DOOR TYPE SCHEDULE & SECTION 281300
VSS	VSS CAMERA/ENCLOSURE TYPE, TYPICAL. REFER TO VSS CAMERA/ENCLOSURE TYPE SCHEDULE.	SEE SCHEDULE	SEE SCHEDULE	OFF	SEE VSS CAMERA/ENCLOSURE TYPE SCHEDULE
ACS	CARD ACCESS CONTROLLERS & PWR SUPPLIES	72"	4"x4" GUTTER & STUBS A/R	A/R	SEE SECTION 281300
VSS	VIDEO SURVEILLANCE SYSTEM	RACK MOUNTED			COORDINATE WITH OWNER

\* COORDINATE MOUNTING HEIGHTS WITH ARCHITECTURAL ELEVATIONS BEFORE INSTALLATION.

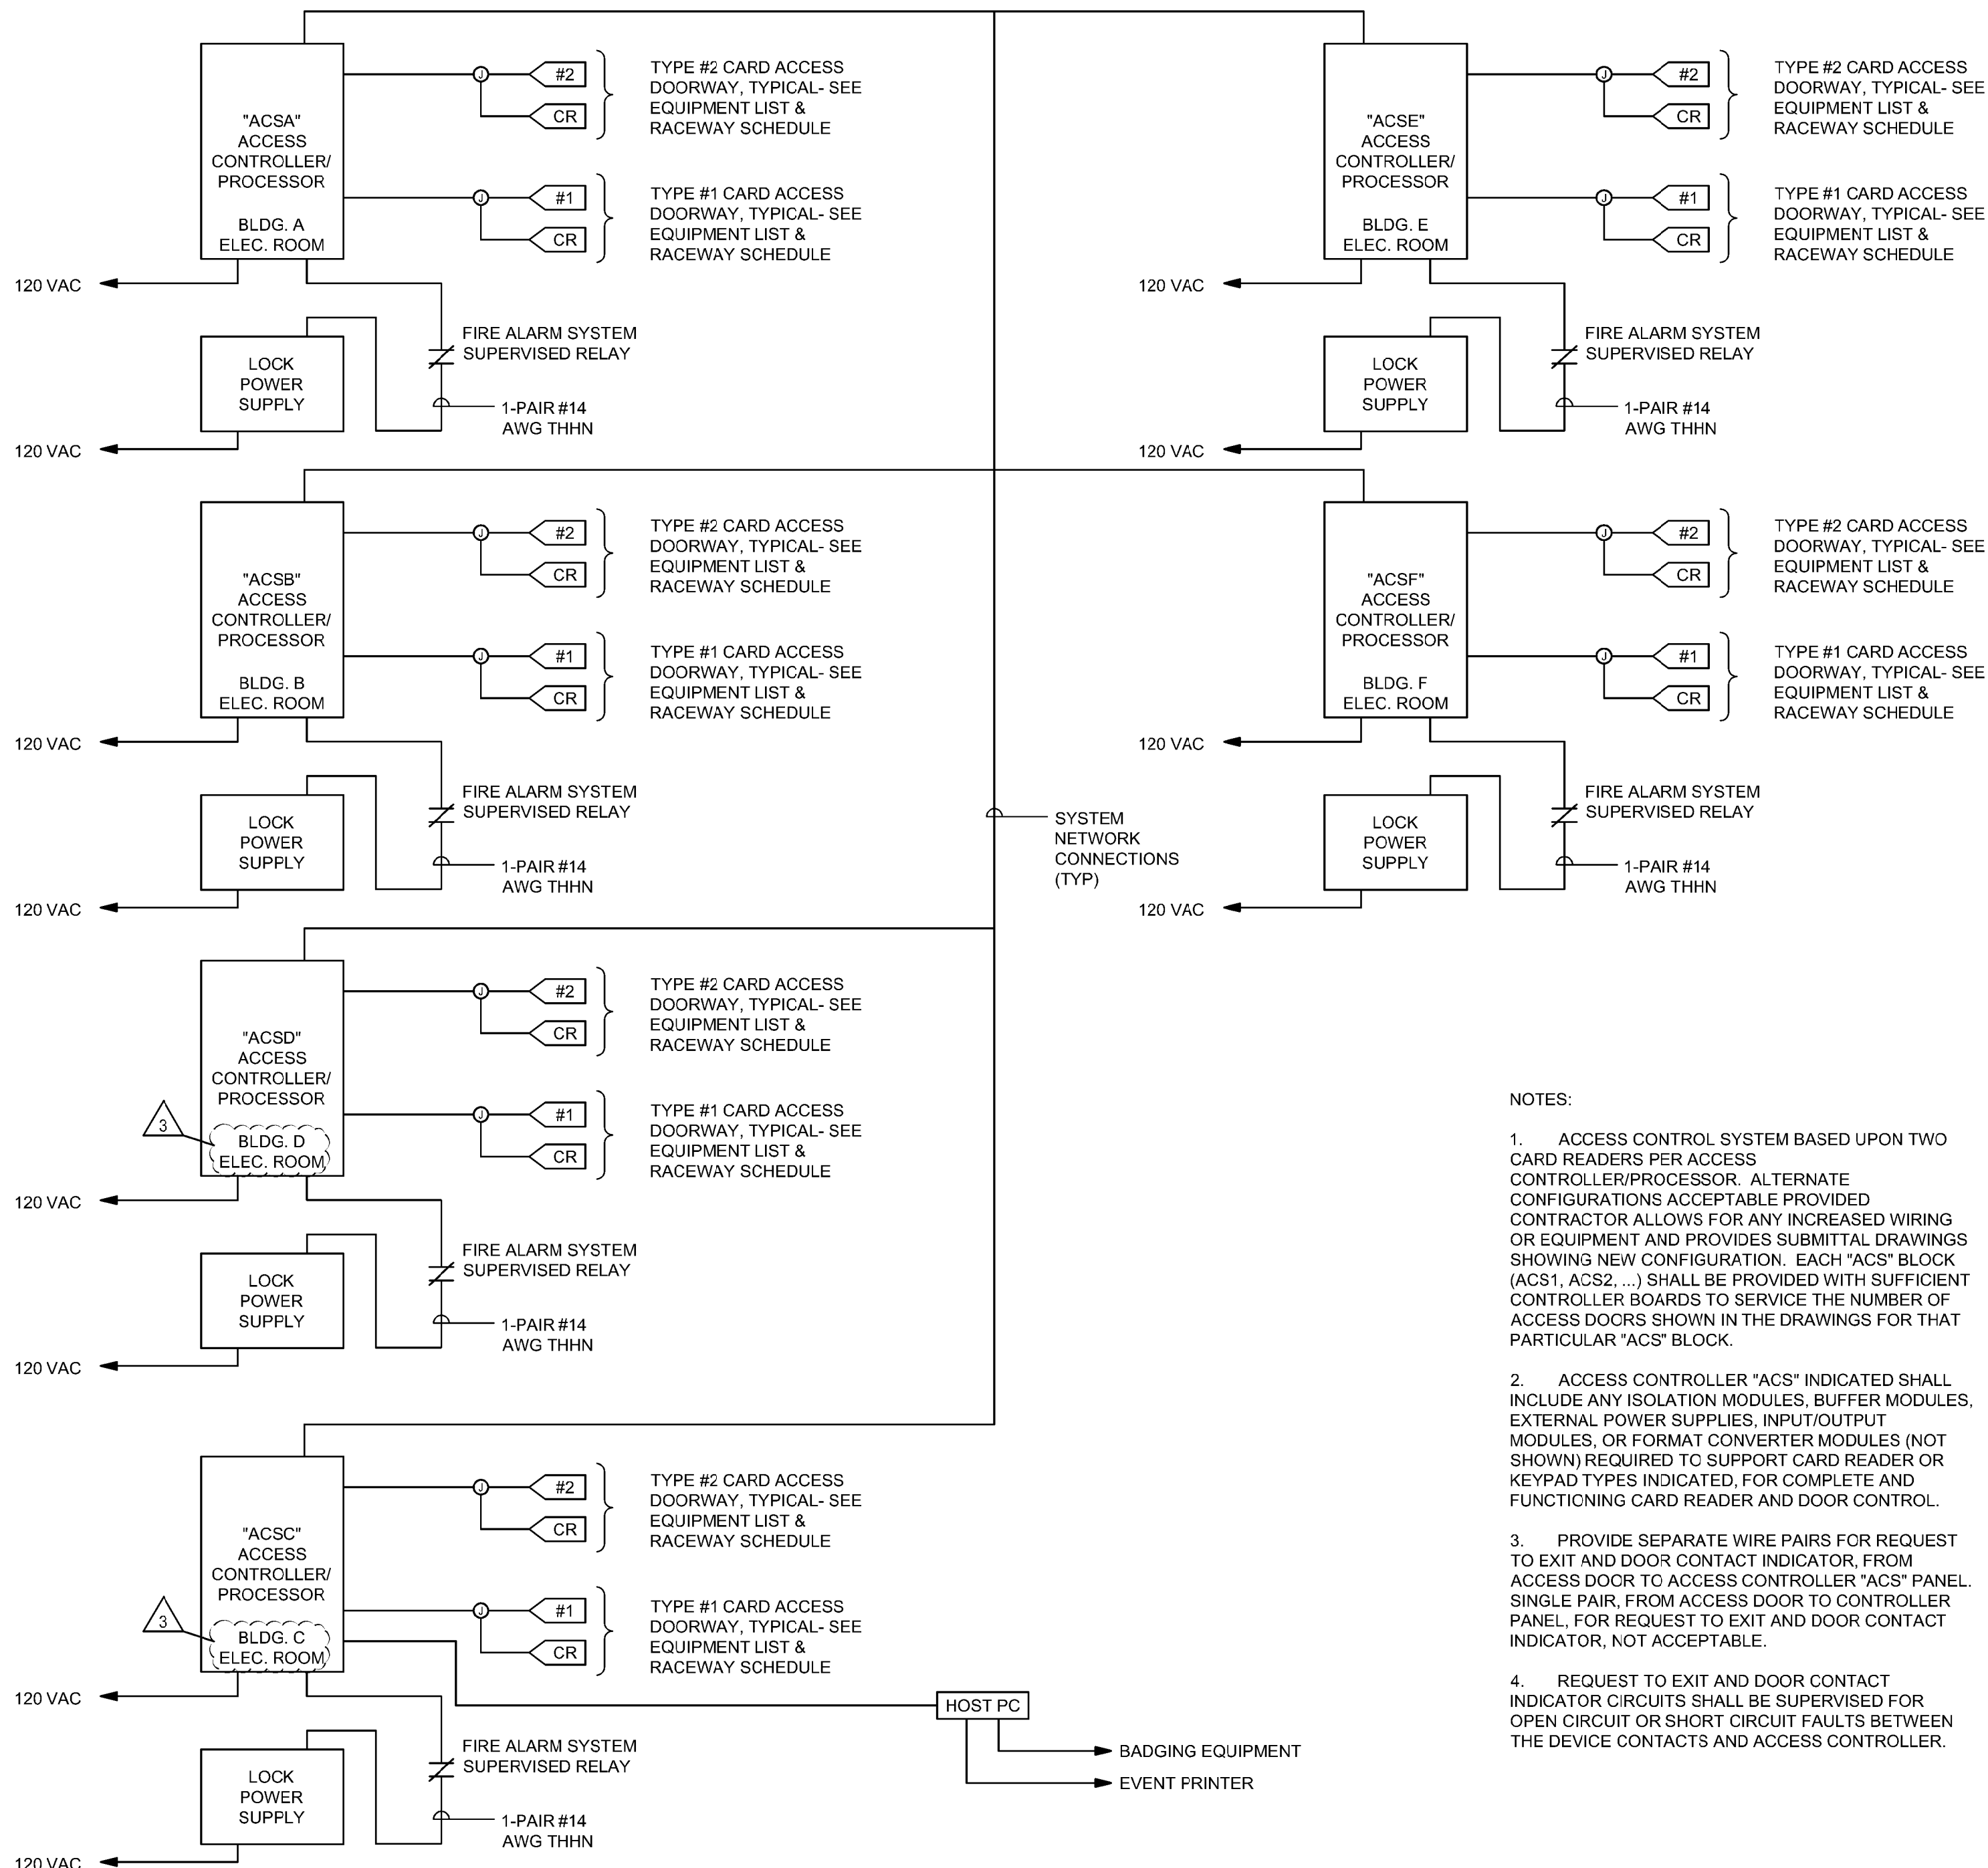


1 ACCESS CARD SYSTEM (ACS) RISER DIAGRAM  
1/8" = 1'-0"

Donald L. Welch  
Architect  
7533 Sandy Land Lane  
Midvale, Utah 84047  
801.348.6381  
dwelch5977@msn.com

THE DESIGNS SHOWN AND DESCRIBED HEREIN INCLUDING ALL TECHNICAL DRAWINGS, GRAPHIC REPRESENTATION & MODELS THEREOF, ARE PROPRIETARY & CAN NOT BE COPIED, DUPLICATED, OR COMMERCIALY EXPLOITED IN WHOLE OR IN PART WITHOUT THE SOLE AND EXPRESS WRITTEN PERMISSION FROM DONALD L. WELCH ARCHITECT

THESE DRAWINGS ARE AVAILABLE FOR LIMITED REVIEW AND EVALUATION BY CLIENTS CONSULTANTS, CONTRACTORS, GOVERNMENT AGENCIES, VENDORS, AND OFFICE PERSONNEL ONLY IN ACCORDANCE WITH THIS NOTICE.

consultant:

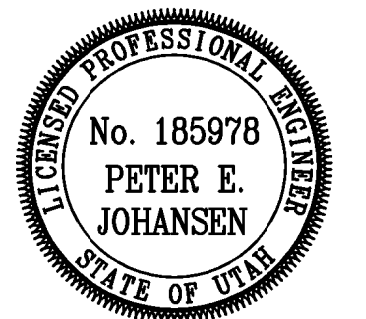

project:

Tenant Finish  
for New  
Brighton  
Recovery  
Campus  
4905, 4911, 4915, 4925,  
4931, & 4953 South 900  
East  
Salt Lake County, Utah

date

January 04, 2017

revisions

- PERMIT SET-December 28, 2016
- ADDENDUM #2-January 06, 2017
- ADDENDUM #3-January 11, 2017
- ADDENDUM #4-January 17, 2017
- ADDENDUM #5-January 19, 2017
- ADDENDUM #7-February 24, 2017
- ADDENDUM #8-March 20, 2017

data

project no:

drawn by:

checked by:

title

AUXILIARY RISER  
DIAGRAMS


sheet

EY601

VSS CAMERA/ENCLOSURE TYPE SCHEDULE			
CAMERA TYPE NUMBER	SYMBOL	DESCRIPTION	INCLUDES
TYPE 1		INTERIOR CAMERA - FIXED DOME (CEILING MOUNTED UNLESS J-BOX SHOWN)	* CAMERA/ENCLOSURE-FLUSH MOUNTED * CAT6 SIGNAL CABLE AS INDICATED TO HEADEND * POE  PROVIDE AVIGILON 1.0C-H4A-DC1 OR APPROVED EQUAL.
TYPE 2		INTERIOR CAMERA - FIXED DOME (WALL MOUNTED)	* CAMERA/ENCLOSURE-SURFACE MOUNTED * CAT6 SIGNAL CABLE AS INDICATED TO HEADEND (VSS) * POE * WALL MOUNT HARDWARE  PROVIDE AVIGILON 1.0C-H4A-D1 OR APPROVED EQUAL.
TYPE 3		EXTERIOR CAMERA - MULTI SENSOR (WALL PENDANT MOUNTED)	* CAMERA/ENCLOSURE-SURFACE MOUNTED * CAT6 SIGNAL CABLE AS INDICATED TO HEADEND (VSS) * POE * ENVIRONMENTAL ASSEMBLY * 180"  PROVIDE AVIGILON 9W-H3-3MH-DP1 OR APPROVED EQUAL. WALL MOUNT - AVIGILON MNT-PEND-WALL CORNER MOUNT - AVIGILON MNT-AD-CORNER
TYPE 4		EXTERIOR CAMERA - MULTI-SENSOR (CORNER PENDANT MOUNTED)	* CAMERA/ENCLOSURE-SURFACE MOUNTED * CAT6 SIGNAL CABLE AS INDICATED TO HEADEND (VSS) * POE * ENVIRONMENTAL ASSEMBLY * 270"  PROVIDE AVIGILON 9W-H3-3MH-DP1 OR APPROVED EQUAL. WALL MOUNT - AVIGILON MNT-PEND-WALL CORNER MOUNT - AVIGILON MNT-AD-CORNER
TYPE 5		INTERIOR CAMERA - MULTI-SENSOR (CEILING MOUNTED)	* CAMERA/ENCLOSURE-FLUSH MOUNTED * CAT6 SIGNAL CABLE AS INDICATED TO HEADEND (VSS) * POE * 180" - 270"  PROVIDE AVIGILON 9W-H3-3MH-DC1 OR APPROVED EQUAL.
TYPE 6		EXTERIOR CAMERA - FIXED BULLET (WALL MOUNTED)	* CAMERA/ENCLOSURE-SURFACE MOUNTED * CAT6 SIGNAL CABLE AS INDICATED TO HEADEND (VSS) * POE * ENVIRONMENTAL ASSEMBLY  PROVIDE AVIGILON 2.0C-H4A-B02-IR OR APPROVED EQUAL.

VIDEO SURVEILLANCE EQUIPMENT SCHEDULE		
SYMBOL	DESCRIPTION	ACCEPTABLE TYPES
	POE NETWORK SWITCH	NETGEAR
	NETWORK VIDEO RECORDER	SEE SPECIFICATION 282300
	VIDEO CAMERA	SEE VSS CAMERA SCHEDULE
CABLE	4 PAIR, CAT 6, UTP PLENUM	SEE SPECIFICATIONS

OFF = OBTAIN FROM PLANS; A/R = AS REQUIRED

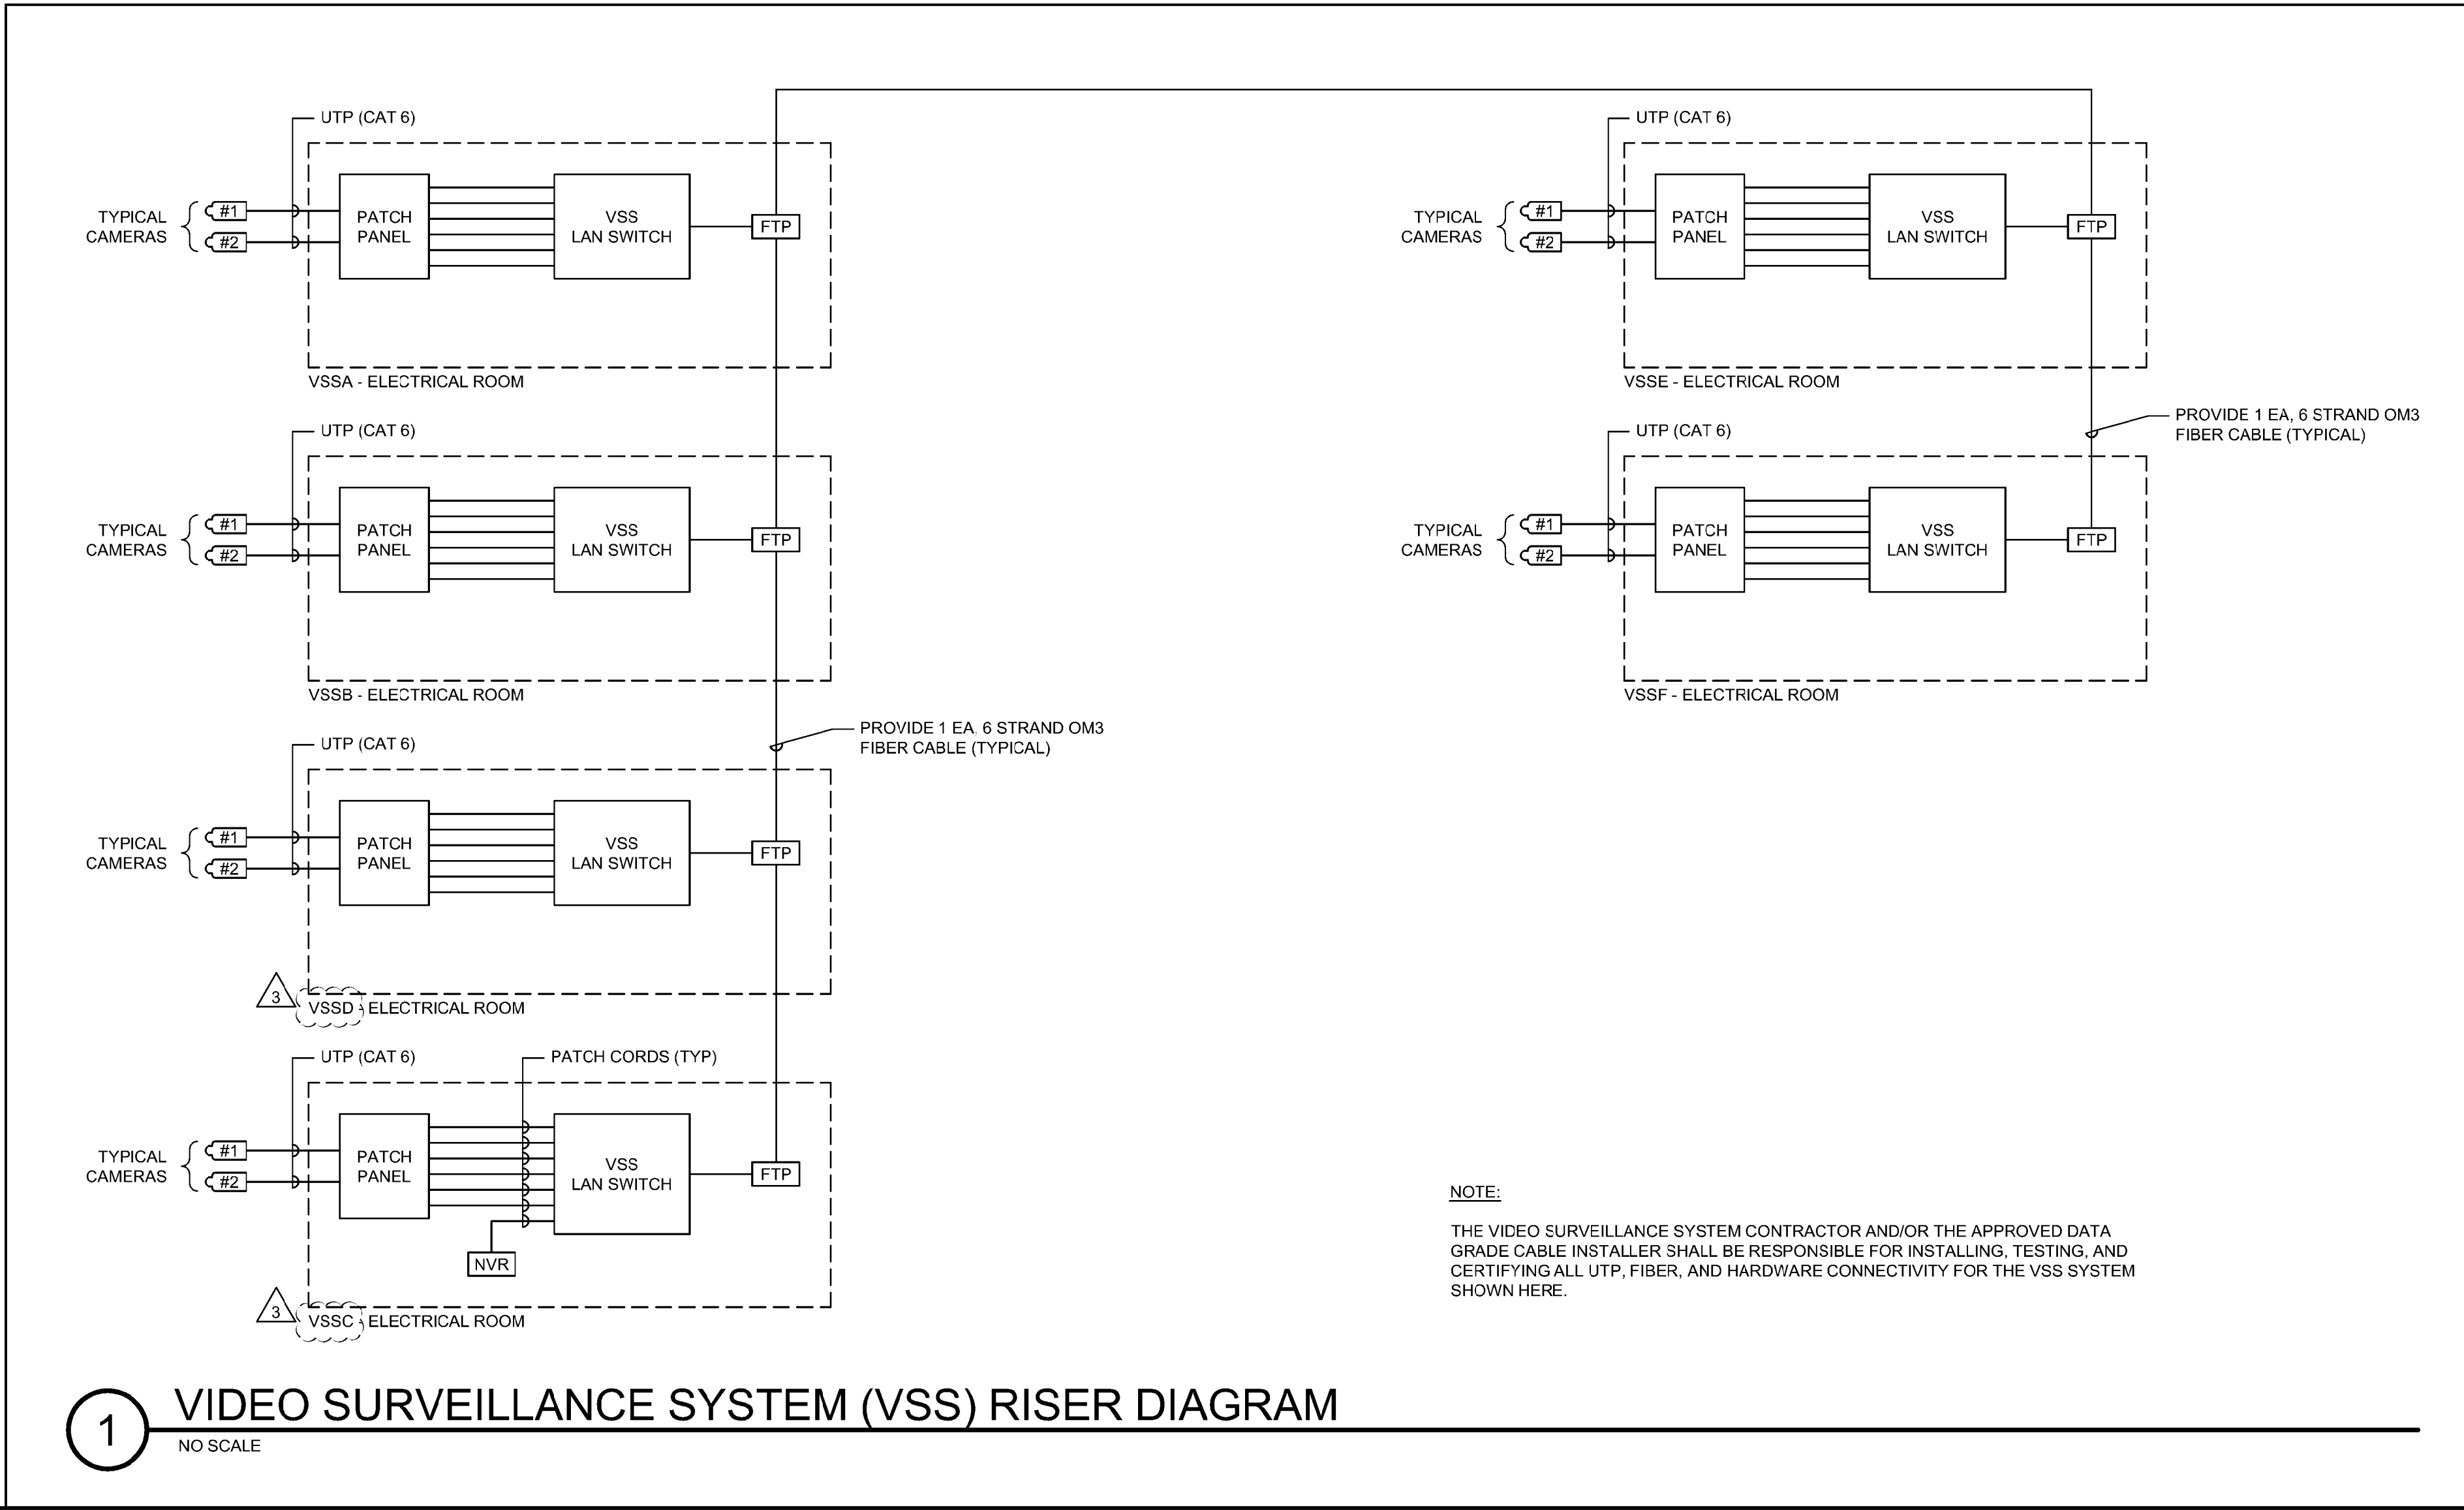

Donald L. Welch  
Architect  
7533 Sandy Land Lane  
Midvale, Utah 84047  
801.348.6391  
dwelch5977@msn.com

THE DESIGNS SHOWN AND DESCRIBED HEREIN INCLUDING ALL TECHNICAL DRAWINGS, GRAPHIC REPRESENTATION & MODELS THEREOF, ARE PROPRIETARY & CAN NOT BE COPIED, DUPLICATED, OR COMMERCIALY EXPLOITED IN WHOLE OR IN PART WITHOUT THE SOLE AND EXPRESS WRITTEN PERMISSION FROM DONALD L. WELCH ARCHITECT

THESE DRAWINGS ARE AVAILABLE FOR LIMITED REVIEW AND EVALUATION BY CLIENTS CONSULTANTS, CONTRACTORS, GOVERNMENT AGENCIES, VENDORS, AND OFFICE PERSONNEL ONLY IN ACCORDANCE WITH THIS NOTICE.

consultant:

project:

**Tenant Finish  
for New  
Brighton  
Recovery  
Campus**  
4905, 4911, 4915, 4925,  
4931, & 4953 South 900  
East  
Salt Lake County, Utah

date  
January 04, 2017

revisions

PERMIT SET-December 28, 2016  
ADDENDUM #2-January 06, 2017  
ADDENDUM #3-January 11, 2017  
ADDENDUM #4-January 17, 2017  
ADDENDUM #5-January 19, 2017  
ADDENDUM #7-February 24, 2017  
ADDENDUM #8-March 20, 2017

data

project no:  
drawn by:  
checked by:

**title**  
AUXILIARY RISER  
DIAGRAMS

sheet

BUILDING 'F' 4953 South 900 East PARCEL #22081850130000




File Name: P:\2016\20160686\Drawings\3Sheet\Building\_F\86'EY603F.dwg Last Plotted: 2017/03/21 @ 8:57 AM By: jrw

5

MAIN NETWORK ROOM SINGLE LINE DIAGRAM W/UTILITY DEMARC INFORMATION

NTS

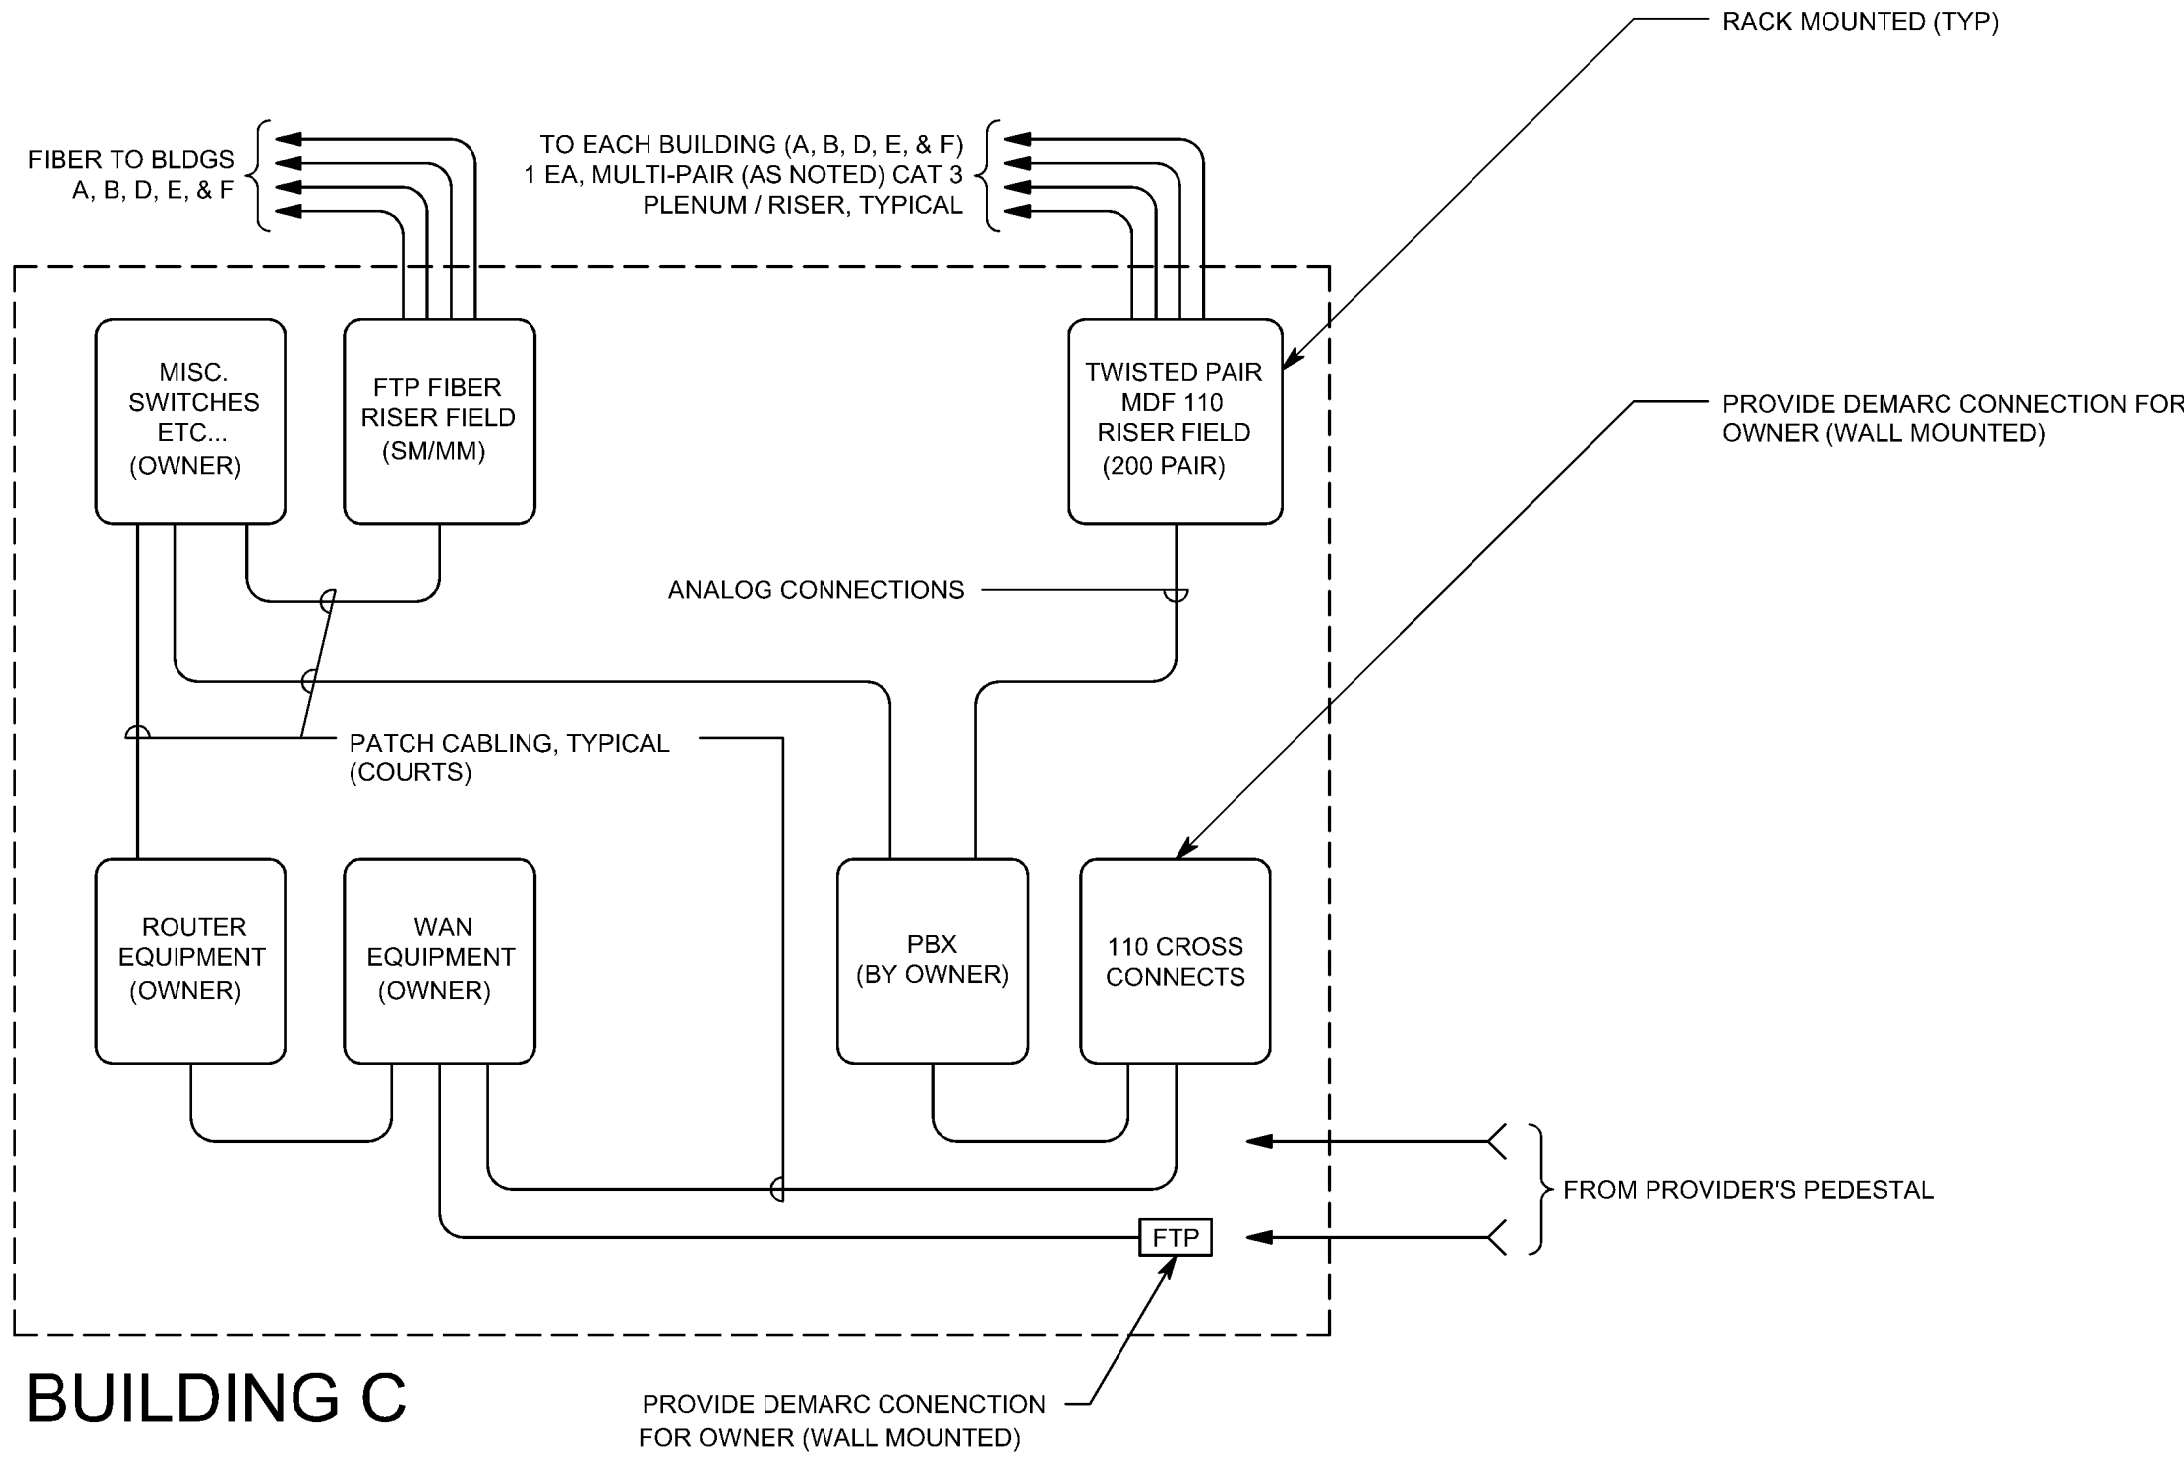


BUILDING C

4

DATA PLATE DETAIL (TYP)


NO SCALE

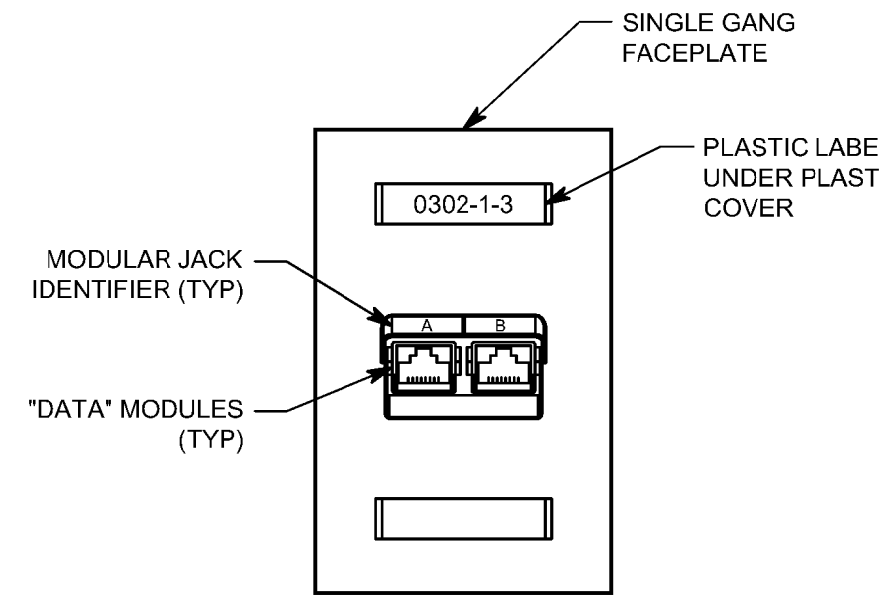

3

VOICE-DATA GROUNDING AND CONDUIT RISER DIAGRAM


NTS

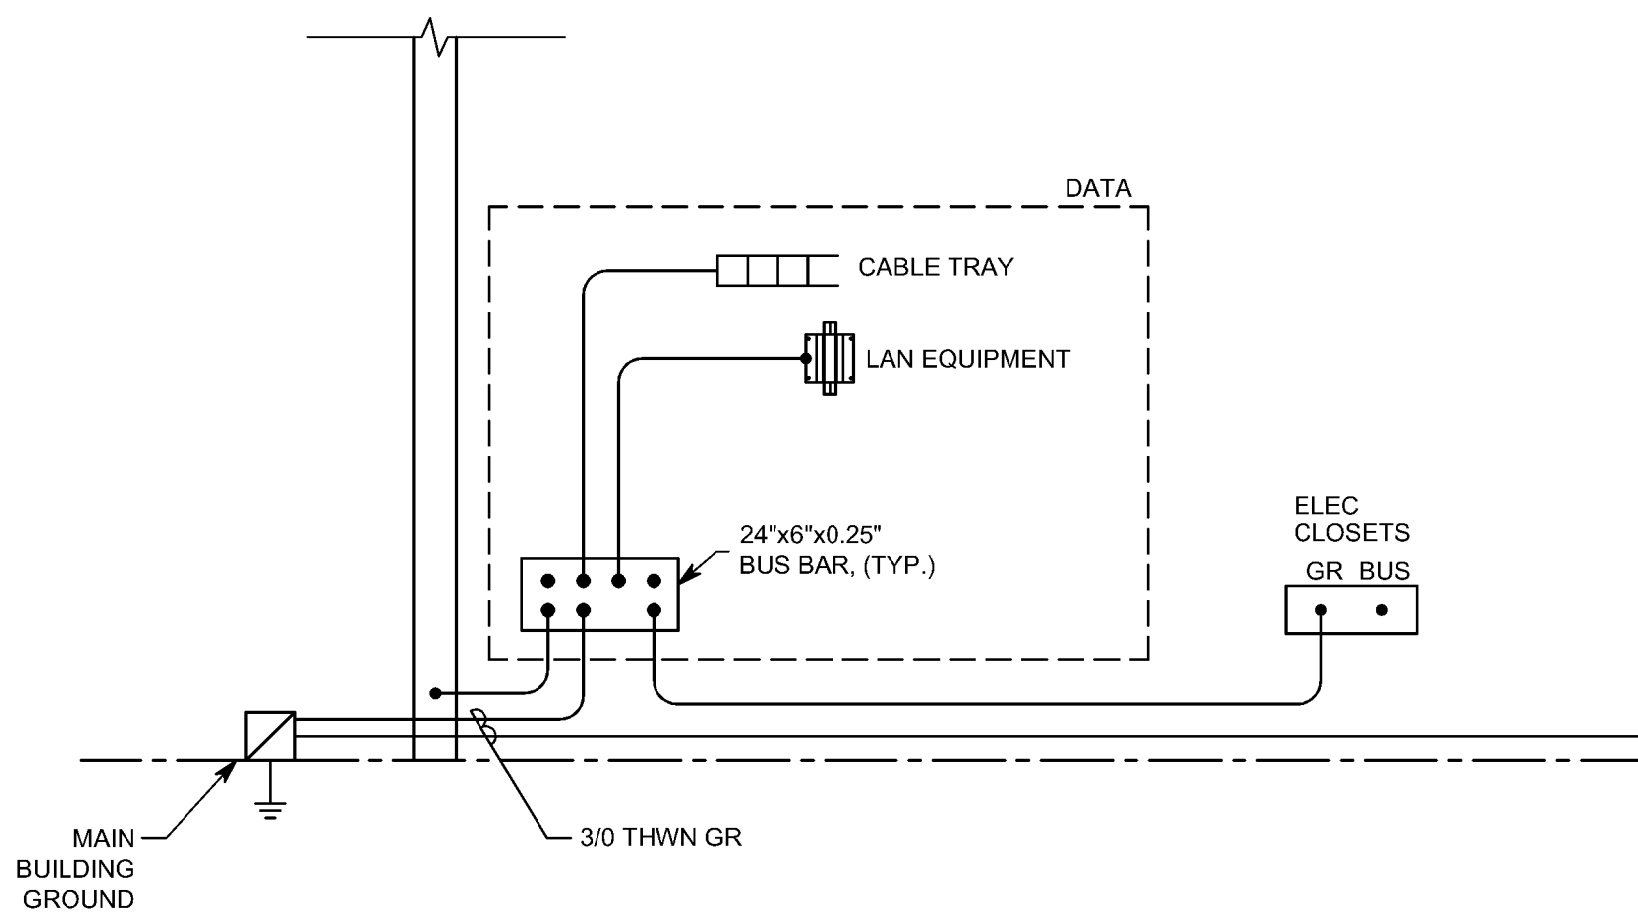

2

HORIZONTAL TERMINATION RACK ELEVATION - BUILDING C

NTS

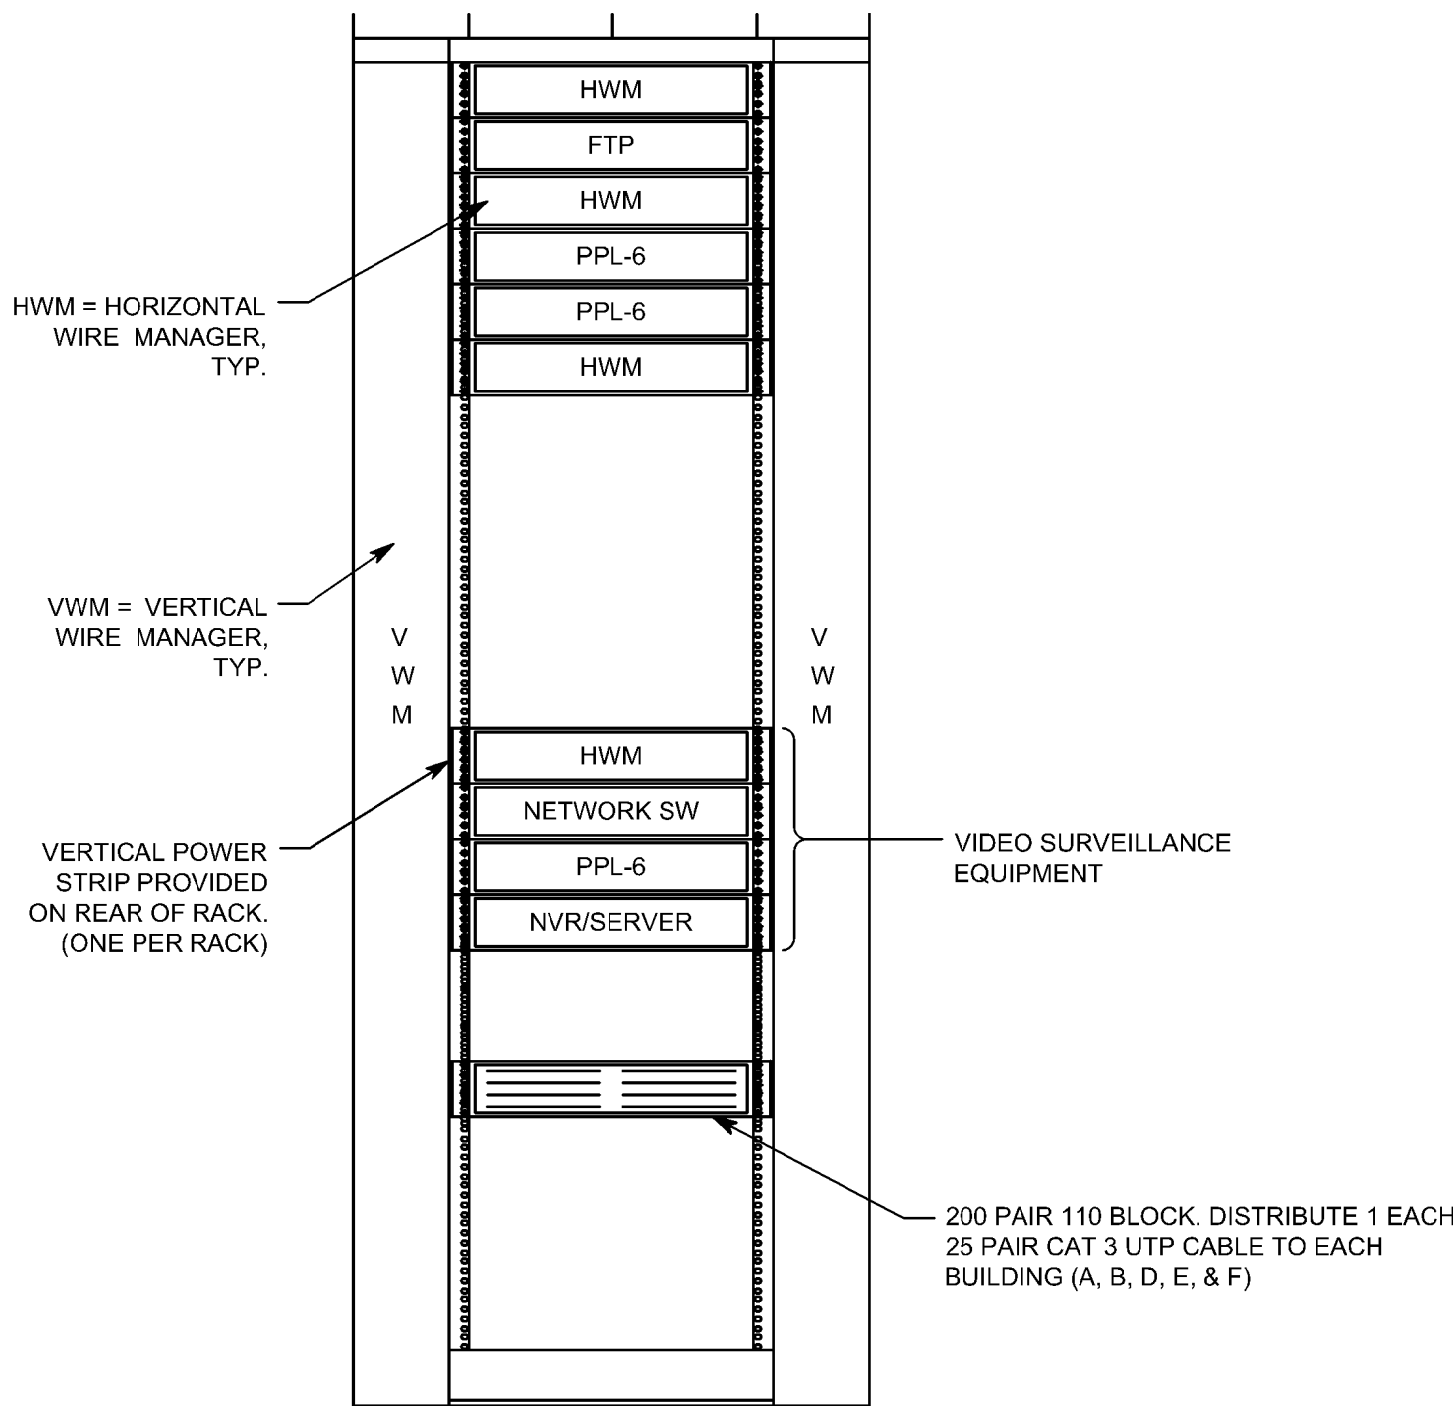


NOTES:

- RACK LAYOUTS ARE FOR COORDINATION PURPOSES. ALL FINAL RACK LAYOUTS ARE TO BE COORDINATED WITH OWNER PERSONNEL.
- PROVIDE ALL WIRE MANAGEMENT ACCESSORIES SHOWN.

1

OPEN FRAME EQUIPMENT RACK/RACEWAY MOUNTING DETAILS

NO SCALE

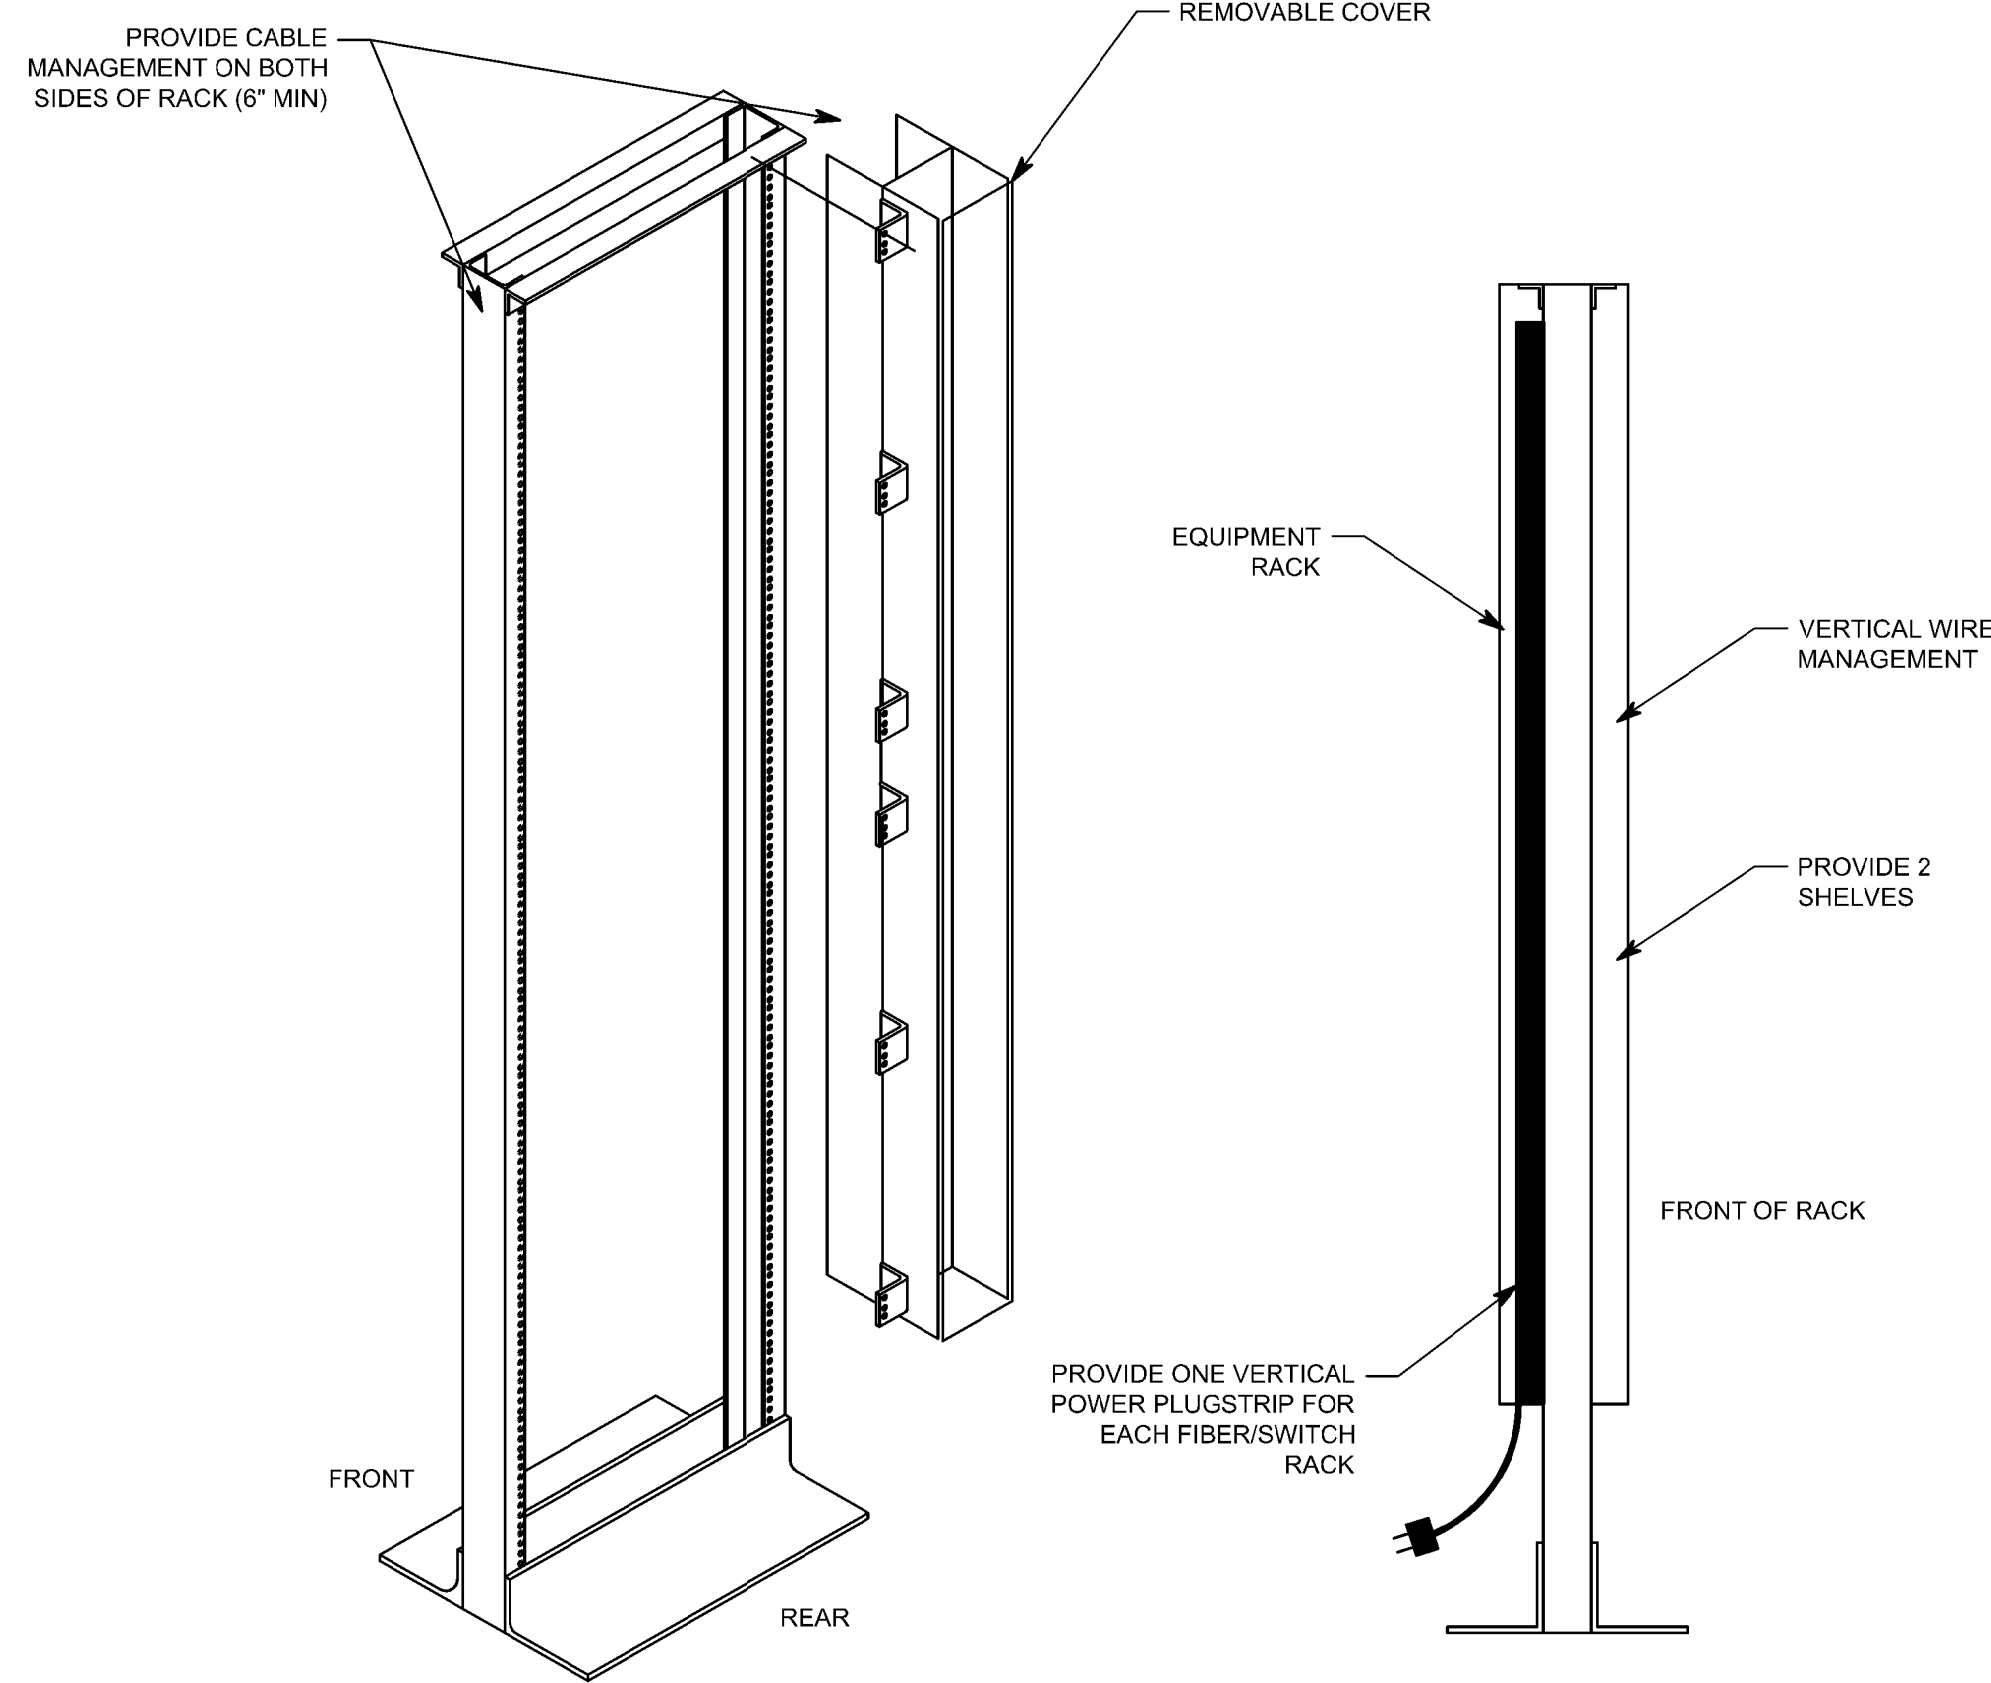

VOICE/DATA EQUIPMENT/CABLE LIST

GENERAL NOTE:  
THIS REPRESENTS ITEMS OF SIGNIFICANCE USED DURING THE DESIGN OF THE CABLING INSTALLATION, WHILE THE ITEMS INDICATED BELOW SHALL NOT BE CONSTRUED AS A "BILL OF MATERIALS". FURNISH ALL MISCELLANEOUS HARDWARE AND SUPPORTS WHICH MAY NOT BE LISTED HERE FOR A COMPLETE INSTALLATION. COMPARE CATALOG NUMBERS WITH DESCRIPTION AND PRIOR TO PURCHASING ANY EQUIPMENT OR CABLE. REFER TO SECTION 16741 FOR ADDITIONAL INFORMATION. NOTIFY ENGINEER OF DISCREPANCIES PRIOR TO BID AND PROVIDE COMPLETE SUBMITTAL FOR APPROVAL.

SYMBOL	ITEM DESCRIPTION	COMMENTS
	4 PAIR 24 GAUGE CAT 6 UTP, PLENUM CABLE	SEE SPECIFICATIONS
	6 STRAND FIBER PLENUM CABLE, MULTI-MODE (OM3)	SEE SPECIFICATIONS
PPL6-48	48-PORT PATCH PANEL WITH CAT 6 RJ45 JACKS; MOUNTED IN RACK.	PROVIDE FOR QUANTITY OF PORTS SHOWN ON DRAWINGS, PLUS 20%
FTP	SC TYPE CONNECTOR PANEL - PORTS AS REQUIRED	PROVIDE MODULAR TYPE WITH ADAPTOR PLATES.
	DATA RACK, FLOOR MOUNTED	OPEN RACK, STANDARD 19", PROVIDE RACKS AS SHOWN IN ROOM LAYOUT DETAILS. SEE SPECIFICATIONS.
WAP	DATA JACK, 2 CAT 6 CABLES EACH	PROVIDE WITH CAT 6 COMPLIANT RJ45 MODULAR CONNECTORS. SEE DETAIL.
PATCH CORDS	PATCH CORDS, CAT 6	PROVIDE 1 EACH FOR EVERY CABLE TERMINATED FROM HORIZONTAL CABLING OUTLETS.
	110 STYLE PUNCHDOWN BLOCKS (DUAL SIDED - 1 SIDE STATION, 1 SIDE RISER)	PROVIDE QUANTITY OF PAIRS NEEDED, A 100 PAIR CABLE WOULD NEED 100 PAIR FOR EACH SIDE OF THE BLOCK


NIC = NOT IN CONTRACT

Donald L. Welch  
Architect  
7533 Sandy Land Lane  
Midvale, Utah 84047  
801.348.6381  
dwlch5977@msn.com

THE DESIGNS SHOWN AND DESCRIBED HEREIN INCLUDING ALL TECHNICAL DRAWINGS, GRAPHIC REPRESENTATION & MODELS THEREOF, ARE PROPRIETARY & CAN NOT BE COPIED, DUPLICATED, OR COMMERCIALY EXPLOITED IN WHOLE OR IN PART WITHOUT THE SOLE AND EXPRESS WRITTEN PERMISSION FROM DONALD L. WELCH ARCHITECT

THESE DRAWINGS ARE AVAILABLE FOR LIMITED REVIEW AND EVALUATION BY CLIENTS CONSULTANTS, CONTRACTORS, GOVERNMENT AGENCIES, VENDORS, AND OFFICE PERSONNEL ONLY IN ACCORDANCE WITH THIS NOTICE.

consultant:

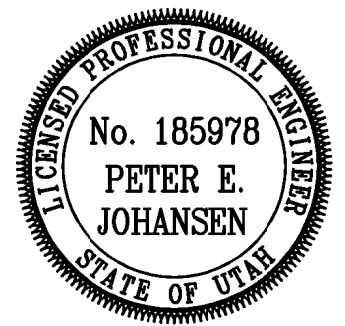

project:

Tenant Finish  
for New  
Brighton  
Recovery  
Campus  
4905, 4911, 4915, 4925,  
4931, & 4953 South 900  
East  
Salt Lake County, Utah

date

January 04, 2017

revisions

- PERMIT SET-December 28, 2016
- ADDENDUM #2-January 06, 2017
- ADDENDUM #3-January 11, 2017
- ADDENDUM #4-January 17, 2017
- ADDENDUM #5-January 19, 2017
- ADDENDUM #7-February 24, 2017
- ADDENDUM #8-March 20, 2017

data

project no:

drawn by:

checked by:

title

AUXILIARY RISER  
DIAGRAMS


sheet

EY603

File Name: P:\2016\20160686\Drawings\3Sheet\Building F\86FA11F.dwg Last Plotted: 2017/03/21 @ 8:57 AM By: jrw

1 FIRE ALARM PLAN - BUILDING 'F'

SCALE: 1/4"=1'-0"

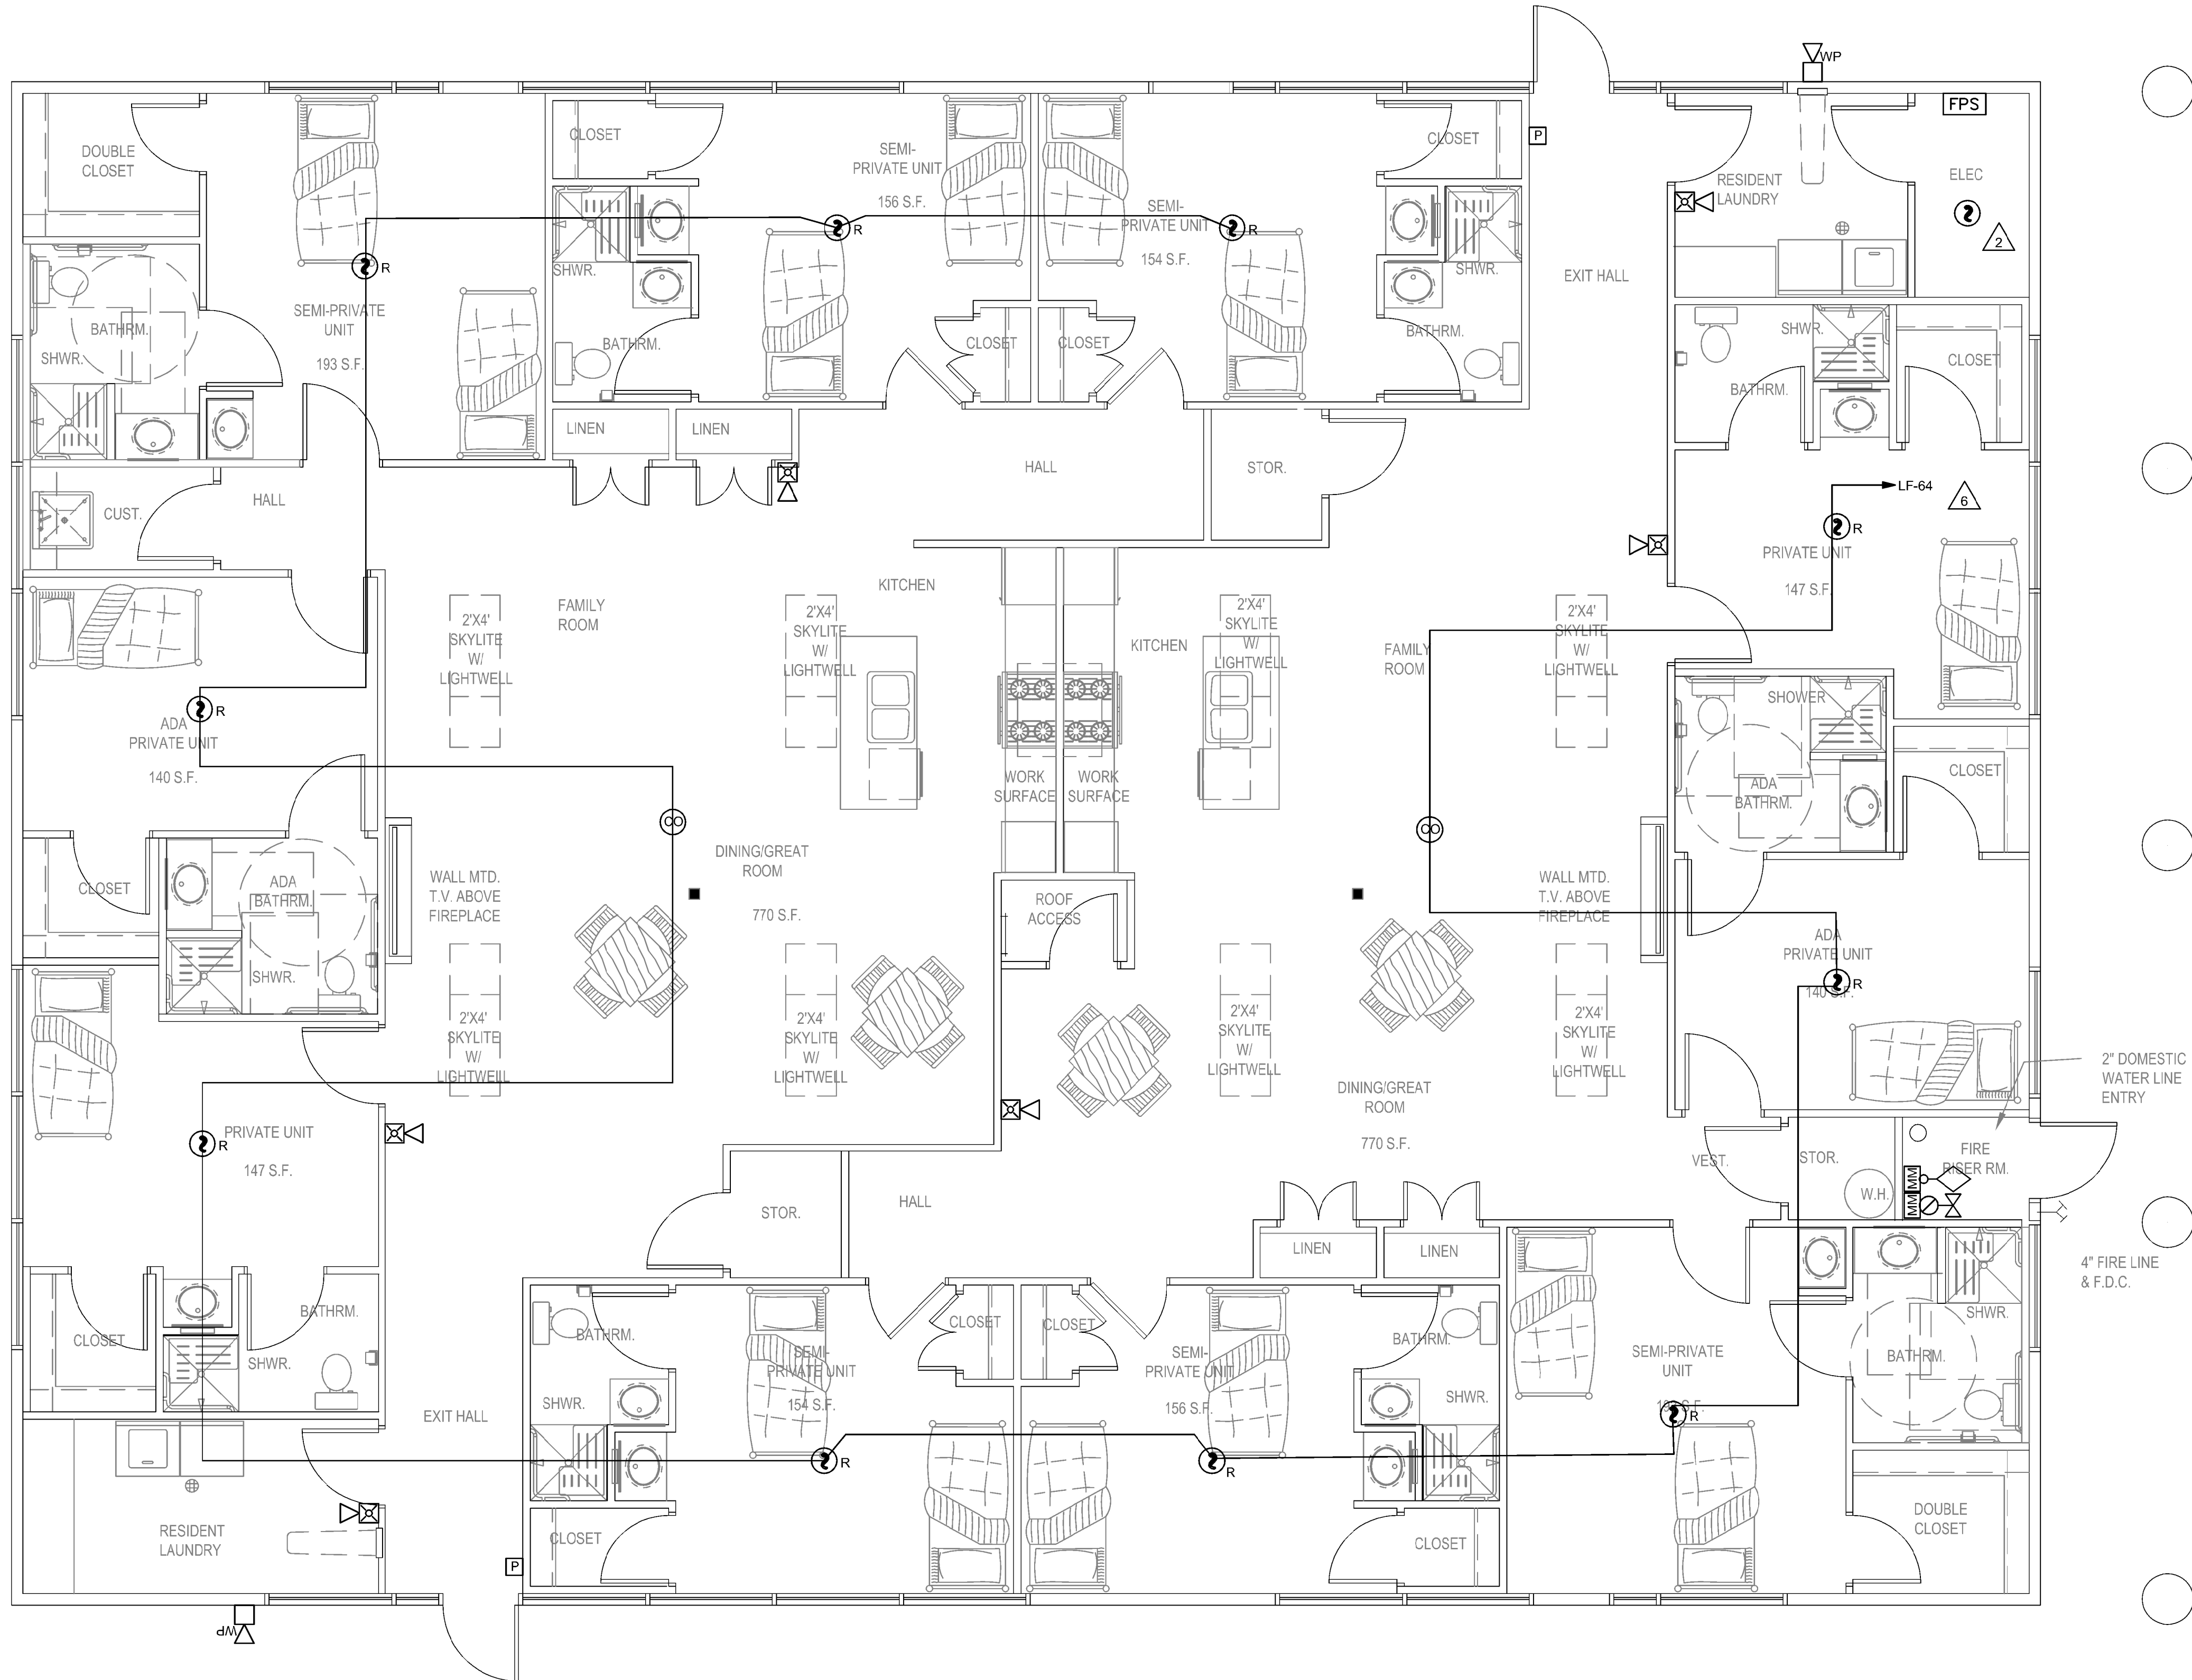

GENERAL SHEET NOTES

- ALL RESIDENTIAL SMOKE DETECTORS AND CARBON MONOXIDE DETECTORS WILL BE INTERCONNECTED, WILL BE CONNECTED TO 120V BUILDING CIRCUIT AND HAVE BATTERY BACKUP. WHEN ONE SMOKE DETECTOR IS ACTIVATED ALL SMOKE DETECTOR ALARMS SHALL SOUND.

SHEET KEYNOTES

- 

BUILDING 'F' 4953 South 900 East PARCEL #22081850130000

Donald L. Welch  
Architect  
7533 Sandy Land Lane  
Midvale, Utah 84047  
801.346-6381  
dwelch5977@msn.com

THE DESIGNS SHOWN AND DESCRIBED HEREIN INCLUDING ALL TECHNICAL DRAWINGS, GRAPHIC REPRESENTATION & MODELS THEREOF, ARE PROPRIETARY & CAN NOT BE COPIED, DUPLICATED, OR COMMERCIALY EXPLOITED IN WHOLE OR IN PART WITHOUT THE SOLE AND EXPRESS WRITTEN PERMISSION FROM DONALD L. WELCH ARCHITECT

THESE DRAWINGS ARE AVAILABLE FOR LIMITED REVIEW AND EVALUATION BY CLIENTS CONSULTANTS, CONTRACTORS, GOVERNMENT AGENCIES, VENDORS, AND OFFICE PERSONNEL ONLY IN ACCORDANCE WITH THIS NOTICE.

consultant:



project:

**Tenant Finish  
for New  
Brighton  
Recovery  
Campus**  
4905, 4911, 4915, 4925,  
4931, & 4953 South 900  
East  
Salt Lake County, Utah

date

January 04, 2017

revisions

- PERMIT SET-December 28, 2016
- ADDENDUM #2-January 06, 2017
- ADDENDUM #3-January 11, 2017
- ADDENDUM #4-January 17, 2017
- ADDENDUM #5-January 19, 2017
- ADDENDUM #7-February 24, 2017
- ADDENDUM #8-March 20, 2017

data

project no:

drawn by:

checked by:

title


**FIRE ALARM PLAN  
- BUILDING 'F'**

sheet

FA11F

WIRING SCHEDULE				
FUNCTION	< 500'	< 1000'	1000'-3000'	> 3000'
ADDRESSABLE LOOP	#18 TSP	#18 TSP	#16 TSP	#14 TSP
POWER LOOP	#14 THWN	#14 THWN	#12 THWN	#10 THWN
SPARE LOOP	#14 THWN	#14 THWN	#12 THWN	#10 THWN
STROBE HORNS	#14 THWN	#14 THWN	#12 THWN	#10 THWN
MAGNETIC DOOR HOLDER	#12 THWN	#10 THWN		
SPEAKERS	#16 TSP	#16 TSP	#14 TSP	#14 TSP

FIRE ALARM INPUT/OUTPUT MATRIX		OUTPUT DEVICES										NOTES
		GENERAL ALARM BLDG 'A'	GENERAL ALARM BLDG 'B'	GENERAL ALARM BLDG 'C'	GENERAL ALARM BLDG 'D'	GENERAL ALARM BLDG 'E'	GENERAL ALARM BLDG 'F'	TROUBLE ALARM	SUPERVISORY ALARM	FAN SHUTDOWN	FIRE DAMPER	
INITIATING DEVICES	1	RISER BLDG 'A' FLOW	●						●			
	2	RISER BLDG 'A' TAMPER		●						●		
	3	RISER BLDG 'B' FLOW							●			
	4	RISER BLDG 'B' TAMPER		●						●		
	5	RISER BLDG 'C' FLOW			●				●	●		
	6	RISER BLDG 'C' TAMPER								●		
	7	RISER BLDG 'D' FLOW				●			●	●		
	8	RISER BLDG 'D' TAMPER								●		
	9	RISER BLDG 'E' FLOW				●			●	●		
	10	RISER BLDG 'E' TAMPER								●		
	11	RISER BLDG 'F' FLOW					●		●	●		
	12	RISER BLDG 'F' TAMPER								●		
	13	BLDG 'A' INITIATING LOOP	●						●	●		
	14	BLDG 'B' INITIATING LOOP		●					●	●		
	15	BLDG 'C' INITIATING LOOP			●				●	●		
	16	BLDG 'D' INITIATING LOOP				●			●	●		
	17	BLDG 'E' INITIATING LOOP					●		●	●		
	18	BLDG 'F' INITIATING LOOP						●	●	●		
19	CIRCUIT TROUBLE								●			
20	AC POWER LOSS								●			
21	LOW BATTERY POWER								●			
22	SYSTEM TROUBLE								●			
23	REMOTE POWER SUPPLY TROUBLE								●			

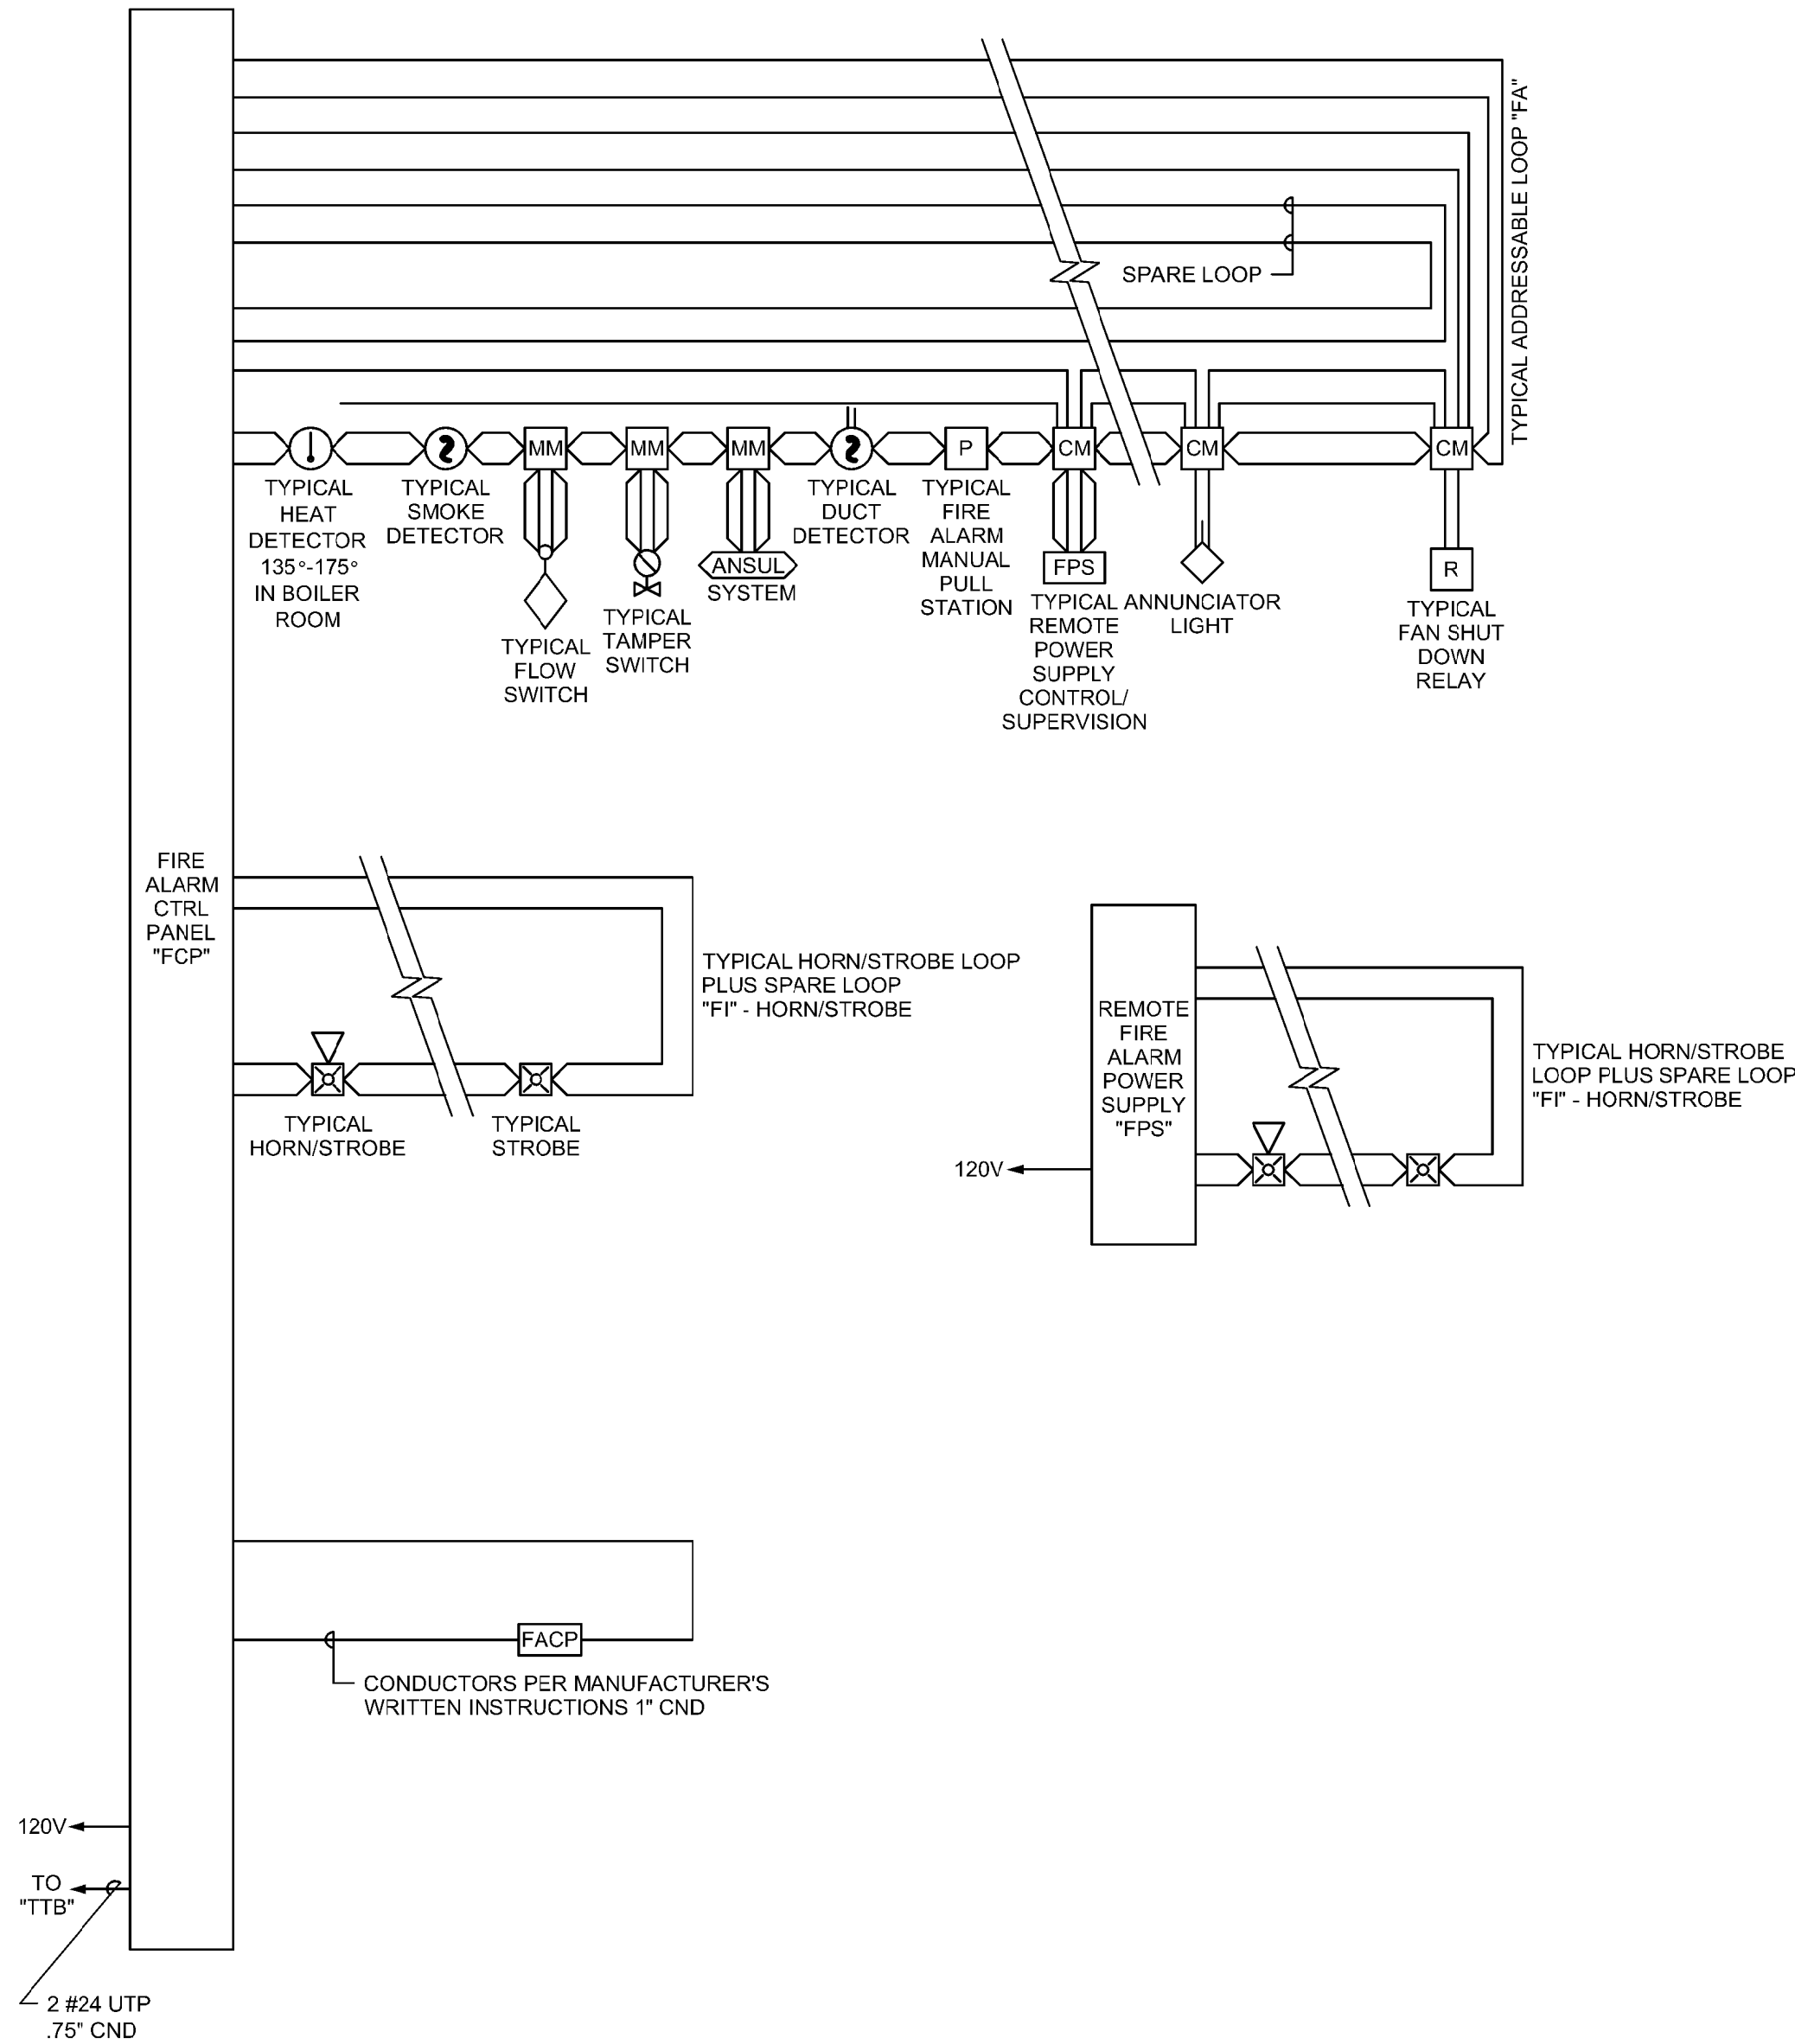

1 FIRE ALARM RISER  
NO SCALE

## GENERAL SHEET NOTES


- PLANS ARE BASED UPON 99 MONITOR AND CONTROL DEVICES PER ADDRESSABLE LOOP. OTHER CONFIGURATIONS ARE ACCEPTABLE SUBJECT TO CONTRACTOR ALLOWING FOR INCREASED WIRING REQUIREMENTS AND SUBMITTAL DRAWINGS SHOWING NEW WIRING CONFIGURATION. MAXIMUM INITIAL DEVICES PER LOOP SHALL NOT EXCEED 75% MAXIMUM ALLOWABLE.
- PLANS ARE BASED UPON THE WIRING SCHEDULE SHOWN. WHERE MANUFACTURER'S REQUIREMENTS EXCEED REQUIREMENTS SHOWN, INCLUDE ADDITIONAL ASSOCIATED COSTS AND SUBMITTAL DRAWINGS INDICATING NEW WIRING CONFIGURATION.
- FLOW AND TAMPER CONFIGURATION BASED UPON FIRE SPRINKLER DESIGN CONCEPT. FIELD VERIFY ACTUAL REQUIREMENTS. INCLUDE ANY ADDITIONAL MONITOR MODULES REQUIRED BY ACTUAL DESIGN REQUIREMENTS.
- BATTERY CAPACITY TO BE ADEQUATE TO OPERATE 15 MINUTES AFTER 24 HOURS PLUS 25% SPARE CAPACITY.
- VFD REQUIRES TWO RELAYS, ONE FOR SMOKE CONTROL, ONE SPARE.
- RUN SPARE LOOPS IN SAME CONDUIT. DO NOT EXCEED 40% AREA FILL OF CONDUITS.
- PROVIDE DUCT DETECTORS FOR SUPPLY AND RETURN AIR SYSTEMS OVER 2000 CFM. INSTALL DUCT DETECTORS PER NFPA 72 REQUIREMENTS AND PROVIDE ADDITIONAL DUCT ARRANGEMENT.
- PROVIDE MANUAL PULL STATIONS IN BOILER ROOMS AND KITCHENS.
- PROVIDE ONE YEAR OFF SITE MONITORING INCLUDING ALL INTERFACE DEVICES AND MONITORING CHARGES. COORDINATE WITH BUILDING OWNER'S OFF SITE MONITORING COMPANY.
- LOCATE SMOKE DETECTORS MINIMUM 3' FROM AIR SUPPLY AND RETURN LOUVERS.
- PROVIDE SYNCHRONIZED STROBES THROUGHOUT FACILITY. PROVIDE SYNCHRONIZATION MODULES PER MANUFACTURER'S REQUIREMENTS. INCLUDE ADDITIONAL WIRING, IF REQUIRED.
- INITIATING AND INDICATING LOOPS SHALL NOT SERVE AN AREA OF GREATER THAN 22,500 SQUARE FEET. PROVIDE ADDITIONAL LOOPS FOR AREAS LARGER THAN THIS.
- ALL OUTPUT DEVICES ARE DESIGNED ON SYSTEMS WITH 2 AMP POWER SUPPLY.
- HORN/STROBE BASED ON 120 MILLIAMPS. DOOR HOLDERS BASED ON 70 MILLIAMPS.
- INSTALL DUCT DETECTORS PER NFPA 72 REQUIREMENTS AND PROVIDE ADDITIONAL DUCT DETECTORS DEPENDING UPON FINAL DUCT ARRANGEMENT.

Donald L. Welch  
Architect  
7533 Sandy Land Lane  
Midvale, Utah 84047  
801.348.6381  
dwelch5977@nash.com

THE DESIGNS SHOWN AND DESCRIBED HEREIN INCLUDING ALL TECHNICAL DRAWINGS, GRAPHIC REPRESENTATION & MODELS THEREOF, ARE PROPRIETARY & CAN NOT BE COPIED, DUPLICATED, OR COMMERCIALY EXPLOITED IN WHOLE OR IN PART WITHOUT THE SOLE AND EXPRESS WRITTEN PERMISSION FROM DONALD L. WELCH ARCHITECT

THESE DRAWINGS ARE AVAILABLE FOR LIMITED REVIEW AND EVALUATION BY CLIENTS, CONSULTANTS, CONTRACTORS, GOVERNMENT AGENCIES, VENDORS, AND OFFICE PERSONNEL ONLY IN ACCORDANCE WITH THIS NOTICE.

consultant:

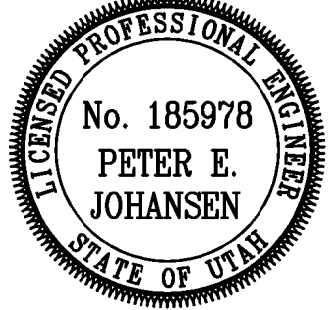

project:

Tenant Finish  
for New  
Brighton  
Recovery  
Campus  
4905, 4911, 4915, 4925,  
4931, & 4953 South 900  
East  
Salt Lake County, Utah

date

January 04, 2017

revisions

- PERMIT SET--December 28, 2016
- ADDENDUM #2--January 06, 2017
- ADDENDUM #3--January 11, 2017
- ADDENDUM #4--January 17, 2017
- ADDENDUM #5--January 19, 2017
- ADDENDUM #7--February 24, 2017
- ADDENDUM #8--March 20, 2017

data

project no:

drawn by:

checked by:

title

FIRE ALARM  
RISER DIAGRAM

sheet

